


SEYMOUR STREET 49.5'

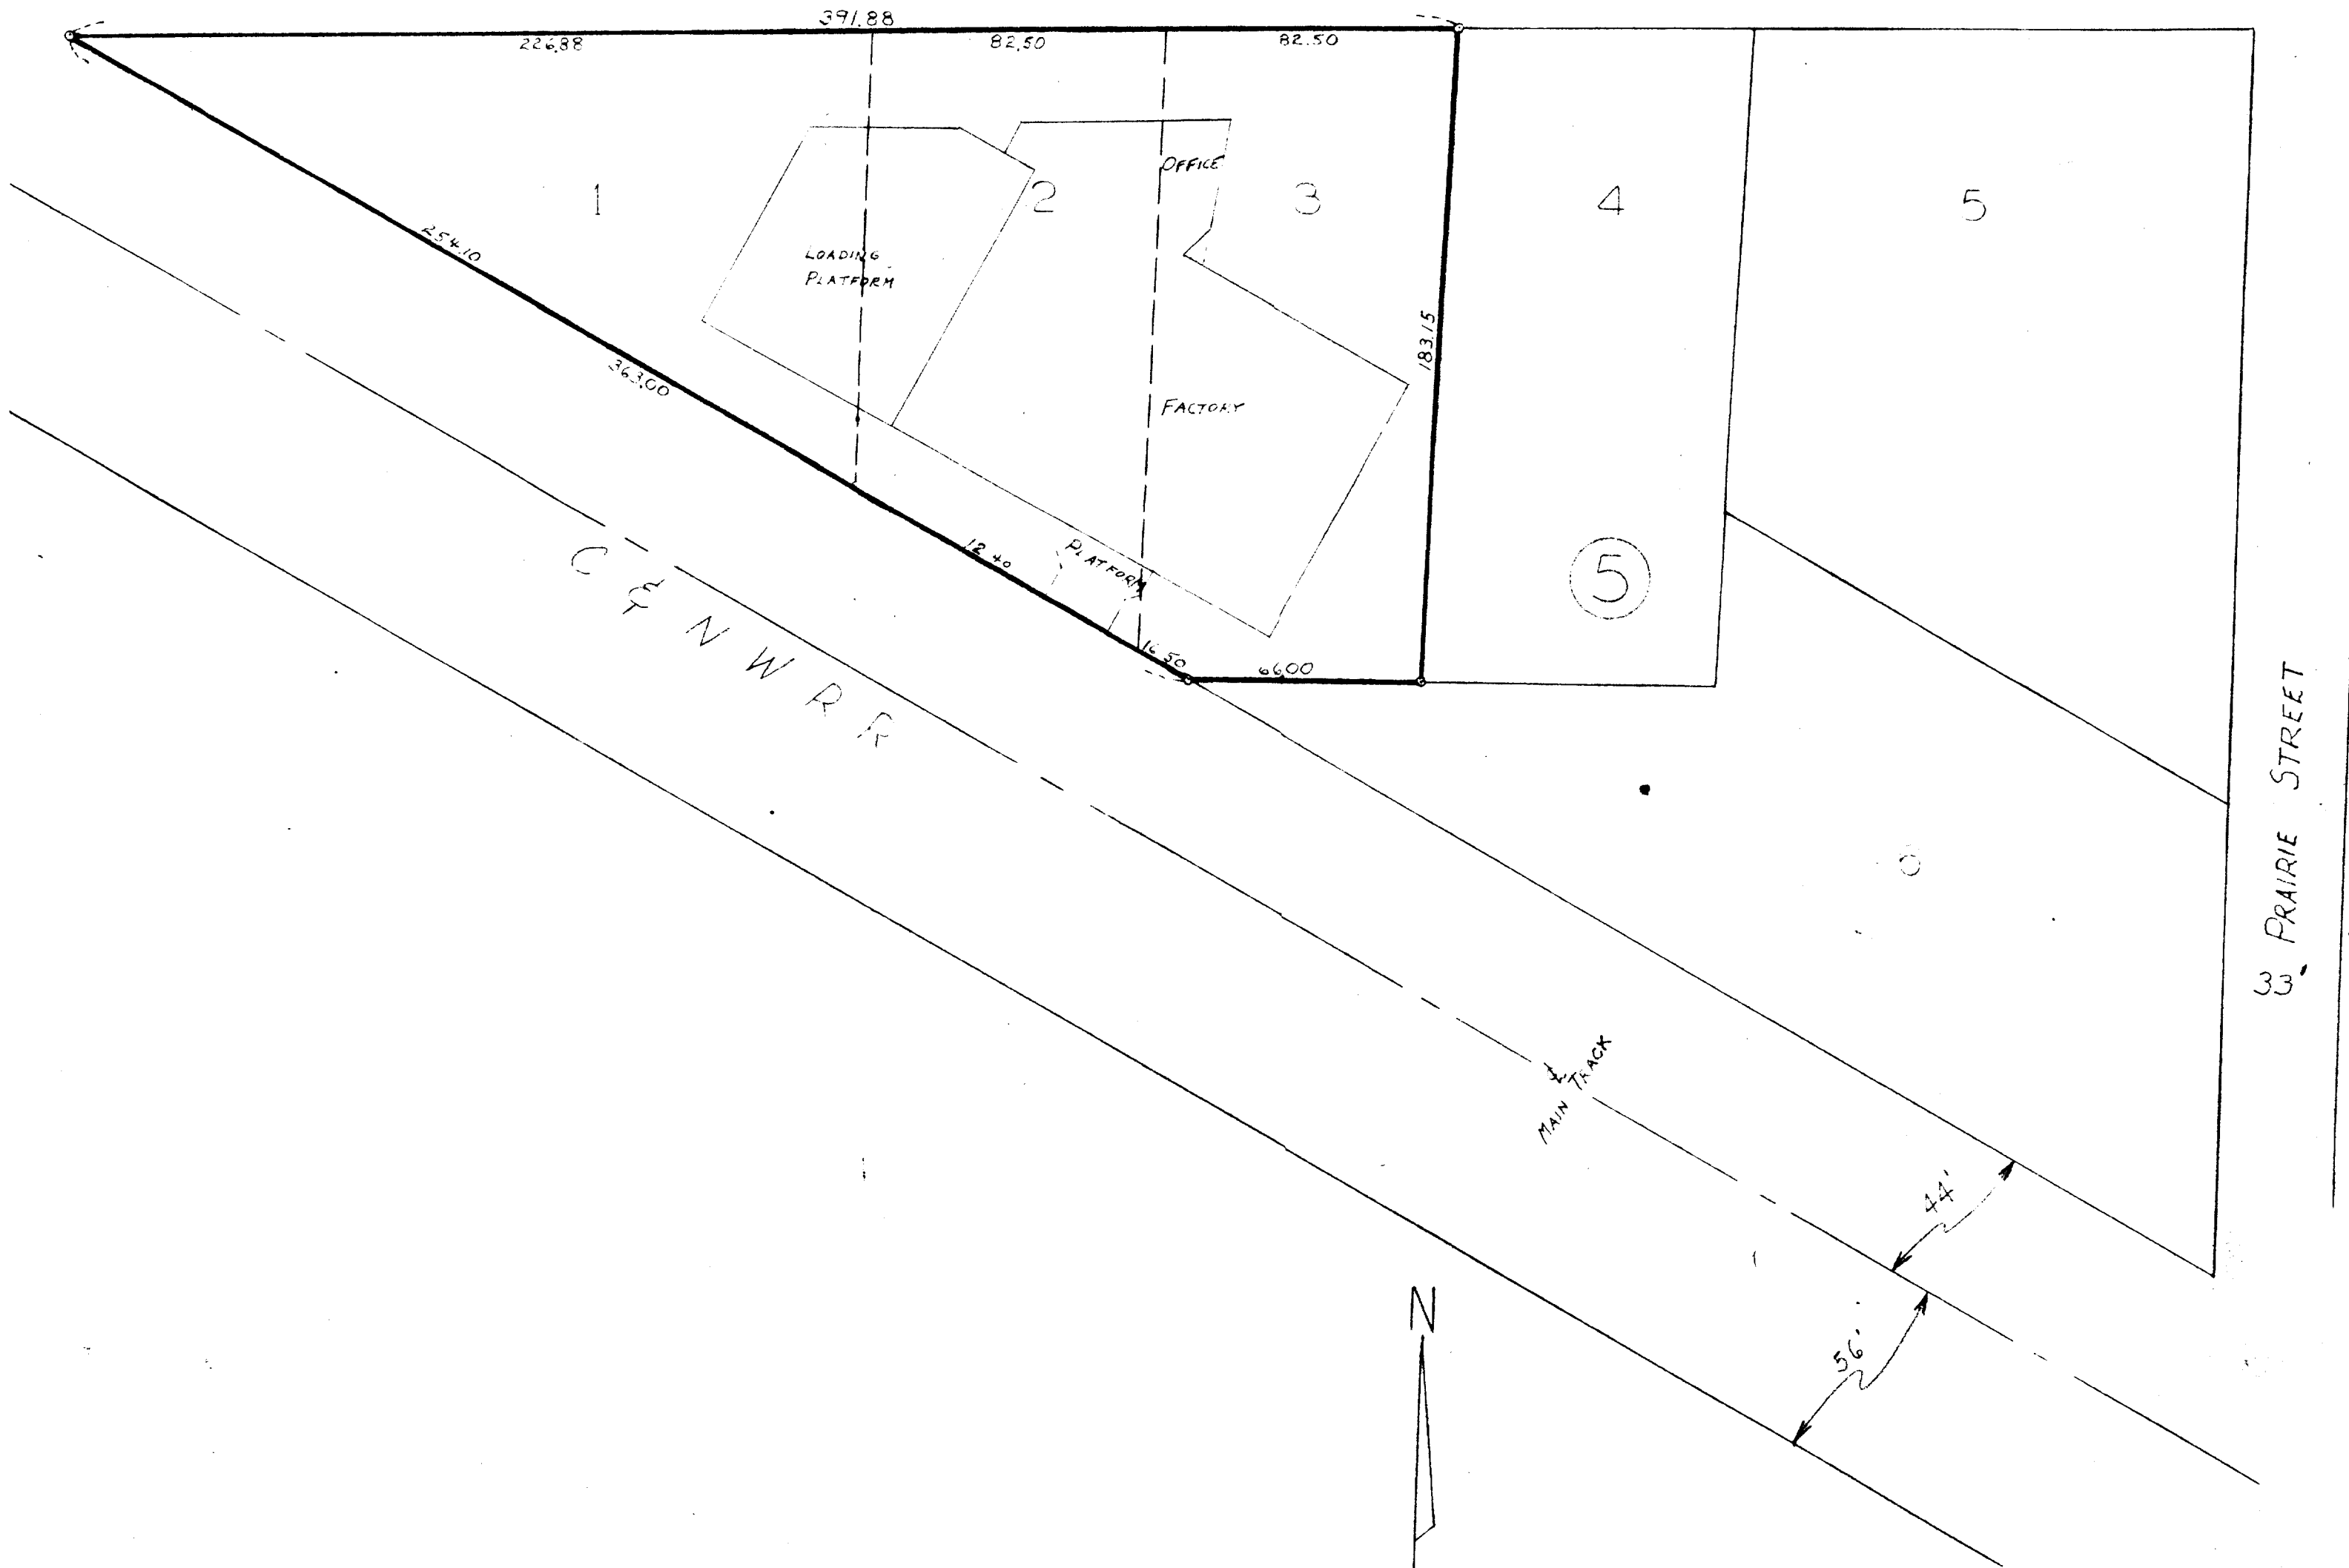

o - IRON PIPE

PLAT OF SURVEY
OF
LOTS 1, 2, & 3 BLOCK 5
OF
WISE AND NELSON'S SOUTH SIDE ADDITION
TO THE
VILLAGE OF SHARON, WALWORTH COUNTY, WISC.

Lloyd L. Jensen
SURVEYOR

8-6

DATE DEC 1953