


HAROLD H. KOLB

REGISTERED PROFESSIONAL LAND SURVEYOR
LAKE GENEVA, WISCONSIN

NOTE: FOUND IRON PIPE 2.09'
SOUTH AND .09' EAST OF CORNER

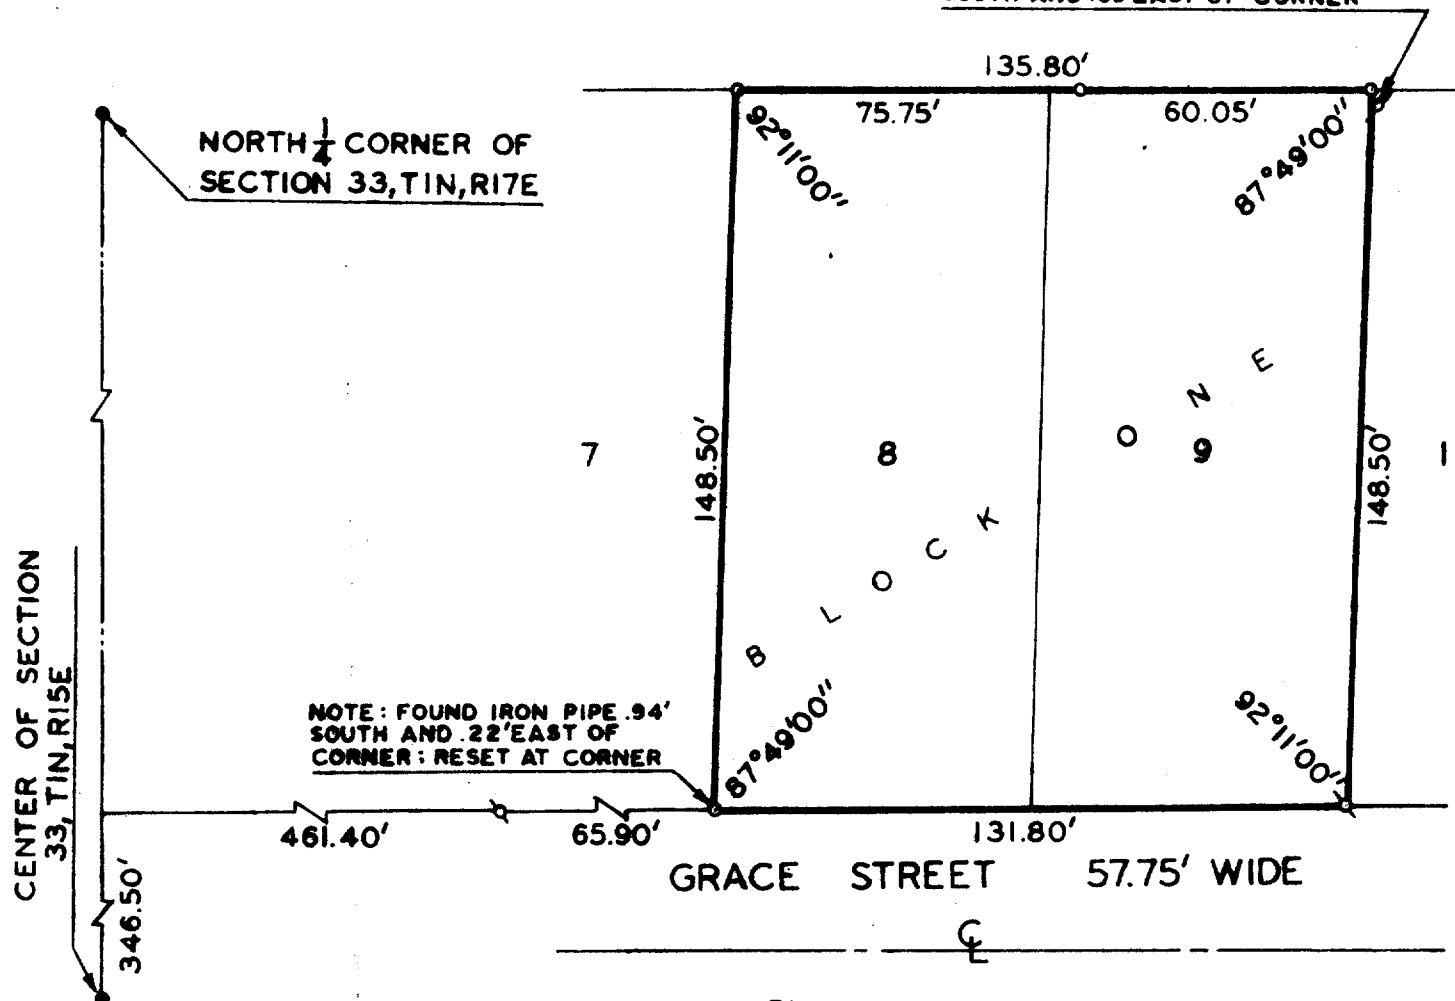

UHA-7

8-70