


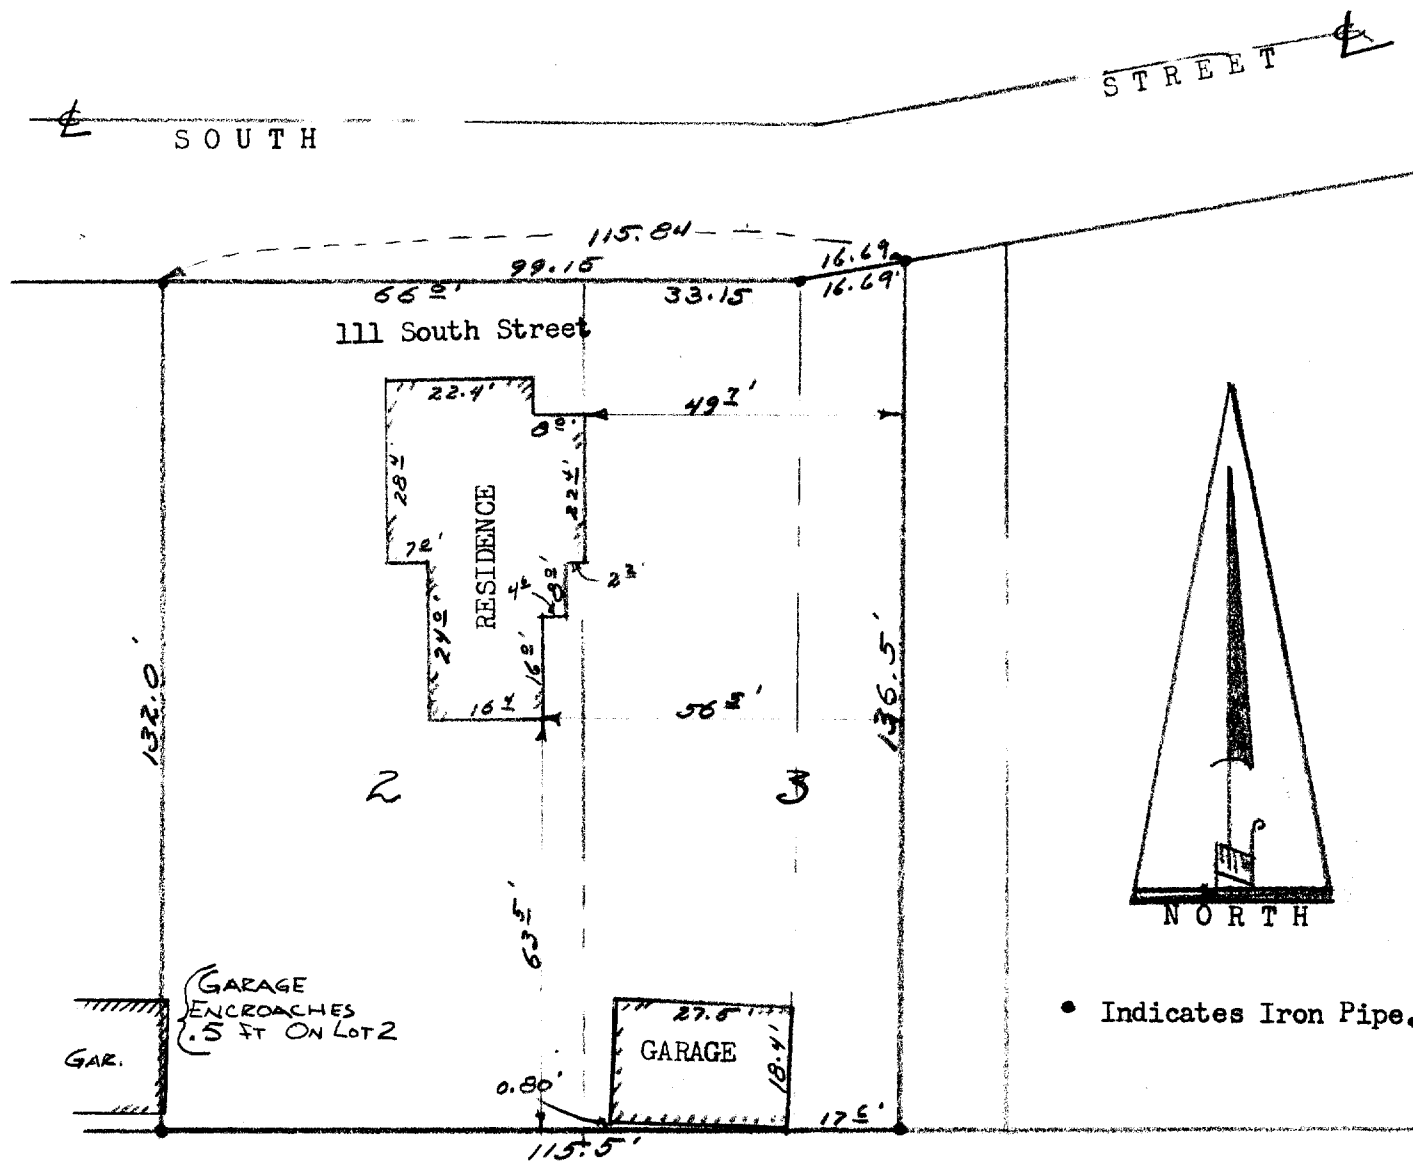

DESCRIPTION:

Lot 2 and the West 3/4 of Lot 3, Block 13 of the Original Plat of the Village of Sharon, Walworth County, Wisconsin.

CERTIFICATE:

I, hereby certify that I have surveyed the above mentioned property and that the hereon portrayed is an accurate survey and a true representation thereof and correctly shows the exterior boundary lines and the location of the buildings and other improvements thereof.

February 8th 1966

James F. Biagi, R.L.S. 272
Elkhorn, Wisconsin.

Dated: February 8th 1966.

