


N

Scale - 1" = 60'
 O = Iron Pipe

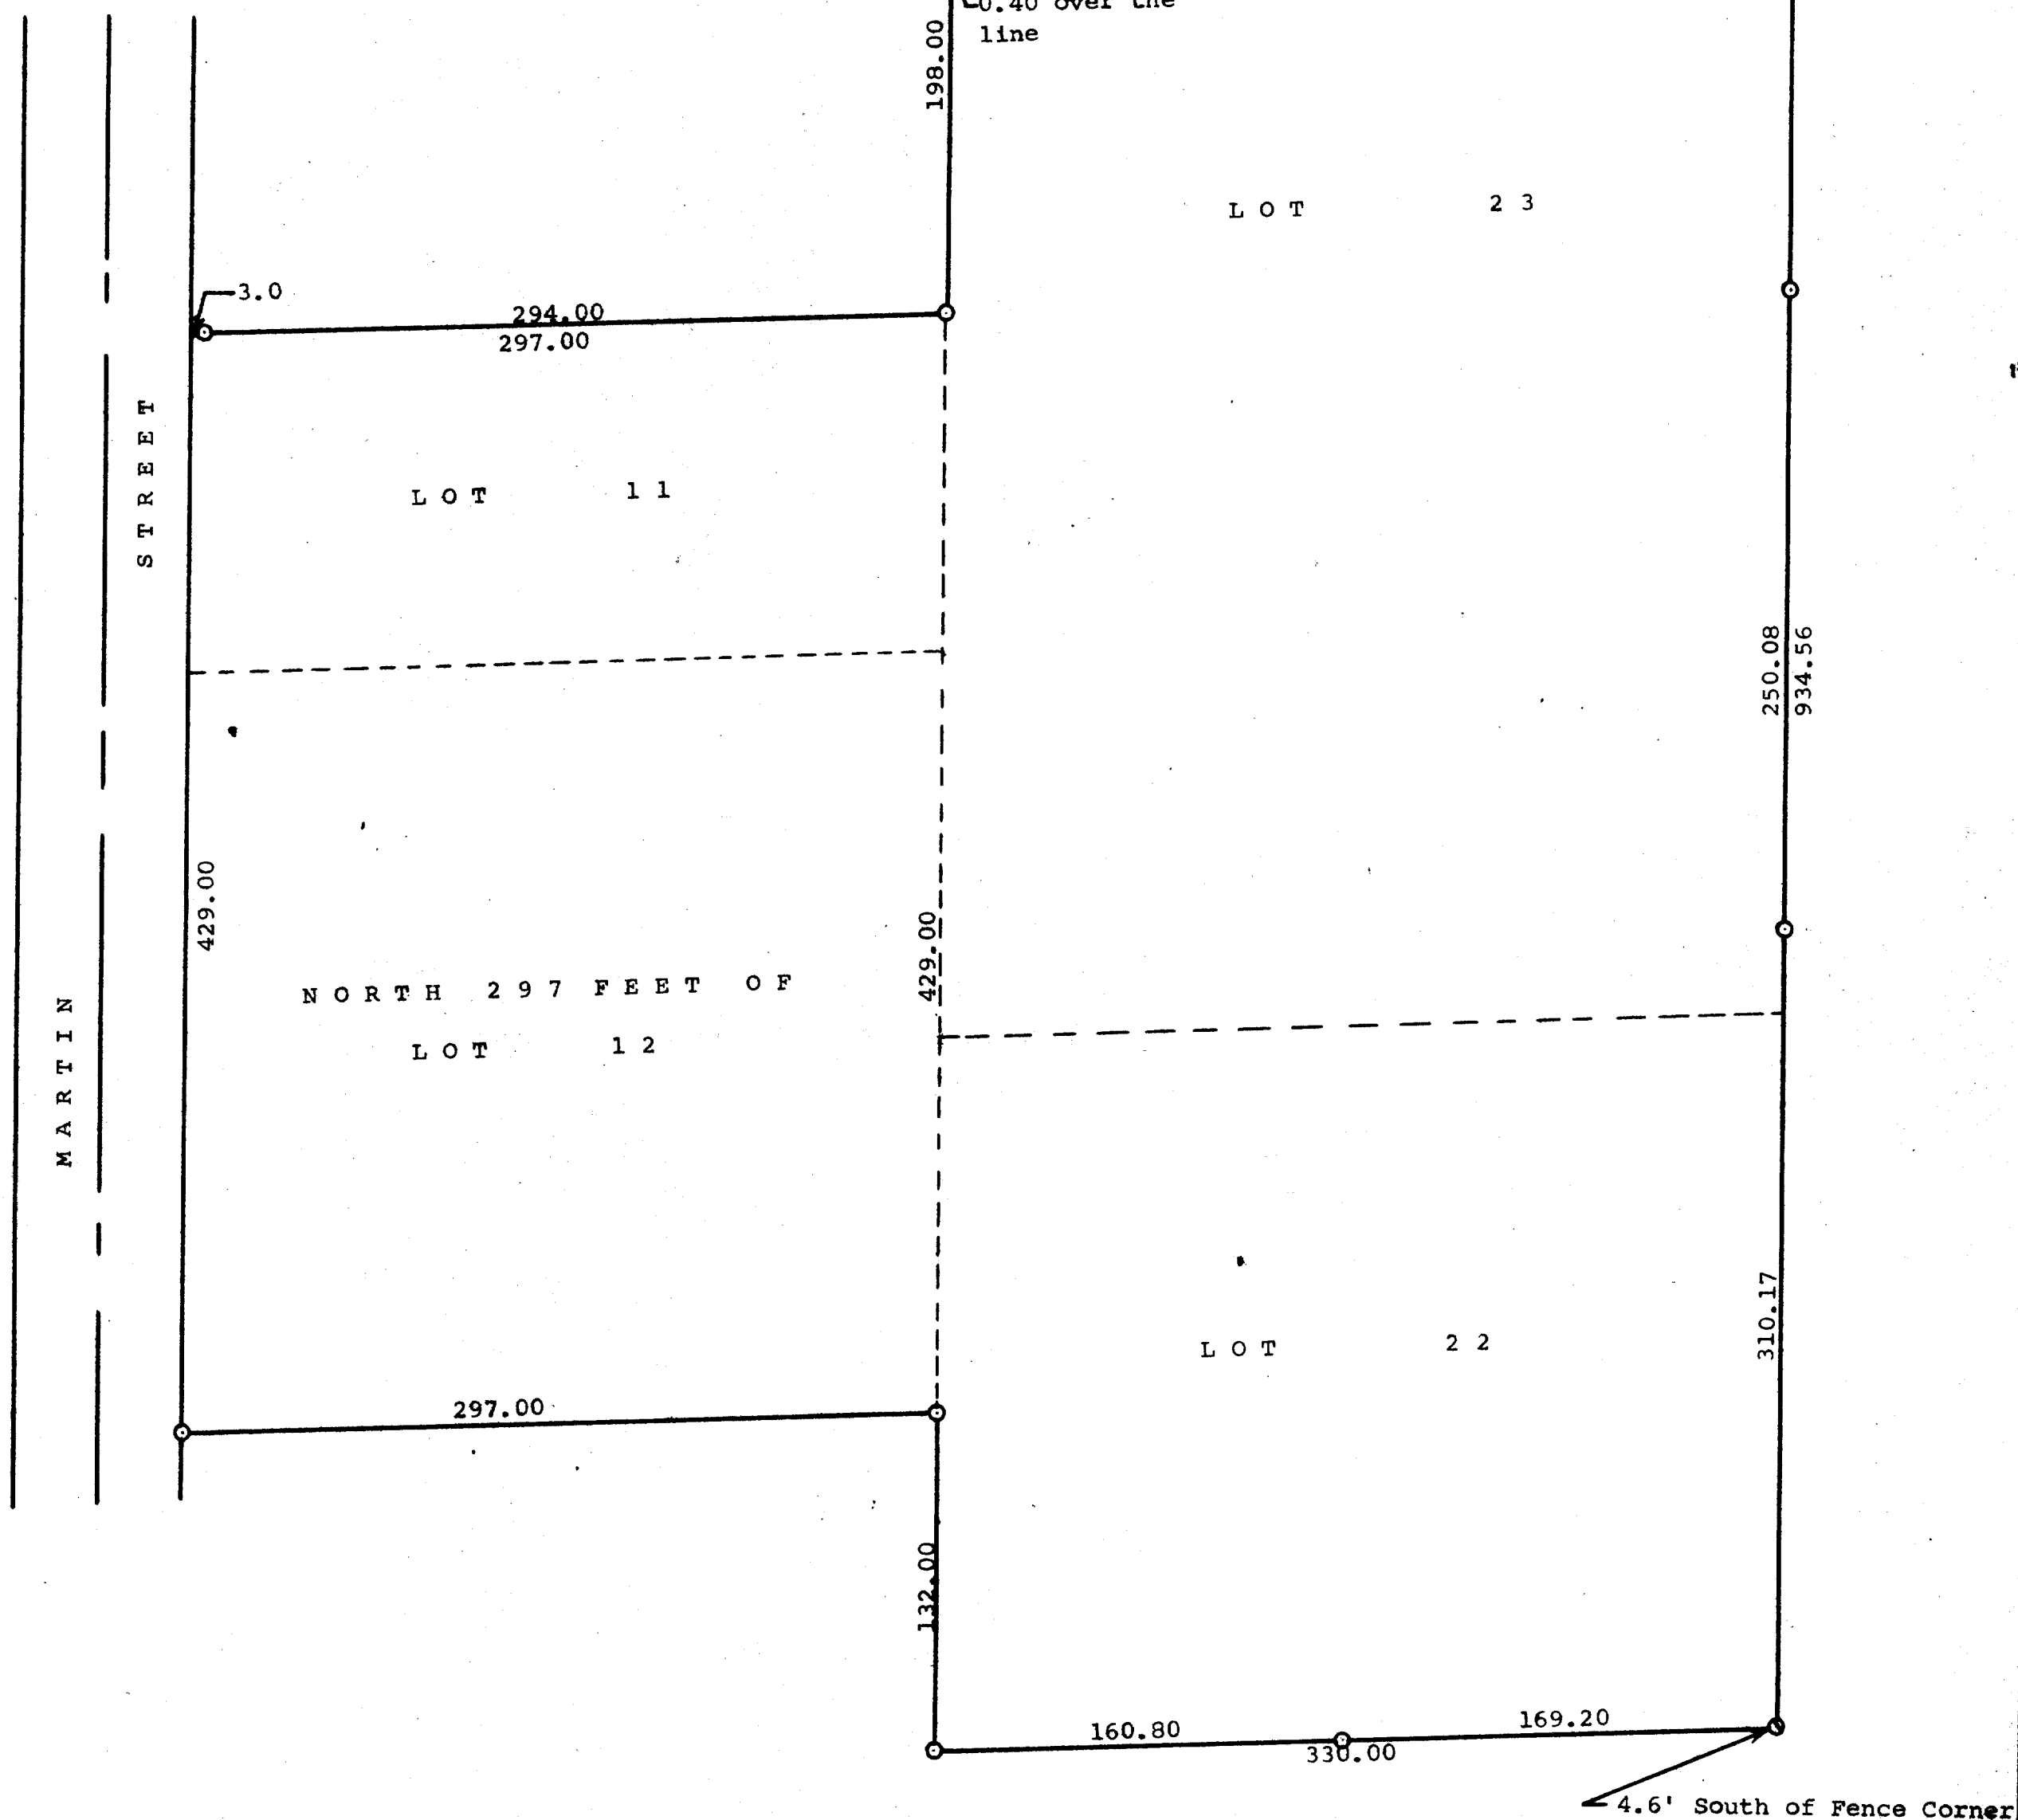

Plat of survey of Lots 11, 22, 23, and the North 297' of Lot 12,
 Block 8, Citizens Addition to the Village of Sharon, Walworth County,
 Wisconsin.
 June 1962 UCA-126-127

George T. Dunham
 George T. Dunham, Surveyor