


Northwest corner of Lot 19,
Block 8 of Citizens Addition
to the Village of Sharon,
Walworth County, Wisconsin.

DUNHAM SURVEYING, S.C.
SURVEYING & SUBDIVIDING
DELAVAN, WISCONSIN 53115

MARTIN


STREET

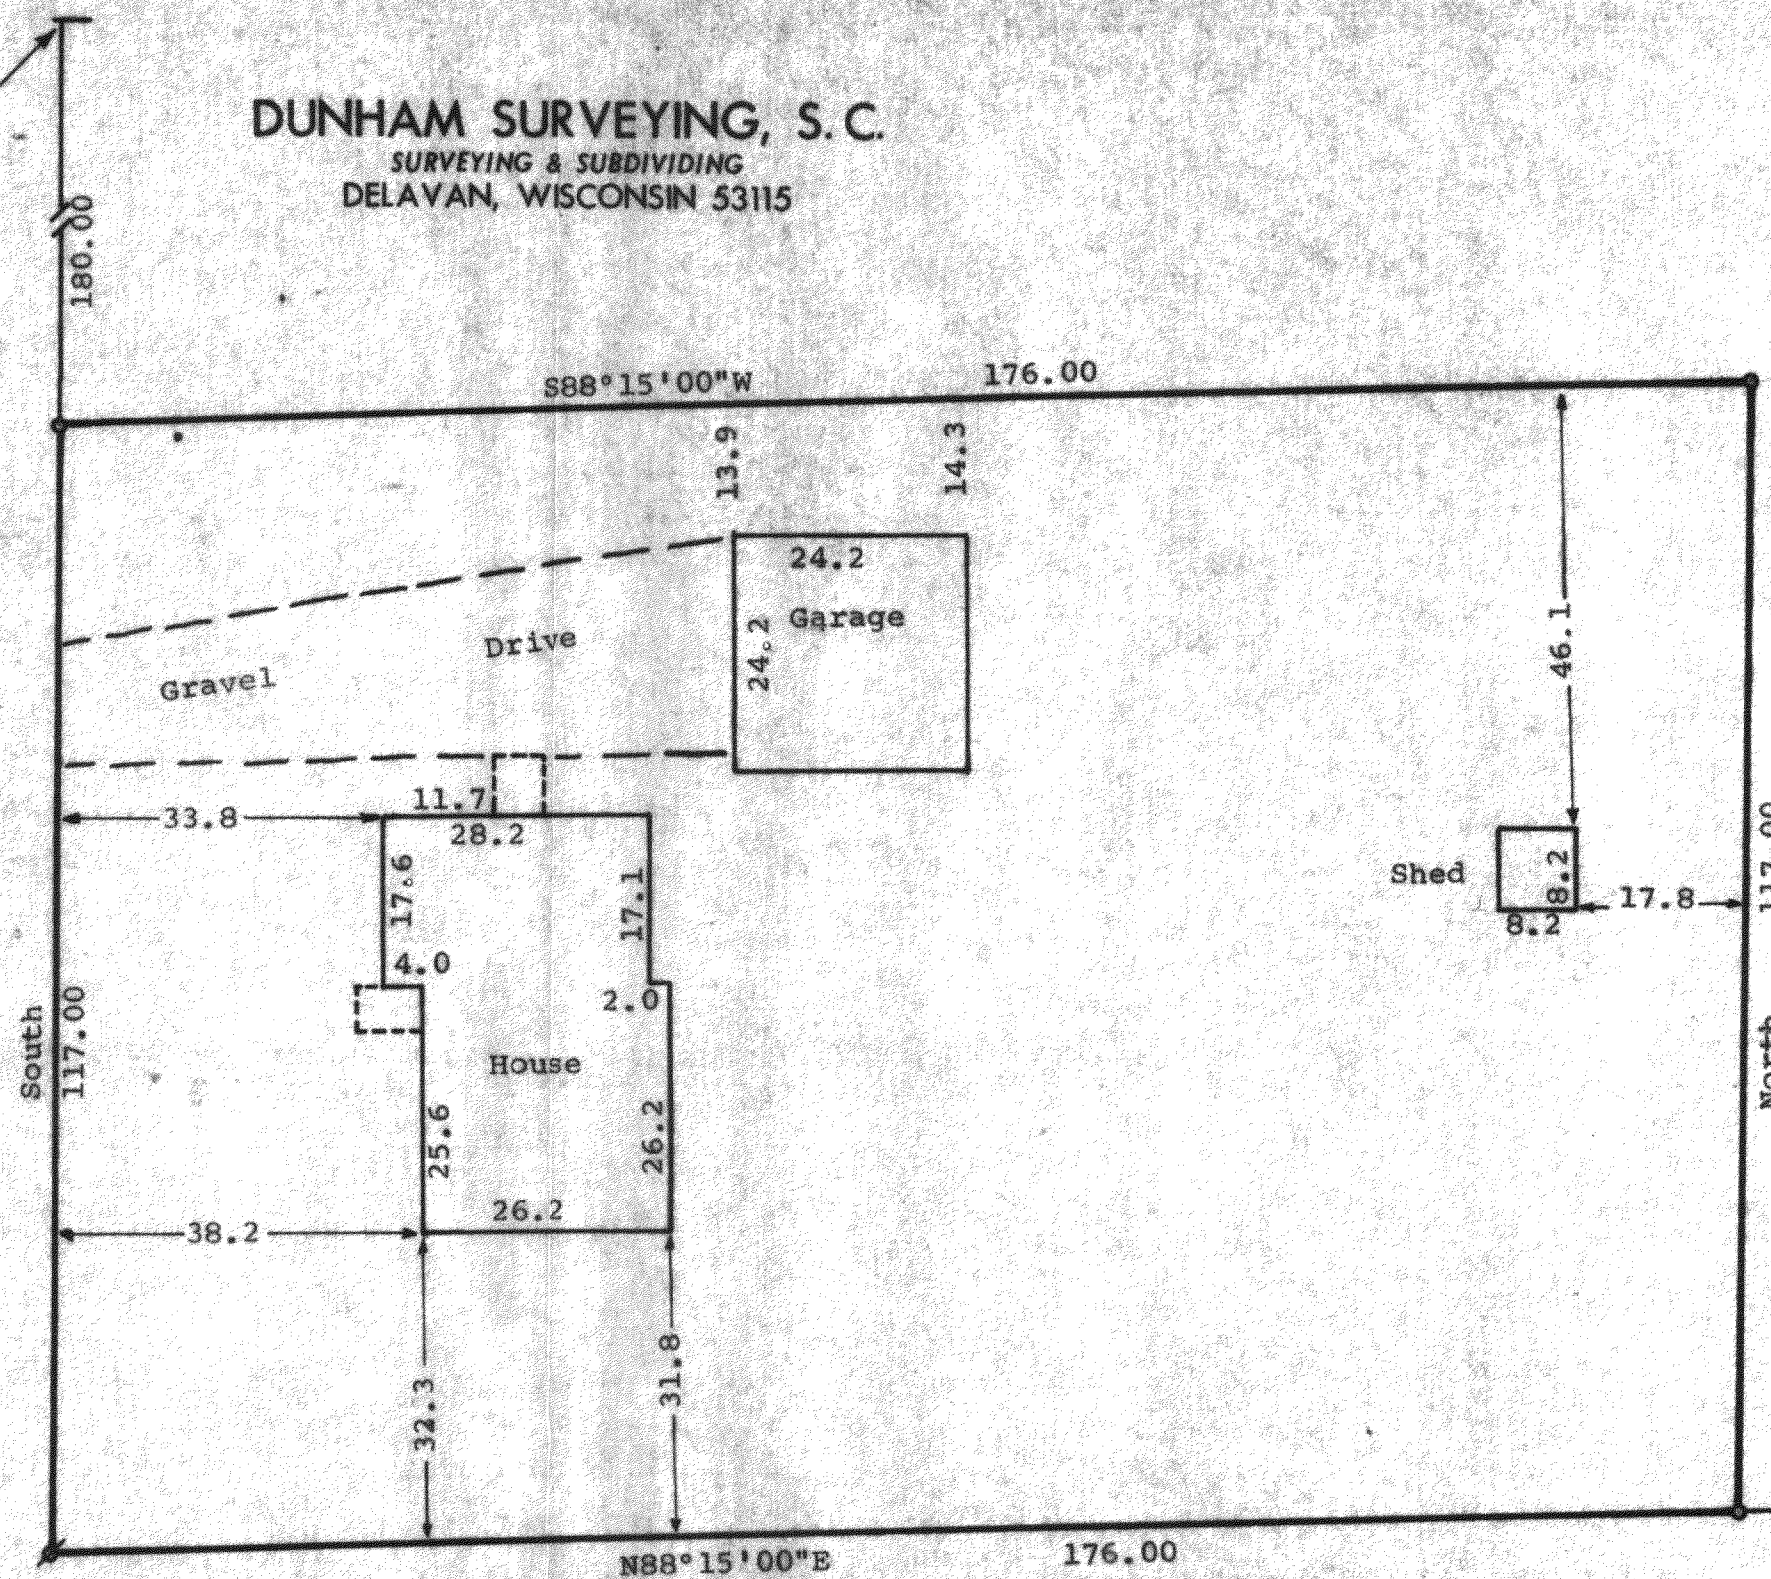

STATE

LINE

ROAD

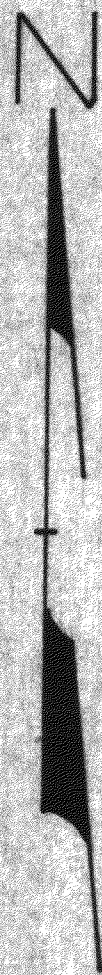

Scale - 1" = 20'
o = 3/4" Dia. Iron Pipe Found
x = 1 1/2" Dia. Iron Pipe Found

Bearings are referenced to
East line of Martin Street
Assumed Bearing of North -
South.

Property Owners:
Gregory & Debra Warren
Sharon, Wisconsin 53585

STATE OF WISCONSIN) SS
COUNTY OF WALWORTH)

I, James M. Dunham, Surveyor, certify that I have surveyed
the property described as follows:

A parcel of land located in Lot 19, Block 8 of Citizen's
Addition to the Village of Sharon, Walworth County, Wisconsin,
described as follows: Commencing at the Northwest corner
of said Lot 19; thence South along the west line of said Lot 19,
180.00 feet to the place of beginning; thence N88°15'00"E, parallel
with the north line of said Lot 19, 176.00 feet; thence South,
parallel with the west line of said Lot 19, 117.00 feet; thence
S88°15'00"W, along the south line of said Lot 19, 176.00 feet;
thence North, along the west line of said Lot 19, 117.00 feet
to the place of beginning, subject to easements of record,
and that the above map is a true representation thereof and shows the
size and location of the property, its exterior boundaries, the location
of all visible structures and dimensions of all principal buildings
thereon, boundary fences, apparent easements, roadways and visible
encroachments, if any.

I, James M. Dunham, do hereby certify that I have surveyed the property
hereon described according to the official records, and that the plat
hereon is a correct representation of the lot lines to the best of my
knowledge and belief.
April 6, 1983

James M. Dunham
James M. Dunham, Surveyor

