


GEORGE T. DUNHAM
SURVEYING & SUBDIVIDING
DELAVER, WISCONSIN

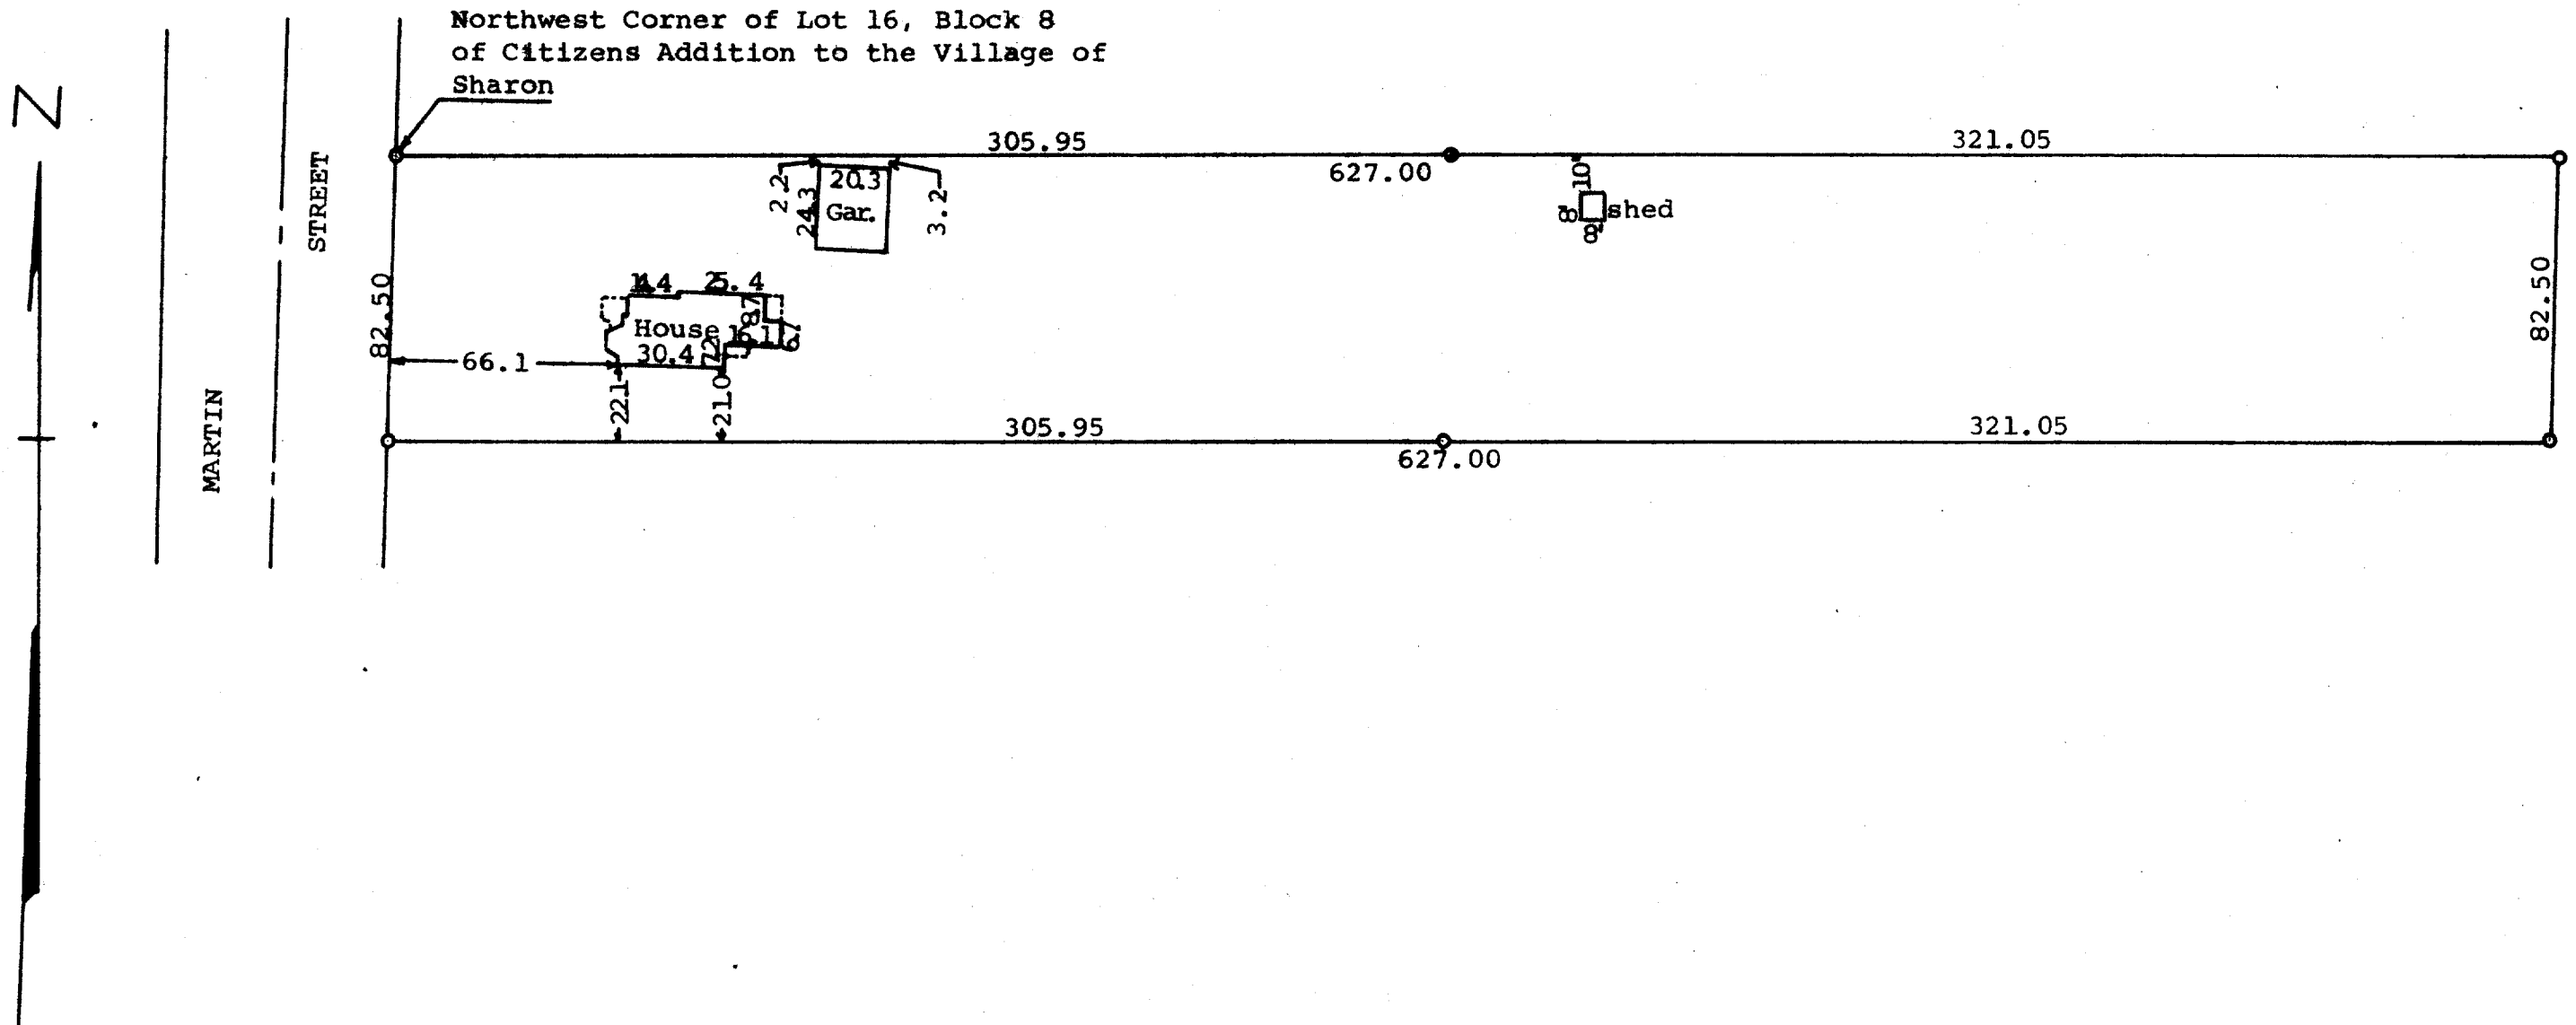

Scale - 1" = 50'
o = Iron Pipe

STATE OF WISCONSIN) SS
COUNTY OF WALWORTH)

I, George T. Dunham, Surveyor, certify that I have
surveyed the property described as follows,

A parcel of land located in Lot 16, Block 8 of
Citizens Addition to the Village of Sharon, Walworth
County, Wisconsin, described as follows, to-wit:
Beginning at the northwest corner of Lot 16, Block
8, Citizens Addition; thence East 38 rods; thence
South 5 rods; thence West 38 rods; thence North 5 rods
to the place of beginning,

and that the above plat is an accurate survey and a true representation
thereof and correctly shows the exterior boundary lines and location
of buildings on said property and the correct measurements thereof.

August 5, 1971

Revised July 17, 1978

George T. Dunham
George T. Dunham, Surveyor

