
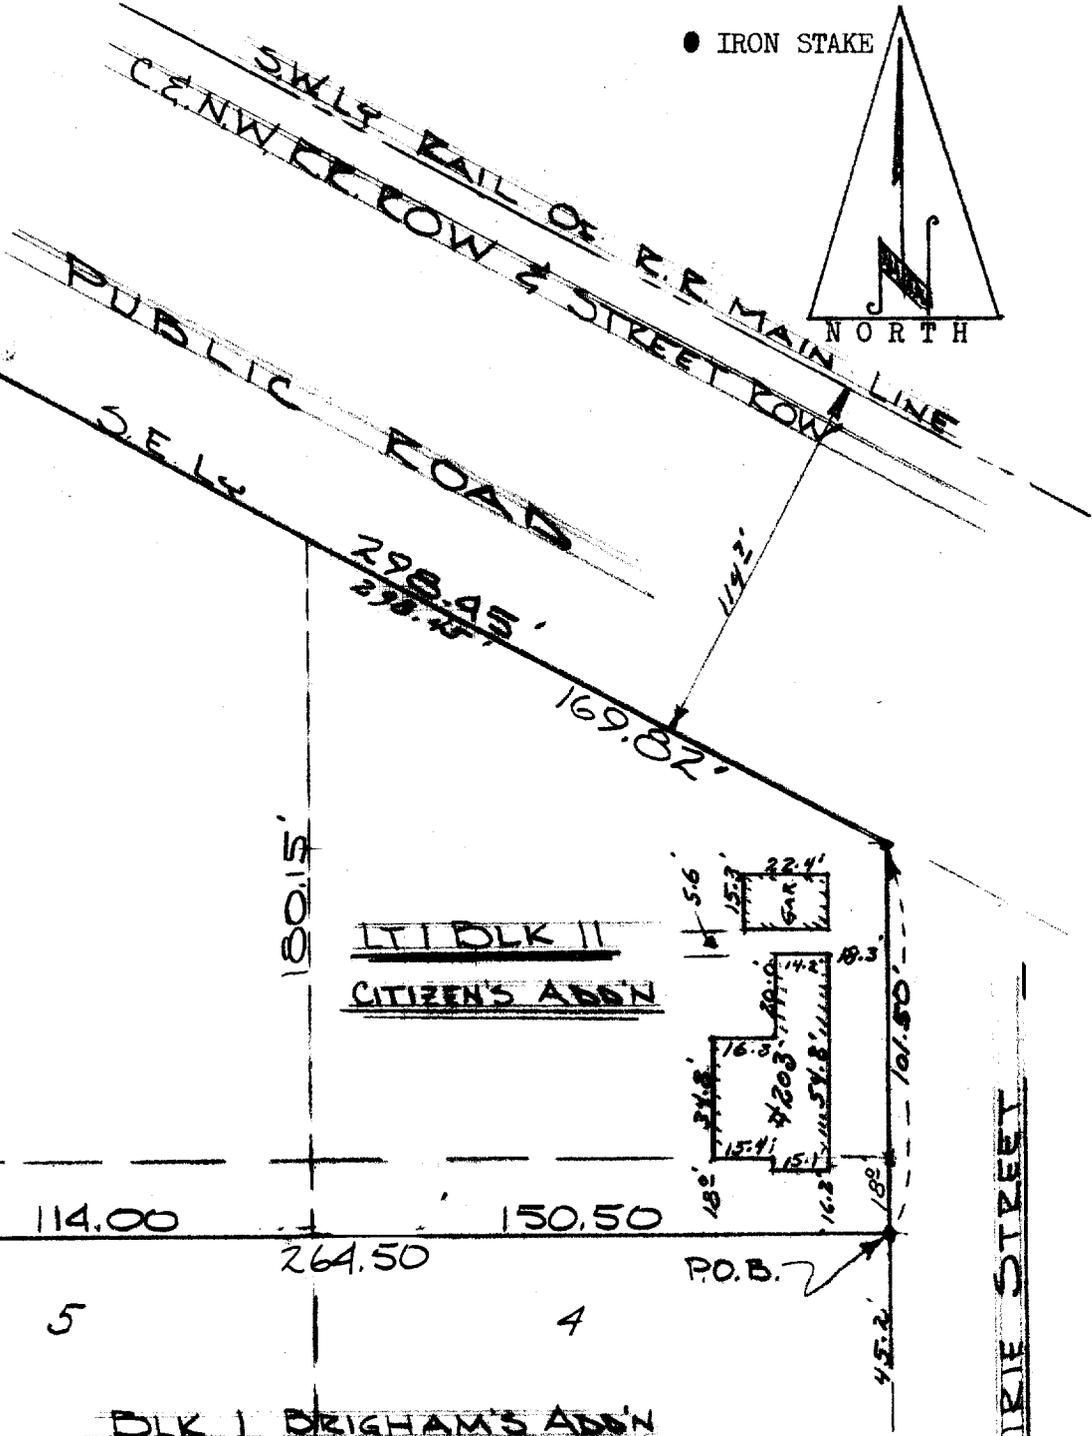


● IRON STAKE

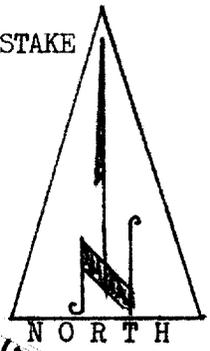

DLK 1 BRIGHAM'S ADDN

**DESCRIPTION:** The East 150.50 feet of the following described property:  
Commencing at a point on the East lot line of Lot 4 Block 1 Brigham's Addition to the Village of Sharon, Walwerth County Wisconsin which point is 18.00 feet south of the northeast corner of said Lot 4, thence westerly 264.5 feet, thence northerly to the southerly line of a road which runs along the right of way of the C. & NW. RR Co. thence easterly to the northeasterly line of Lot 1 Block 11, Citizens Addition, thence southeasterly to the east line of said Block 11, thence south to the place of beginning and Lot 1 Block 11 Citizens Addition to the Village of Sharon, Walwerth County, Wisconsin.

**Certificate:** I hereby certify that I have surveyed the above mentioned property and that the hereon portrayed is an accurate survey and a true representation thereof and correctly shows the exterior boundary lines and the location of the buildings and other improvements thereof.

February 2nd 1966.

*James F. Biagi*  
James F. Biagi, RLS/272  
Elkhorn, Wisconsin.