


DELAWARE WORKSHEET 53115

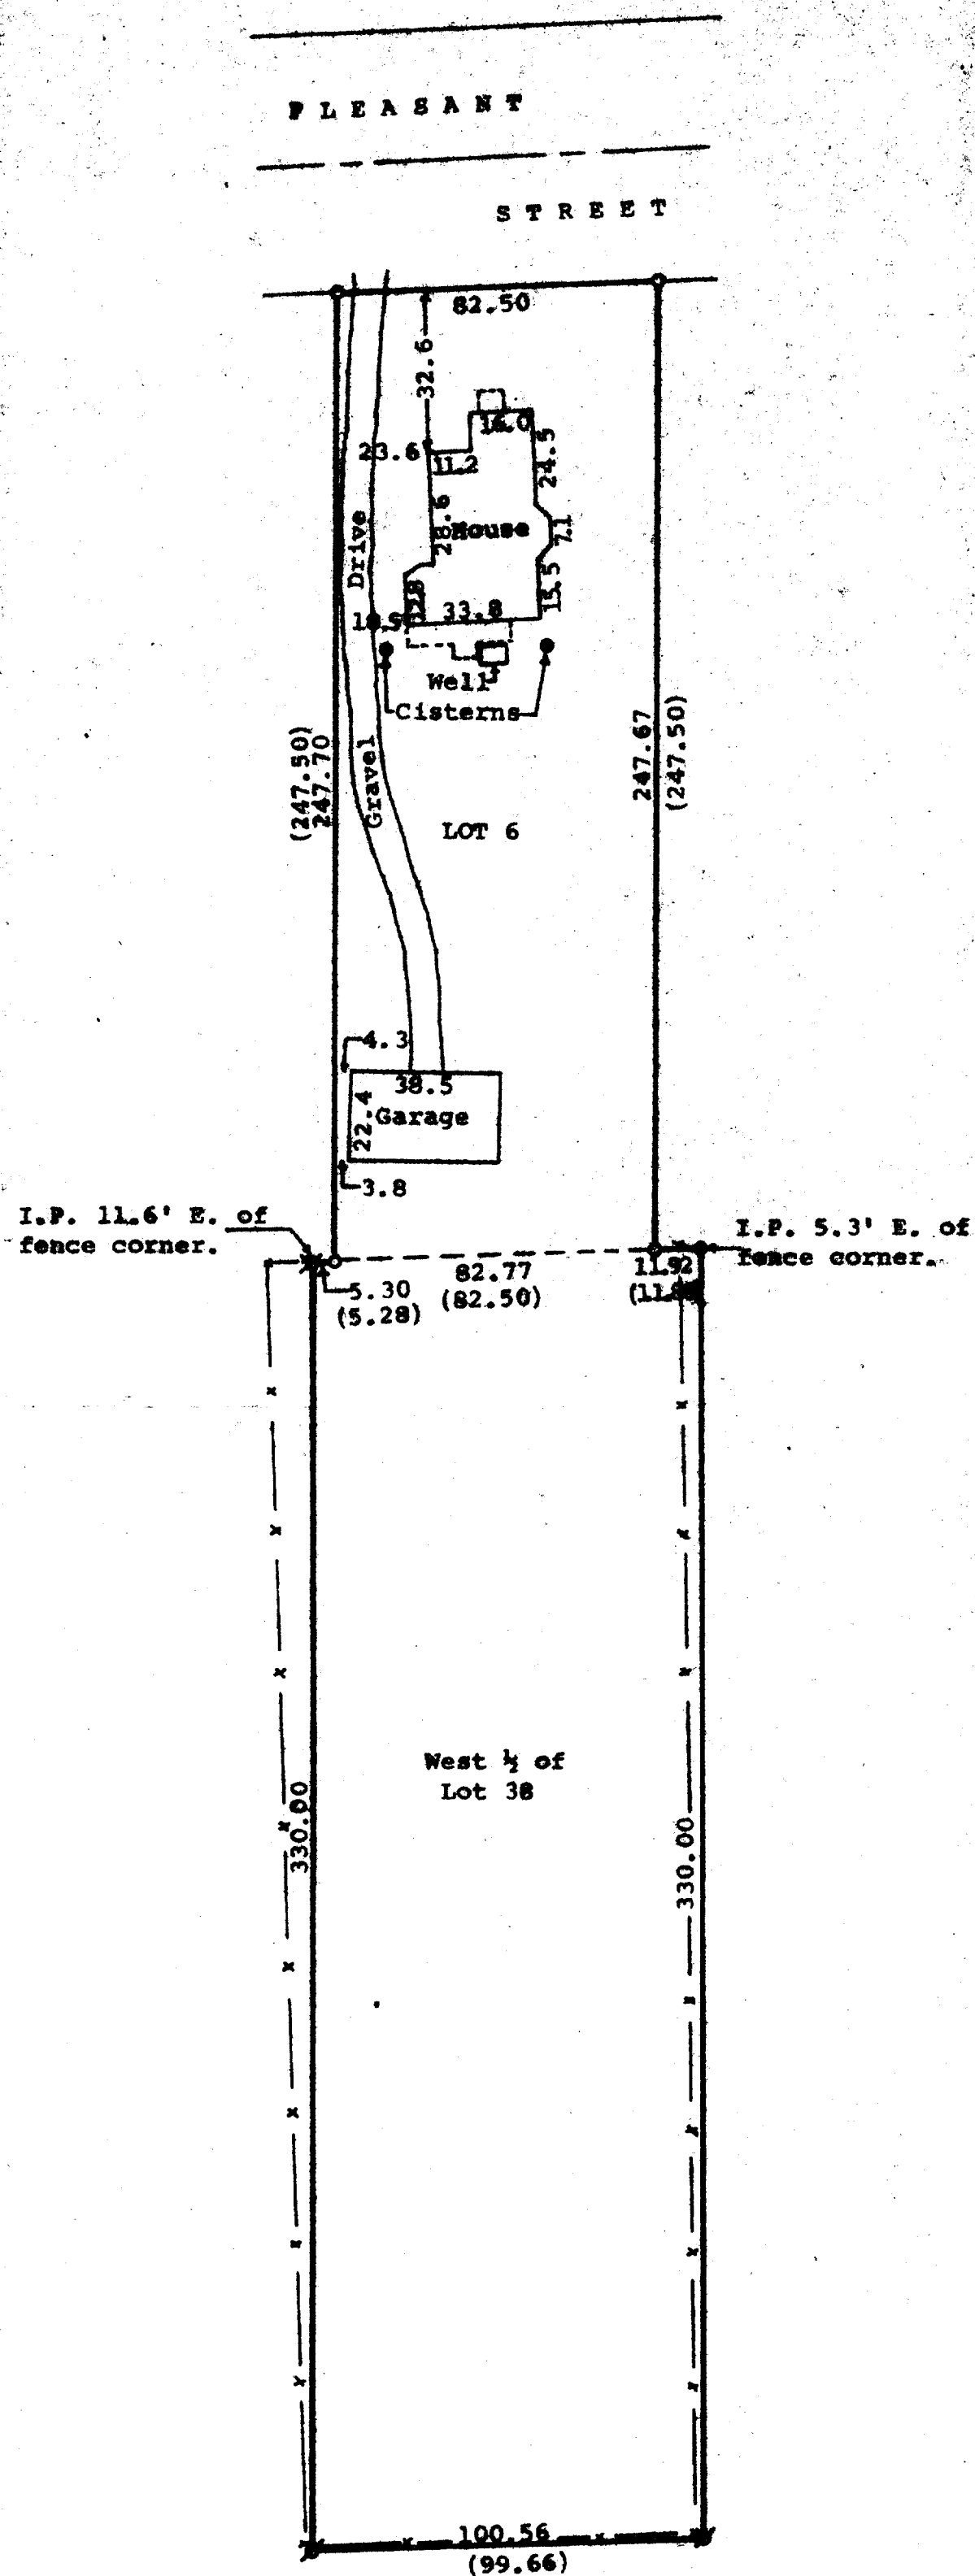

Scale - 1" = 40'
 ♂ = Iron Pipe Found
 ○ = Iron Pipe Set
 - = Fence Line
) = Recorded Distance

STATE OF WISCONSIN)
COUNTY OF WALWORTH) SS

I, James M. Dunham, Surveyor, certify that I have surveyed the property described as follows,

Lot 6 and the West 1/4 of Lot 38, Block 9 of the Citizens Addition to the Village of Sharon, Walworth County, Wisconsin.

and that this map is a true representation thereof and shows the size and location of the property, its exterior boundaries, the location of all visible structures and dimensions of all principal buildings thereon, boundary fences, apparent easements, roadways and visible encroachments, if any.

This survey is made for the use of the present owners of the property, and also those who purchase, mortgage, or guarantee the title thereto within one (1) year from date hereof.

May 1, 1979

James M. Dunham
James M. Dunham, Surveyor

