


DUNHAM SURVEYING, S.C.  
SURVEYING & SUBDIVIDING  
DELAVAN, WISCONSIN 53115

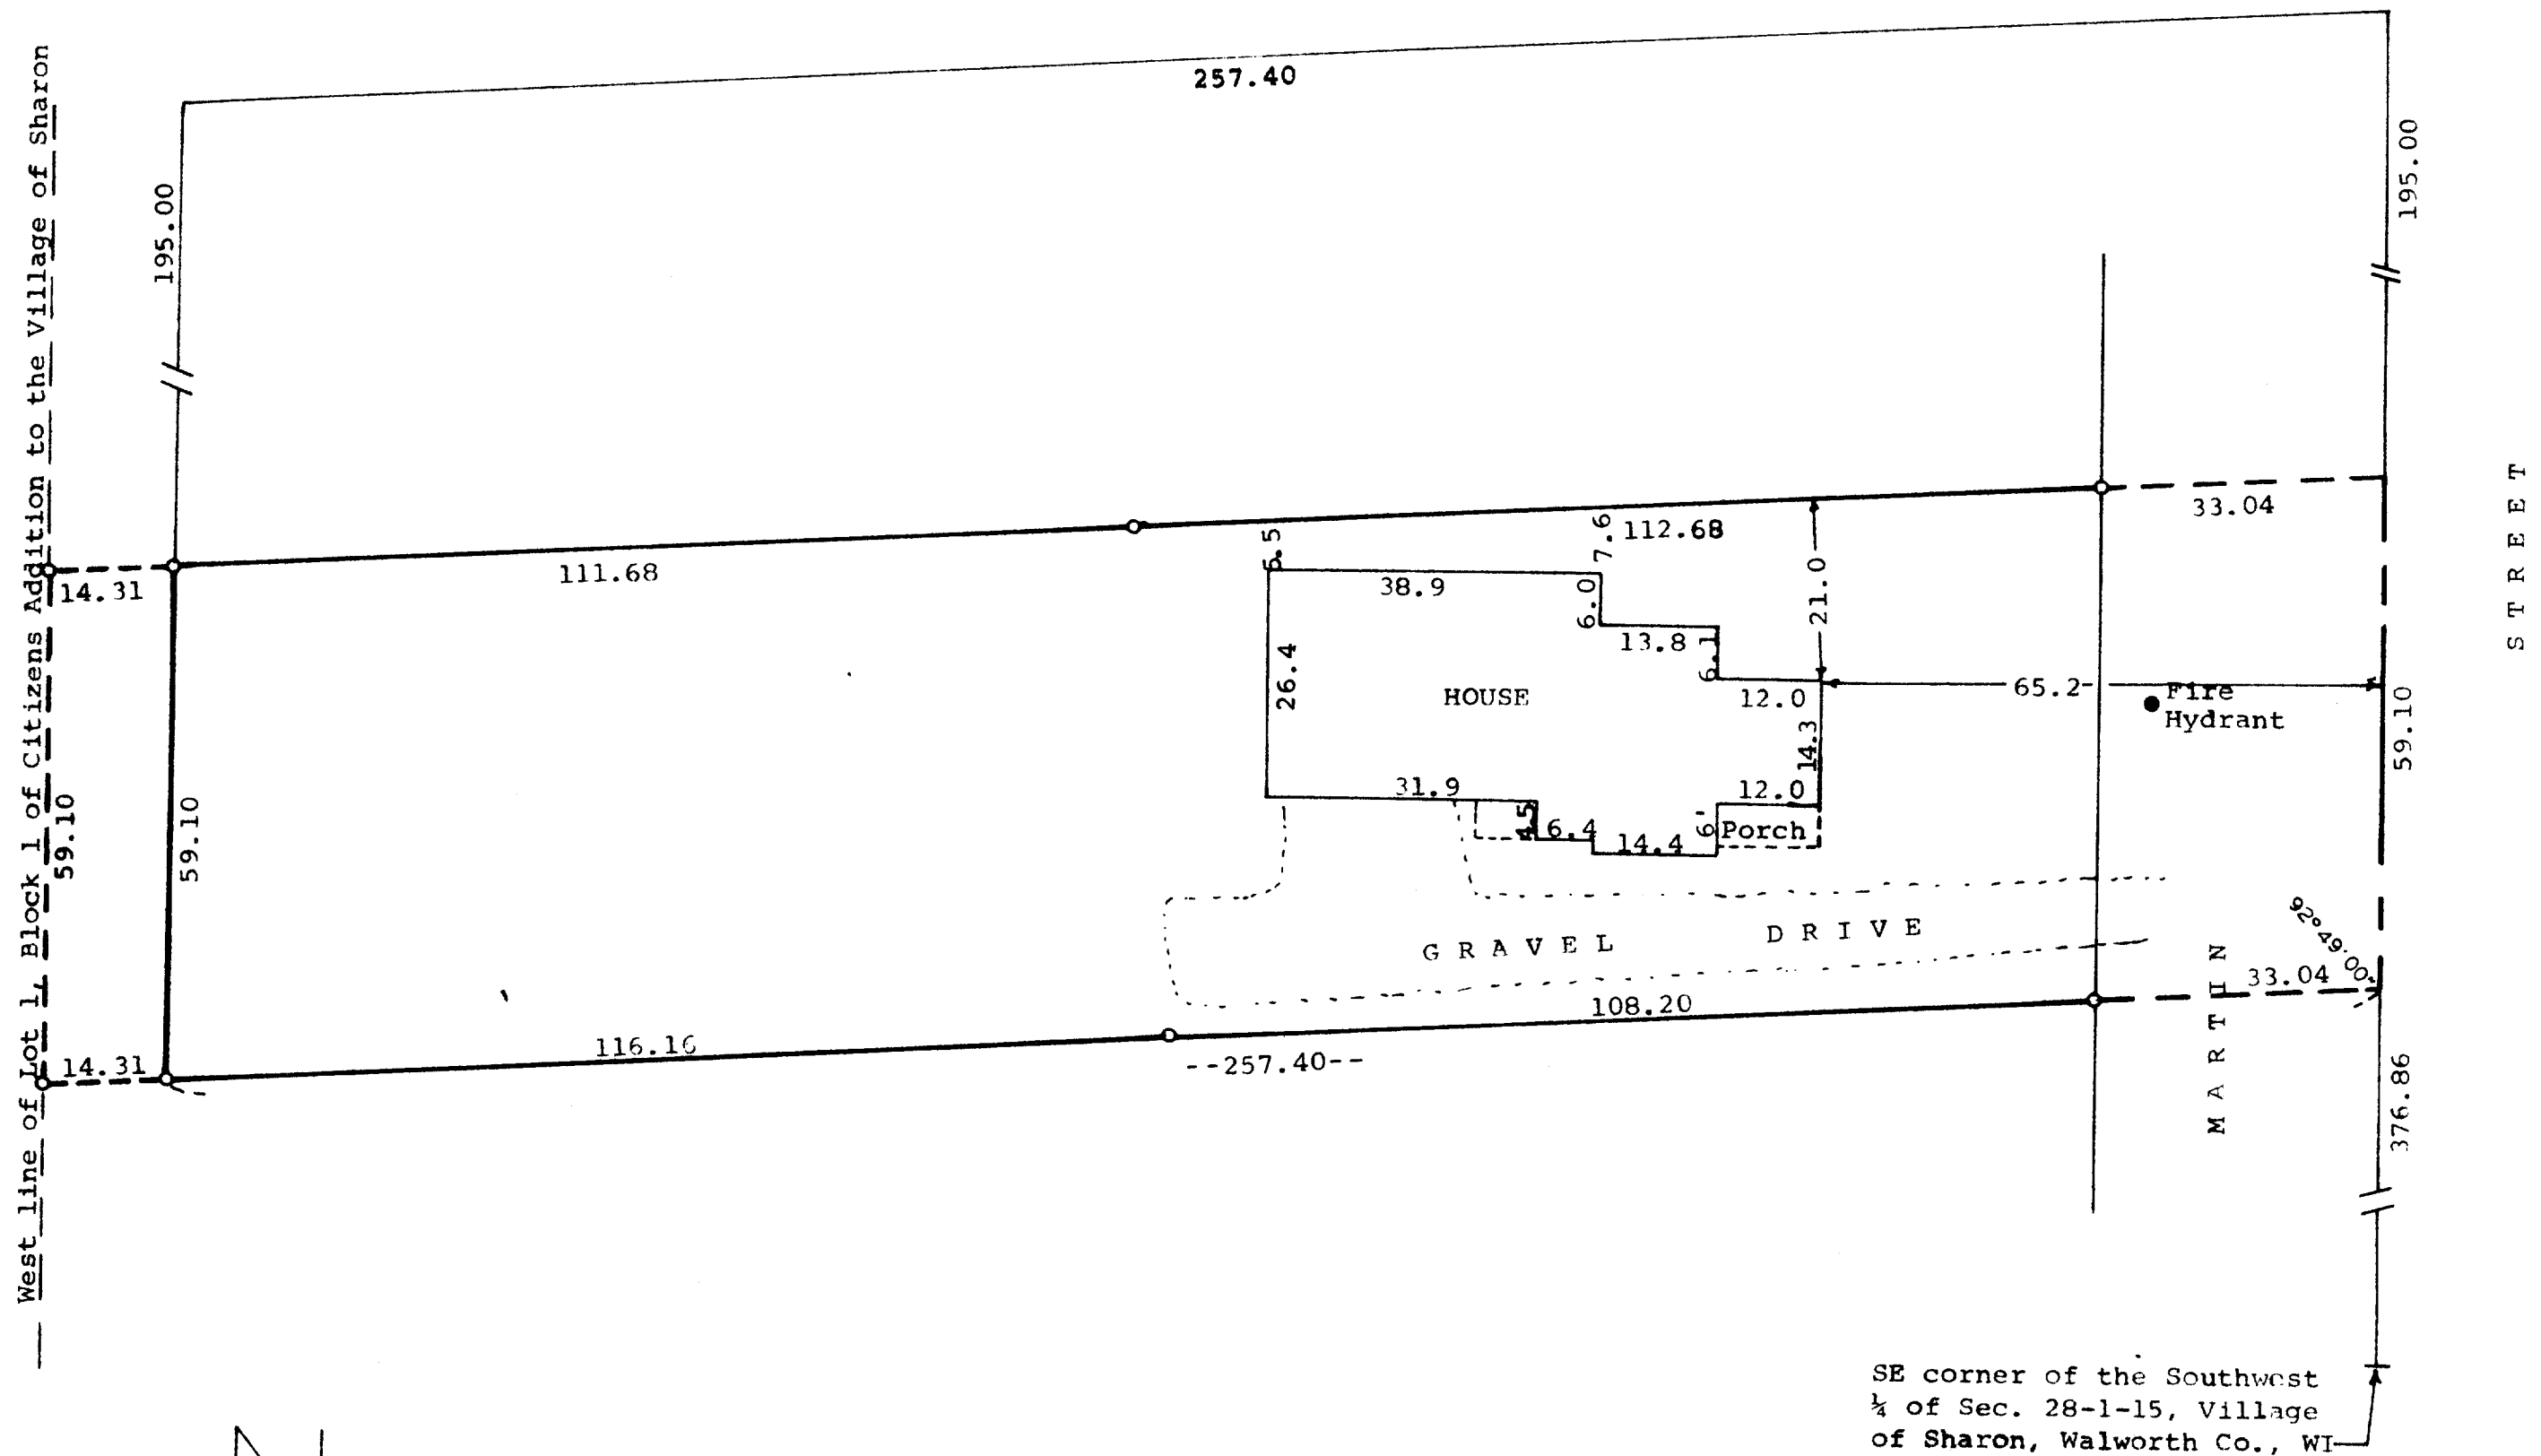

STATE OF WISCONSIN)  
COUNTY OF WALWORTH) SS

I, James M. Dunham, Surveyor, certify that I have surveyed the property described as follows,

A part of Lot 1, Block 1 of Citizens Addition to the Village of Sharon, Walworth County, Wisconsin, described as follows: Beginning at a point in the centerline of Martin Street located 22 rods and 21 links (376.86 feet) north of the Southeast corner of the Southwest 1/4 of Section 28, T 1 N, R 15 E, in said Village of Sharon; thence Westerly parallel with the south line of said Lot 1, 15 rods and 15 links (257.40 feet); thence Northerly parallel with said centerline of Martin Street, 15 Rods and 10 links, (254.10 feet); thence Easterly parallel with the south line of said Lot 1, 15 rods and 15 links (257.40 feet) to the centerline of said Martin Street; thence Southerly along said centerline 15 rods and 10 links (254.10 feet) to the place of beginning EXCEPTING therefrom a strip of land 195.00 feet in width off the entire north side of the above described parcel.

and that the above map is a true representation thereof and shows the size and location of the property, its exterior boundaries, the location of all visible structures and dimensions of all principal buildings thereon, boundary fences, apparent easements, roadways and visible encroachments, if any.

This survey is made for the use of the present owners of the property, and also those who purchase, mortgage, or guarantee the title thereto within one (1) year from date hereof.  
June 28, 1979

Scale - 1" = 20'  
o = Iron Pipe

*James M. Dunham*  
James M. Dunham, Surveyor

