


DUNHAM SURVEYING, S.C.
SURVEYING & SUBDIVIDING
DELAVER, WISCONSIN 53115

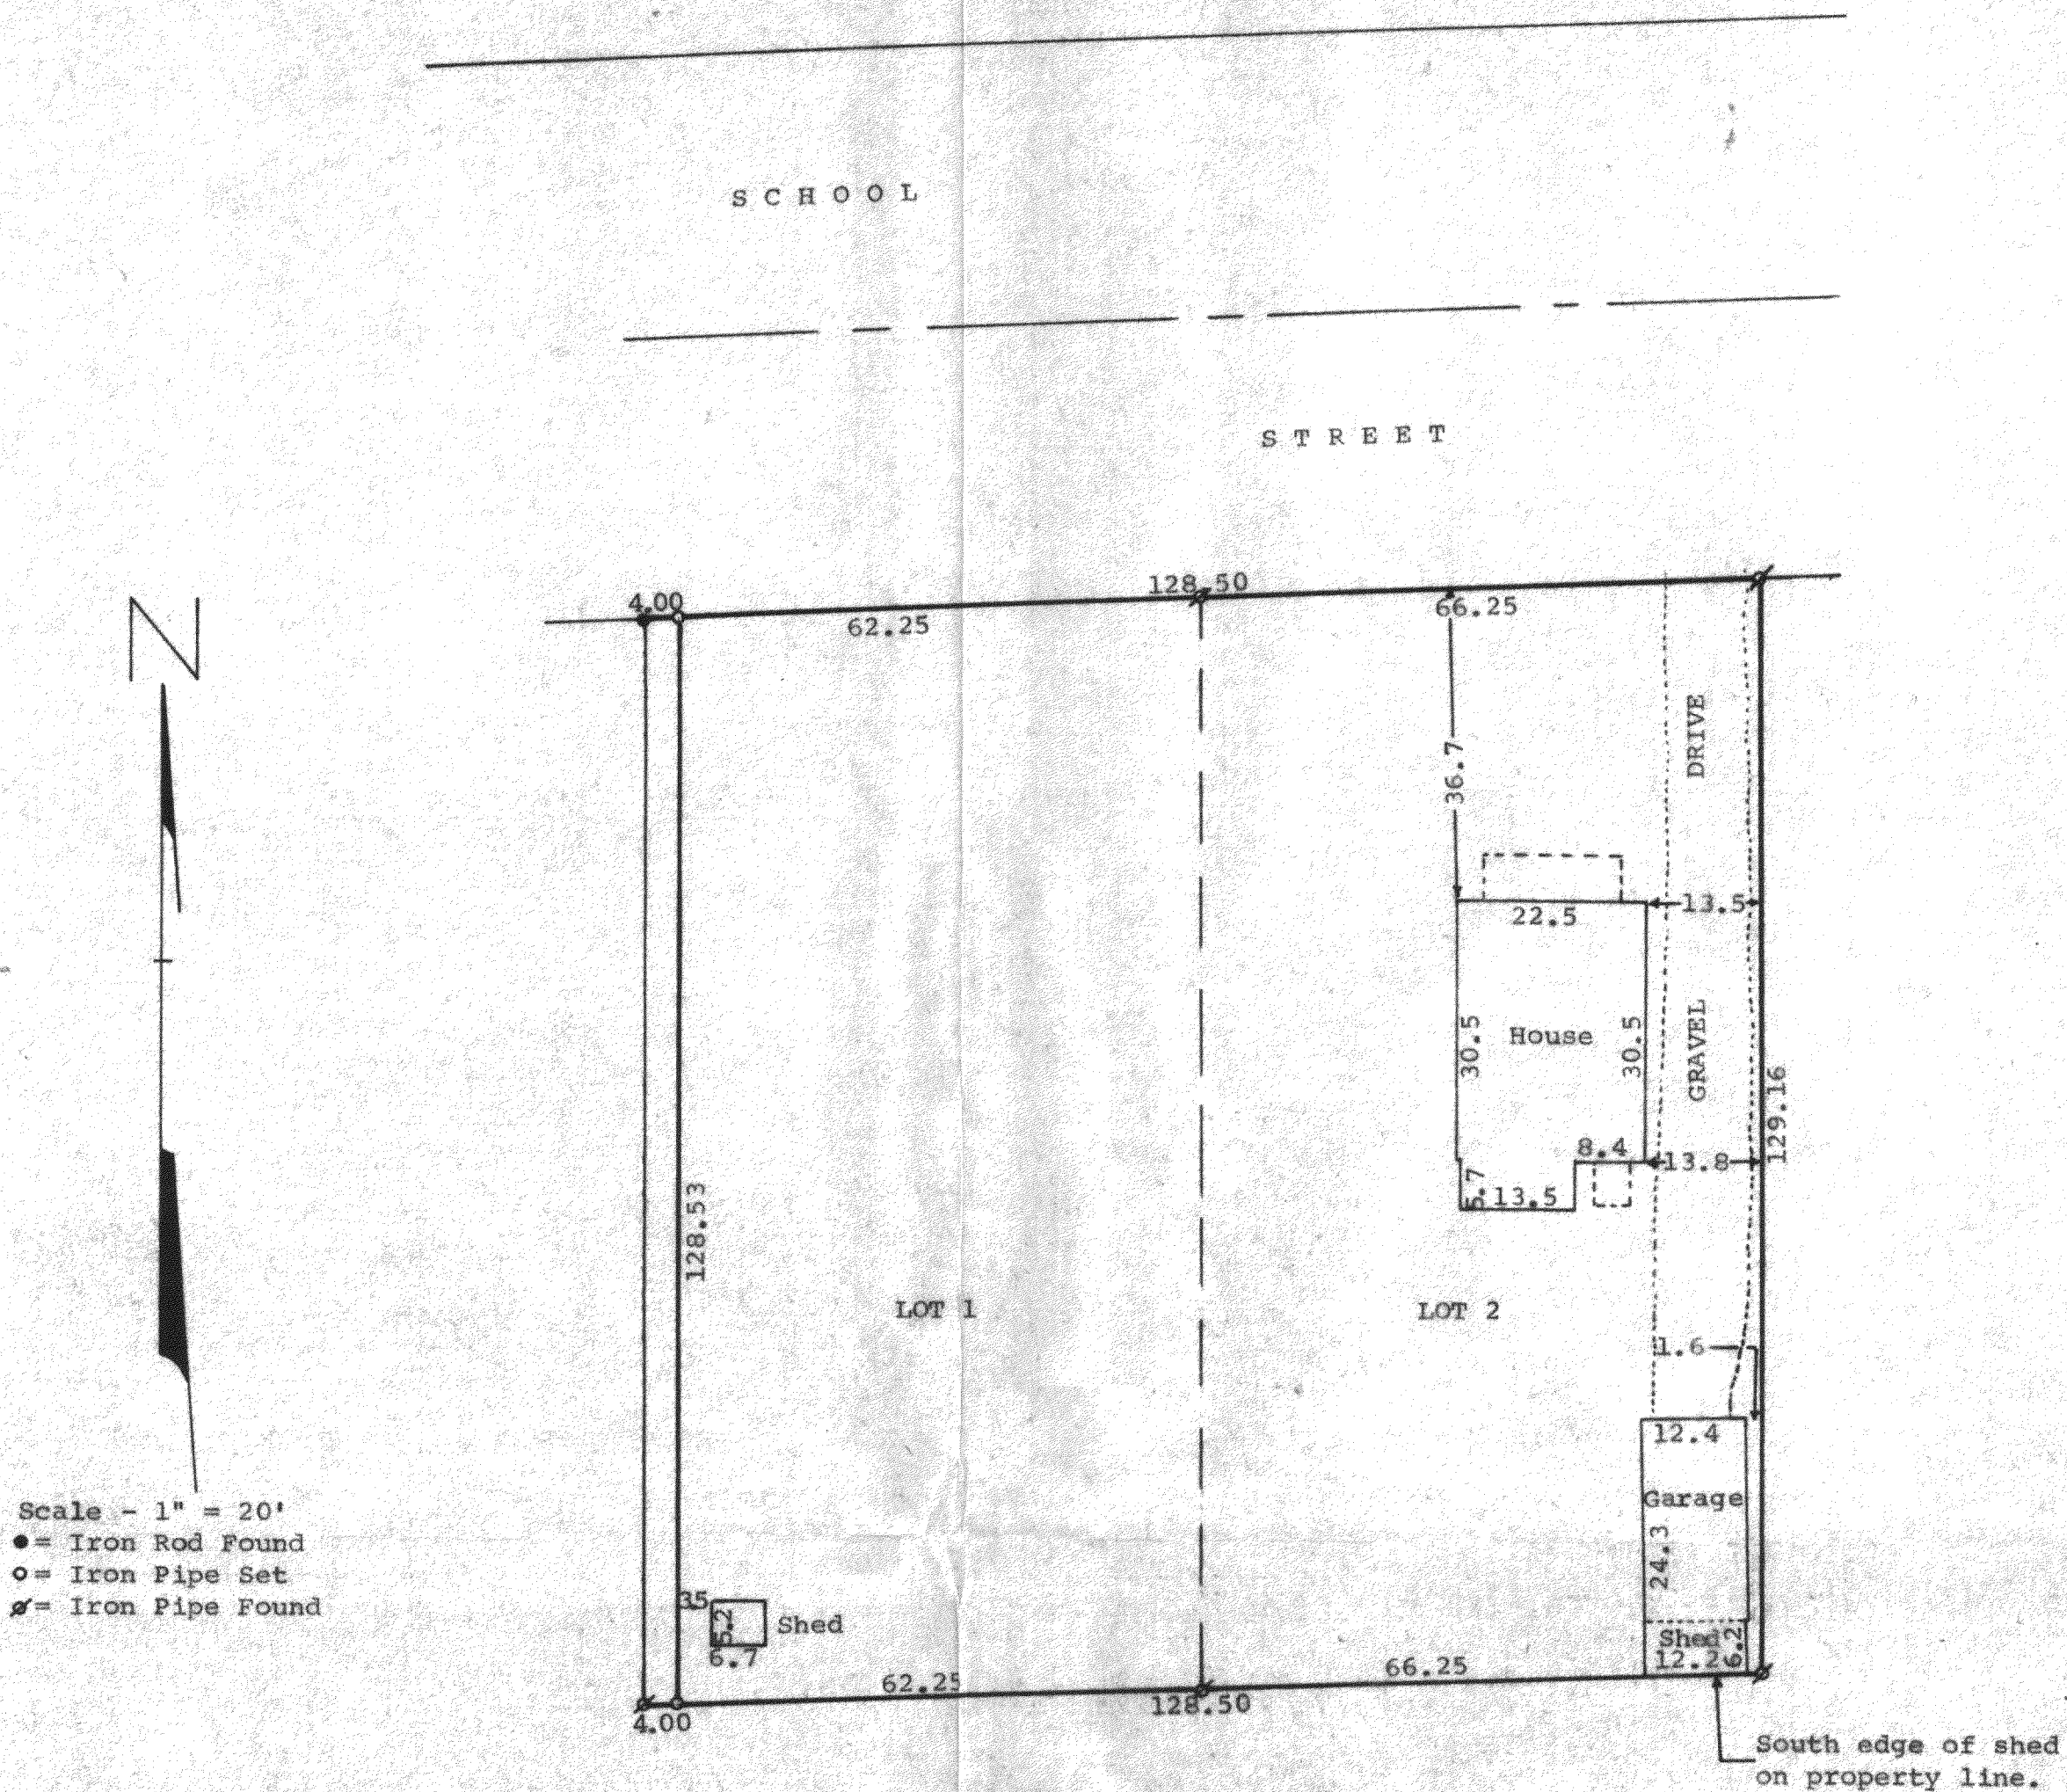

STATE OF WISCONSIN)
COUNTY OF WALWORTH) ss

I, George T. Dunham, Surveyor, certify that I have surveyed the property described as follows,

Lots 1 and 2 of Certified Survey No. 943 recorded in Volume 4 on page 189 of Certified Surveys in and for Walworth County, Wisconsin, EXCEPTING THEREFROM the west 4.00 feet of said Lot 1, said land being located in Lot 29, Block 4 of Citizen's Addition to the Village of Sharon, Walworth County, Wisconsin,

and that the above map is a true representation thereof and shows the size and location of the property, its exterior boundaries, the location of all visible structures and dimensions of all principal buildings thereon, boundary fences, apparent easements, roadways and visible encroachments, if any.

This survey is made for the use of the present owners of the property, and also those who purchase, mortgage, or guarantee the title thereto within one (1) year from date hereof.

December 21, 1979

George T. Dunham
George T. Dunham, Surveyor

