


GEORGE T. DUNHAM
SURVEYING & SUBDIVIDING
DELAVER, WISCONSIN



Plat of survey of Lot 6, Block 1, Wise & Nelson's Addition to the Village of Sharon, Walworth County, Wisconsin.
July 19, 1962

George T. Dunham
George T. Dunham, Surveyor

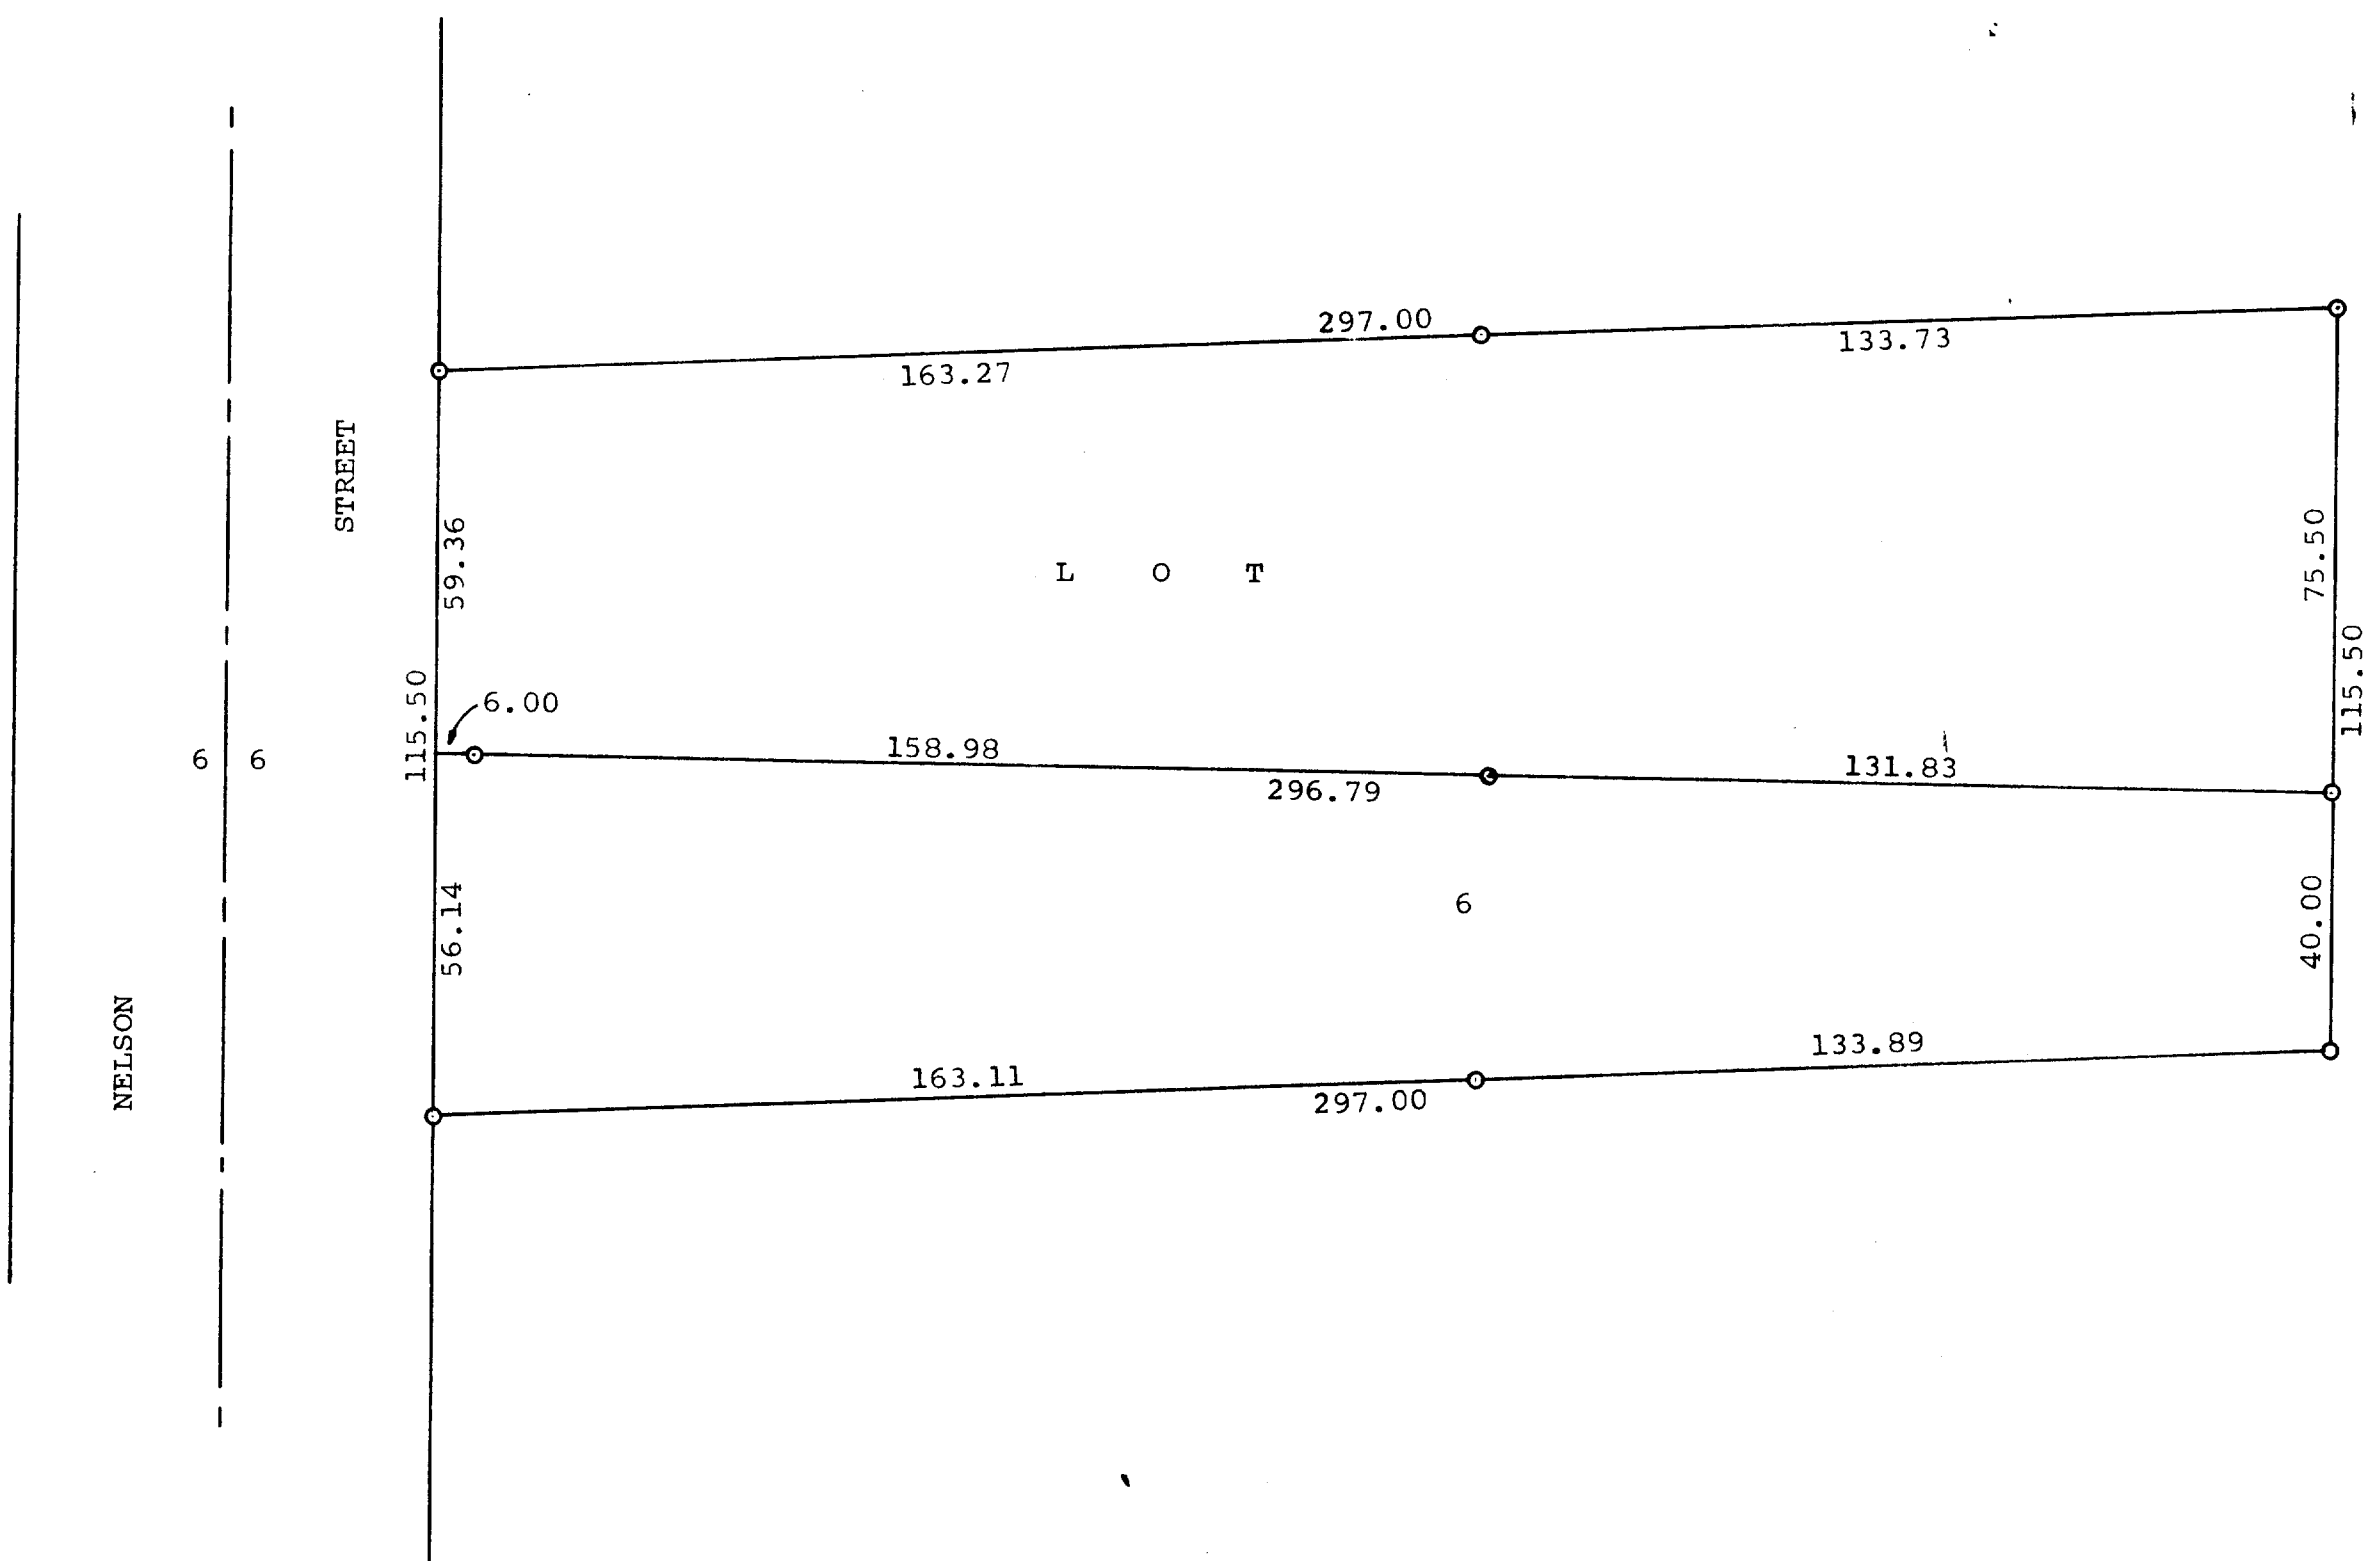

Scale - 1" = 30'
O = Iron Pipe