




NORTH 1/4 CORNER
SECTION 33, 11N, 15E

PLAT OF SURVEY OF
LOT 30, BLOCK 4 OF CITIZENS ADDITION
TO THE VILLAGE OF SHARON, WALWORTH
COUNTY, WISCONSIN.

ORDERED BY: MILBURN TRAVIS
RT. 1 - BOX 32
SHARON, WI. 53585

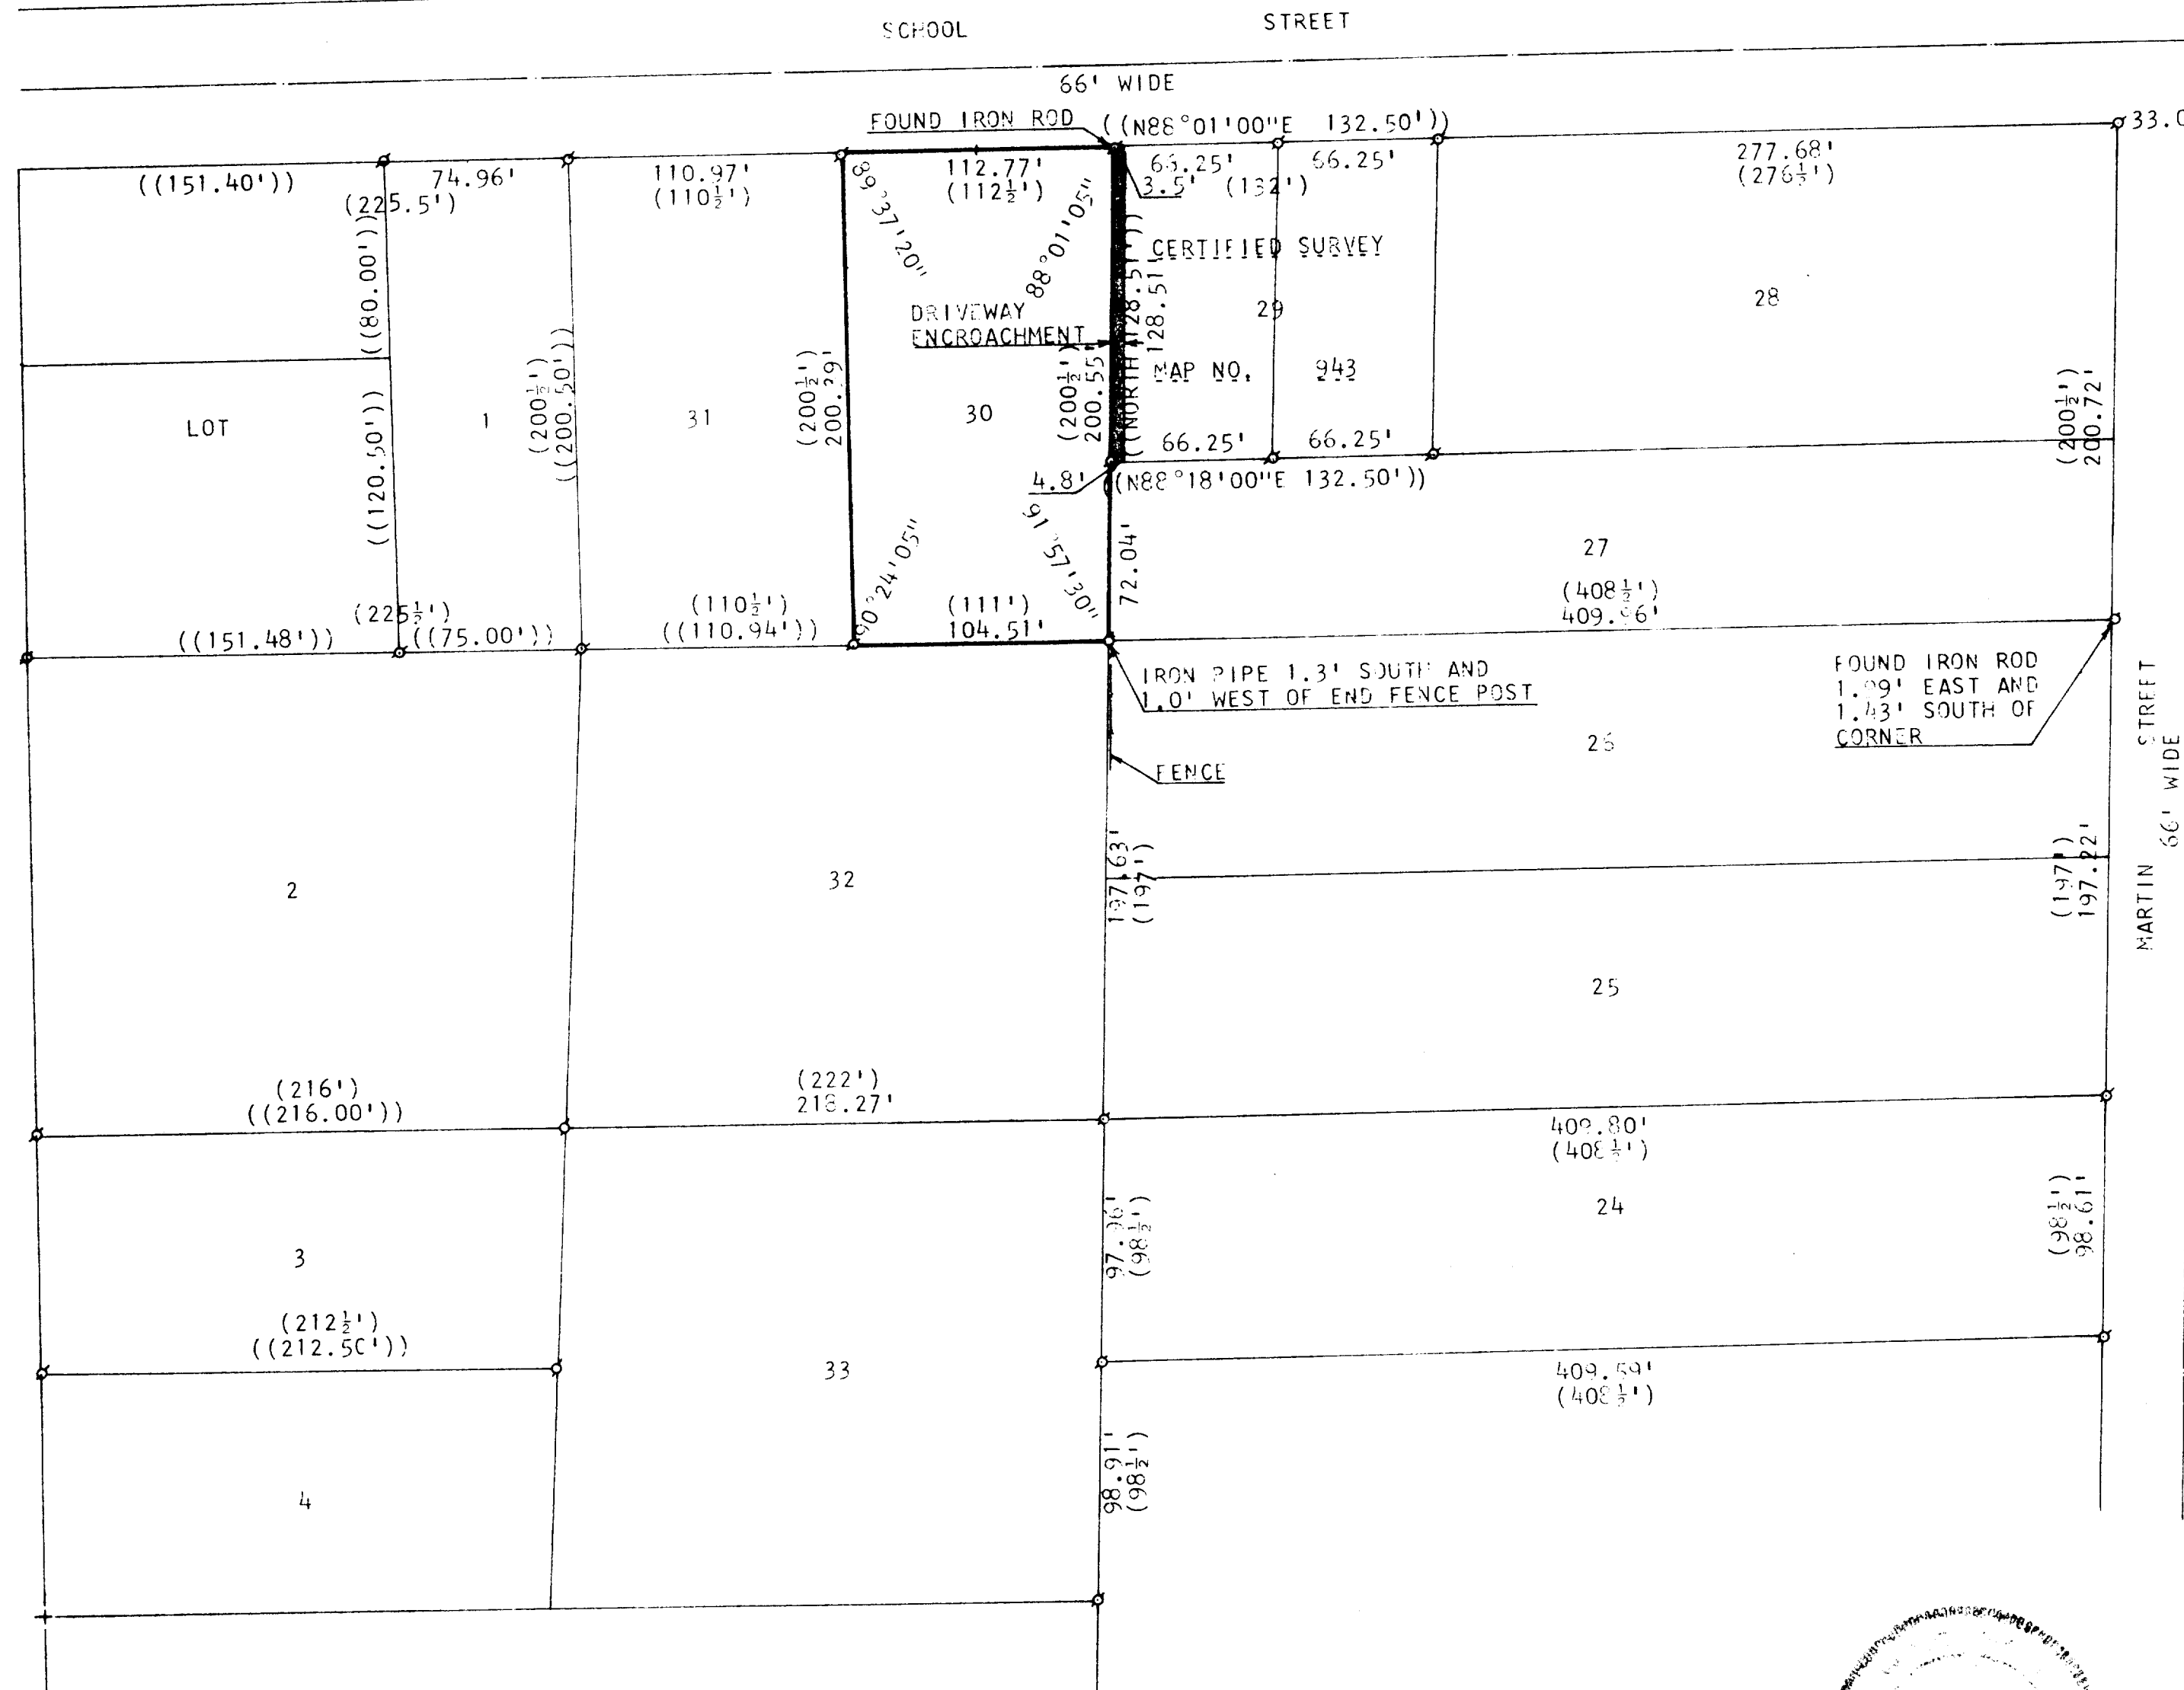

SCALE: 1"=60'

- o - IRON PIPE FOUND (UNLESS OTHERWISE NOTED)
- o - IRON PIPE PLACED
- + - CUT CROSS FOUND
- () - RECORDED AS--VILLAGE OF SHARON PLAT DATED JULY 17, 1894 AND RECORDED ON JULY 21, 1894
- (()) - RECORDED AS--SURVEYS ON FILE AT THE WALWORTH COUNTY SURVEYOR'S OFFICE

I, ROBERT M. BAERENWALD, DO HEREBY CERTIFY THAT I HAVE SURVEYED THE PROPERTY HEREON DESCRIBED ACCORDING TO THE OFFICIAL RECORDS AND THAT THE PLAT HEREON IS A CORRECT REPRESENTATION OF THE PROPERTY LINES TO THE BEST OF MY KNOWLEDGE AND BELIEF.

ROBERT M. BAERENWALD
WISCONSIN REGISTERED LAND SURVEYOR, S-1508

DATE Aug 26, 1974