

DUNHAM SURVEYING, S.C.
SURVEYING & SUBDIVIDING
DELAVAN, WISCONSIN 53115


SCHOOL

STREET

STREET

NELSON

N

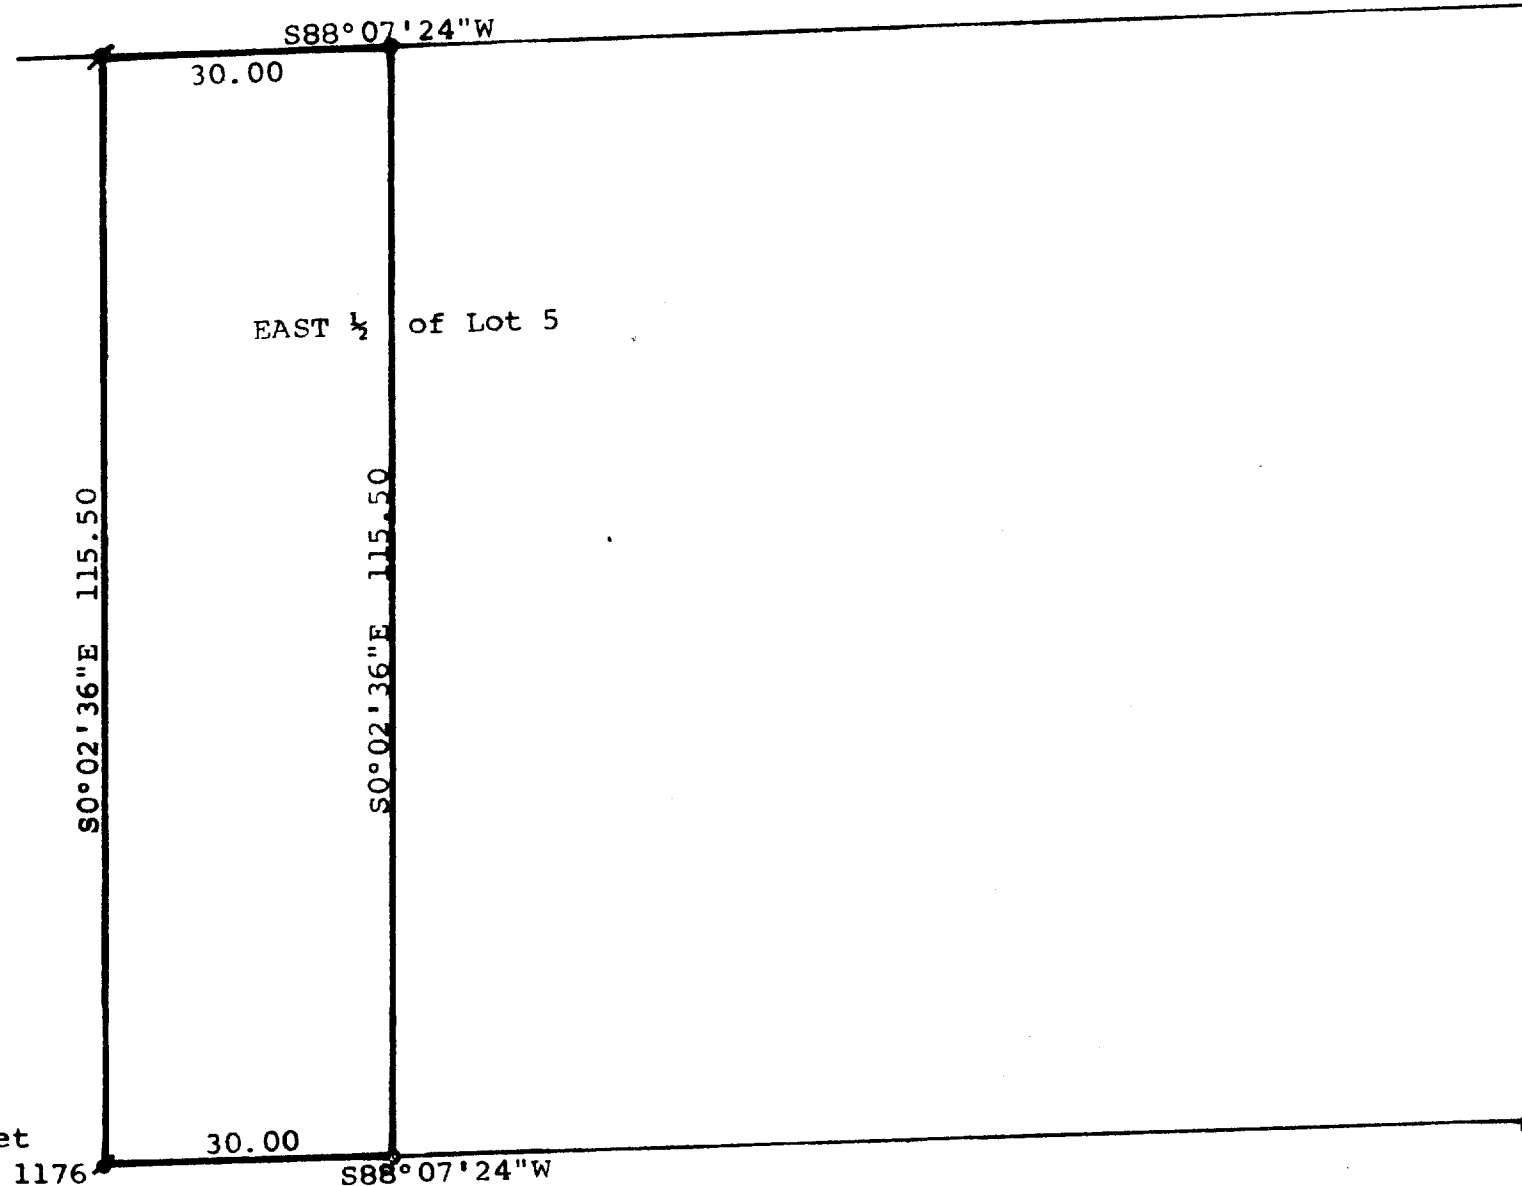

Scale - 1" = 20'

■ = Iron Pipe Found

● = 1 1/4" X 2' Iron Pipe Set

Bearings are from CSM No. 1176

Owner: James Swaney
247 Nelson Street
Sharon, WI 53585

STATE OF WISCONSIN) SS
COUNTY OF WALWORTH)

I, George T. Dunham, Surveyor, certify that I have surveyed
the property described as follows:


The West 30.00 feet of the East 1/2 of Lot 5, Block 3 of
Wise & Nelson's Addition to the Village of Sharon, Walworth
County, Wisconsin,

and that the above map is a true representation thereof and shows
the size and location of the property, its exterior boundaries, the
location of all visible structures and dimensions of all principal
buildings thereon, boundary fences, apparent easements, roadways and
visible encroachments, if any.

This survey is made for the use of the present owners of the property,
and also those who purchase, mortgage, or guarantee the title thereto
within one (1) year from date hereof.

Nov. 16, 1982

George T. Dunham
George T. Dunham, Surveyor

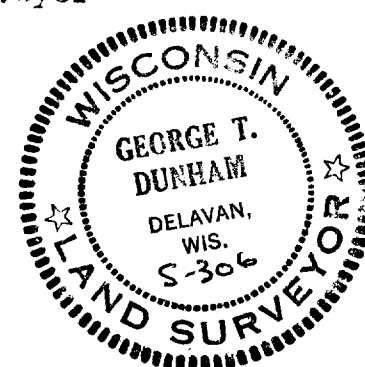

Pt UWNA-28