


KOLB LAND CONSULTING, INC.
LAND SURVEYING • SUBDIVIDING • LAND PLANNING

LAKE GENEVA, WISCONSIN 53147

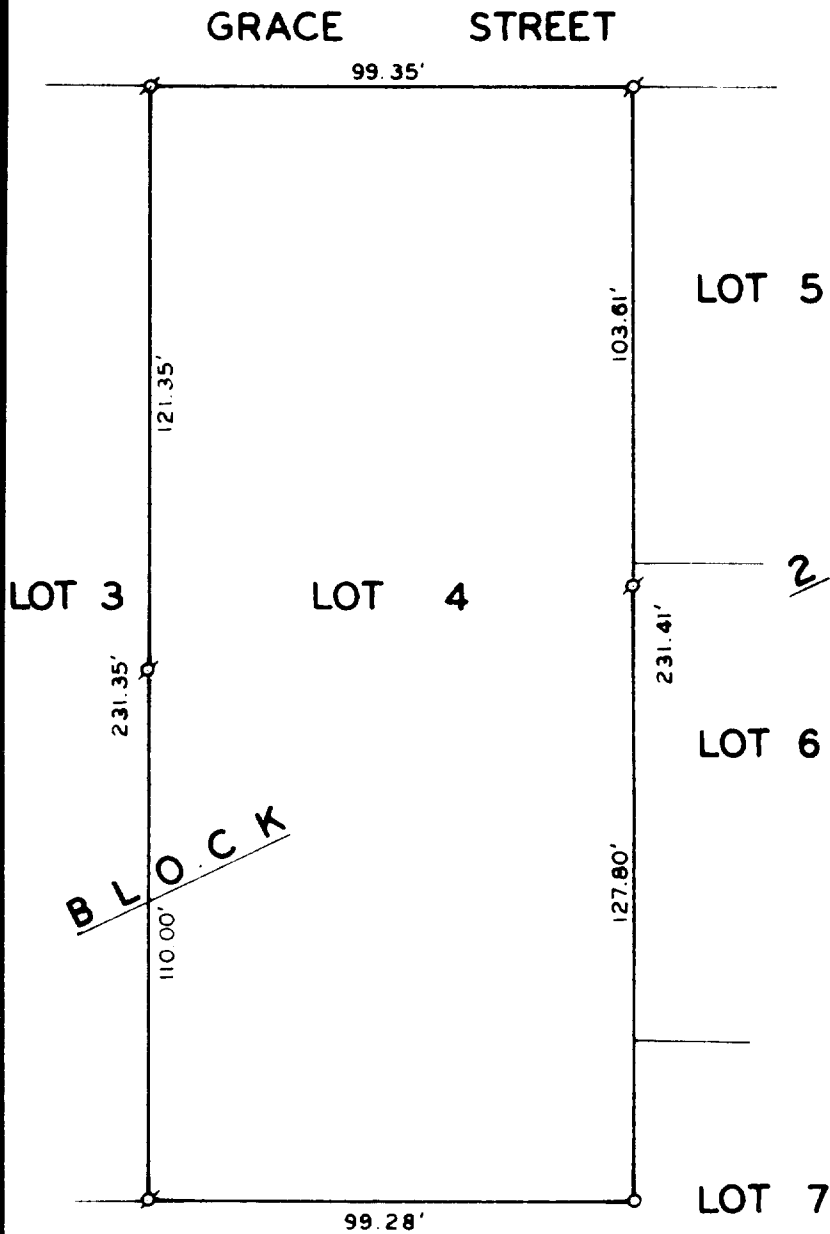

THE RELATIONSHIP OF PROPERTY
CORNER OF LOT 4, SHARON LAND
IMPROVEMENT CO. SUBDIVISION,
VILLAGE OF SHARON, WALWORTH
COUNTY, WISCONSIN.

PREPARED BY: HAROLD W. KOLB
110 TRALE STREET
SHARON, WI

NOTE: THIS MAP IS A REPRODUCTION
OF A PREVIOUS EDITION.
REVISIONS.



SCALE 1" = 40'

LEGEND
o - IRON PIPE FOUND
o - IRON PIPE SET

Harold W. Kolb

HAROLD W. KOLB
WISCONSIN REGISTERED LAND SURVEYOR, S-147
DATE NOVEMBER 2, 1987

USLI-11

8-97✓

Sharon USLI-11