


DUNHAM SURVEYING, S.C.
SURVEYING & SUBDIVIDING
DELAVER, WISCONSIN 53115

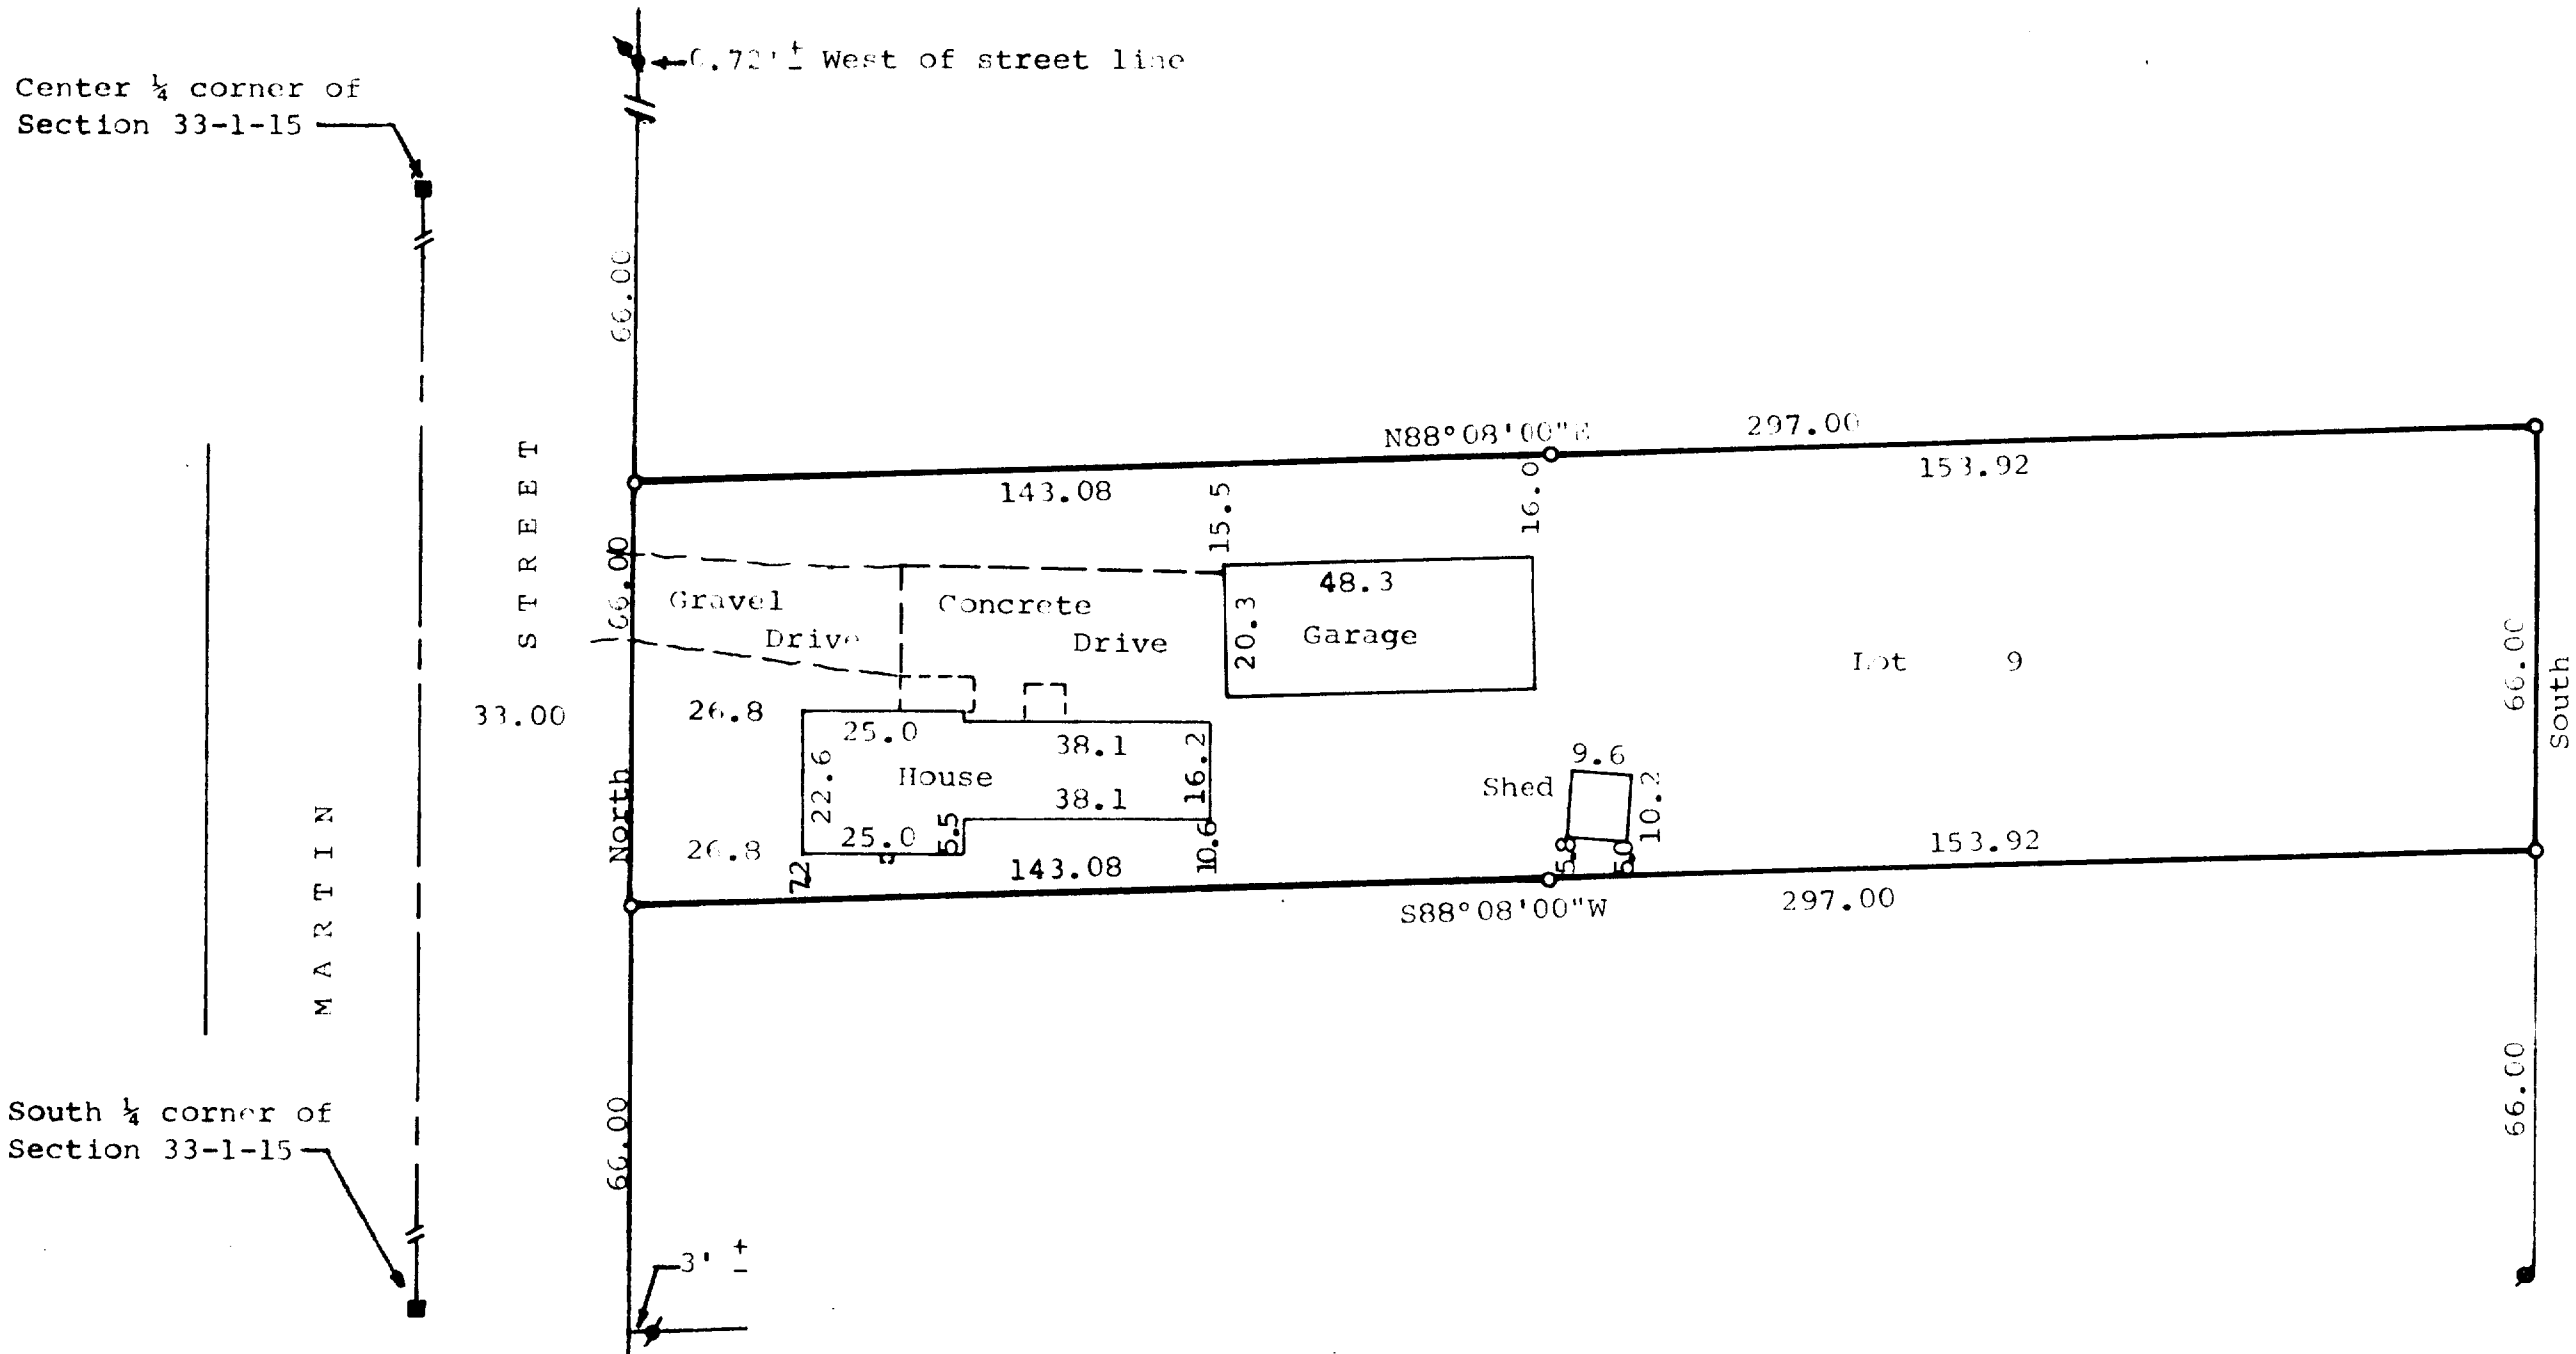

STATE OF WISCONSIN)
COUNTY OF WILWORTH)


I, George T. Dunham, Surveyor, certify that I have surveyed the property described as follows:

Lot 9 in Block 8 of Citizens Addition to the Village of Sharon, Wilworth County, Wisconsin,

and that the plot shown above is a true representation thereof and shows the size and location of the property, its exterior boundaries, the location of all visible structures and dimensions of all principal buildings thereon, boundary fences, apparent easements, roadways and visible encroachments, if any, and that I have surveyed the property hereon described according to the official records, to the best of my knowledge and belief.

June 9, 1984

George T. Dunham
George T. Dunham, Surveyor

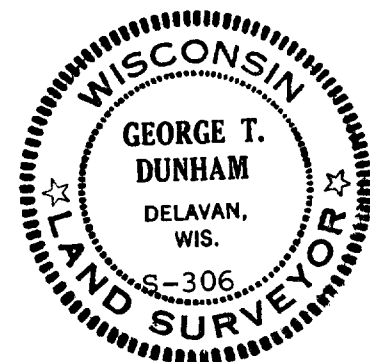

Scale - 1" = 30'

- = County Concrete Monument Found
- ▼ = 3/4" Iron Pipe Found
- = 1/2" Iron Pipe Found
- = 3/4" x 24" iron pipe Set

Bearings referenced to the centerline of Martin Street with the assumed bearing of North

Owner: Walter Klein
160 Martin Street
Sharon, WI. 53585