


FOUND ANOTHER PIPE
N 70°30'E 6.21' FROM
CORNER USED

SCHOOL STREET

FOUND PIPE S 88°E 5.69' FROM
BLOCK CORNER

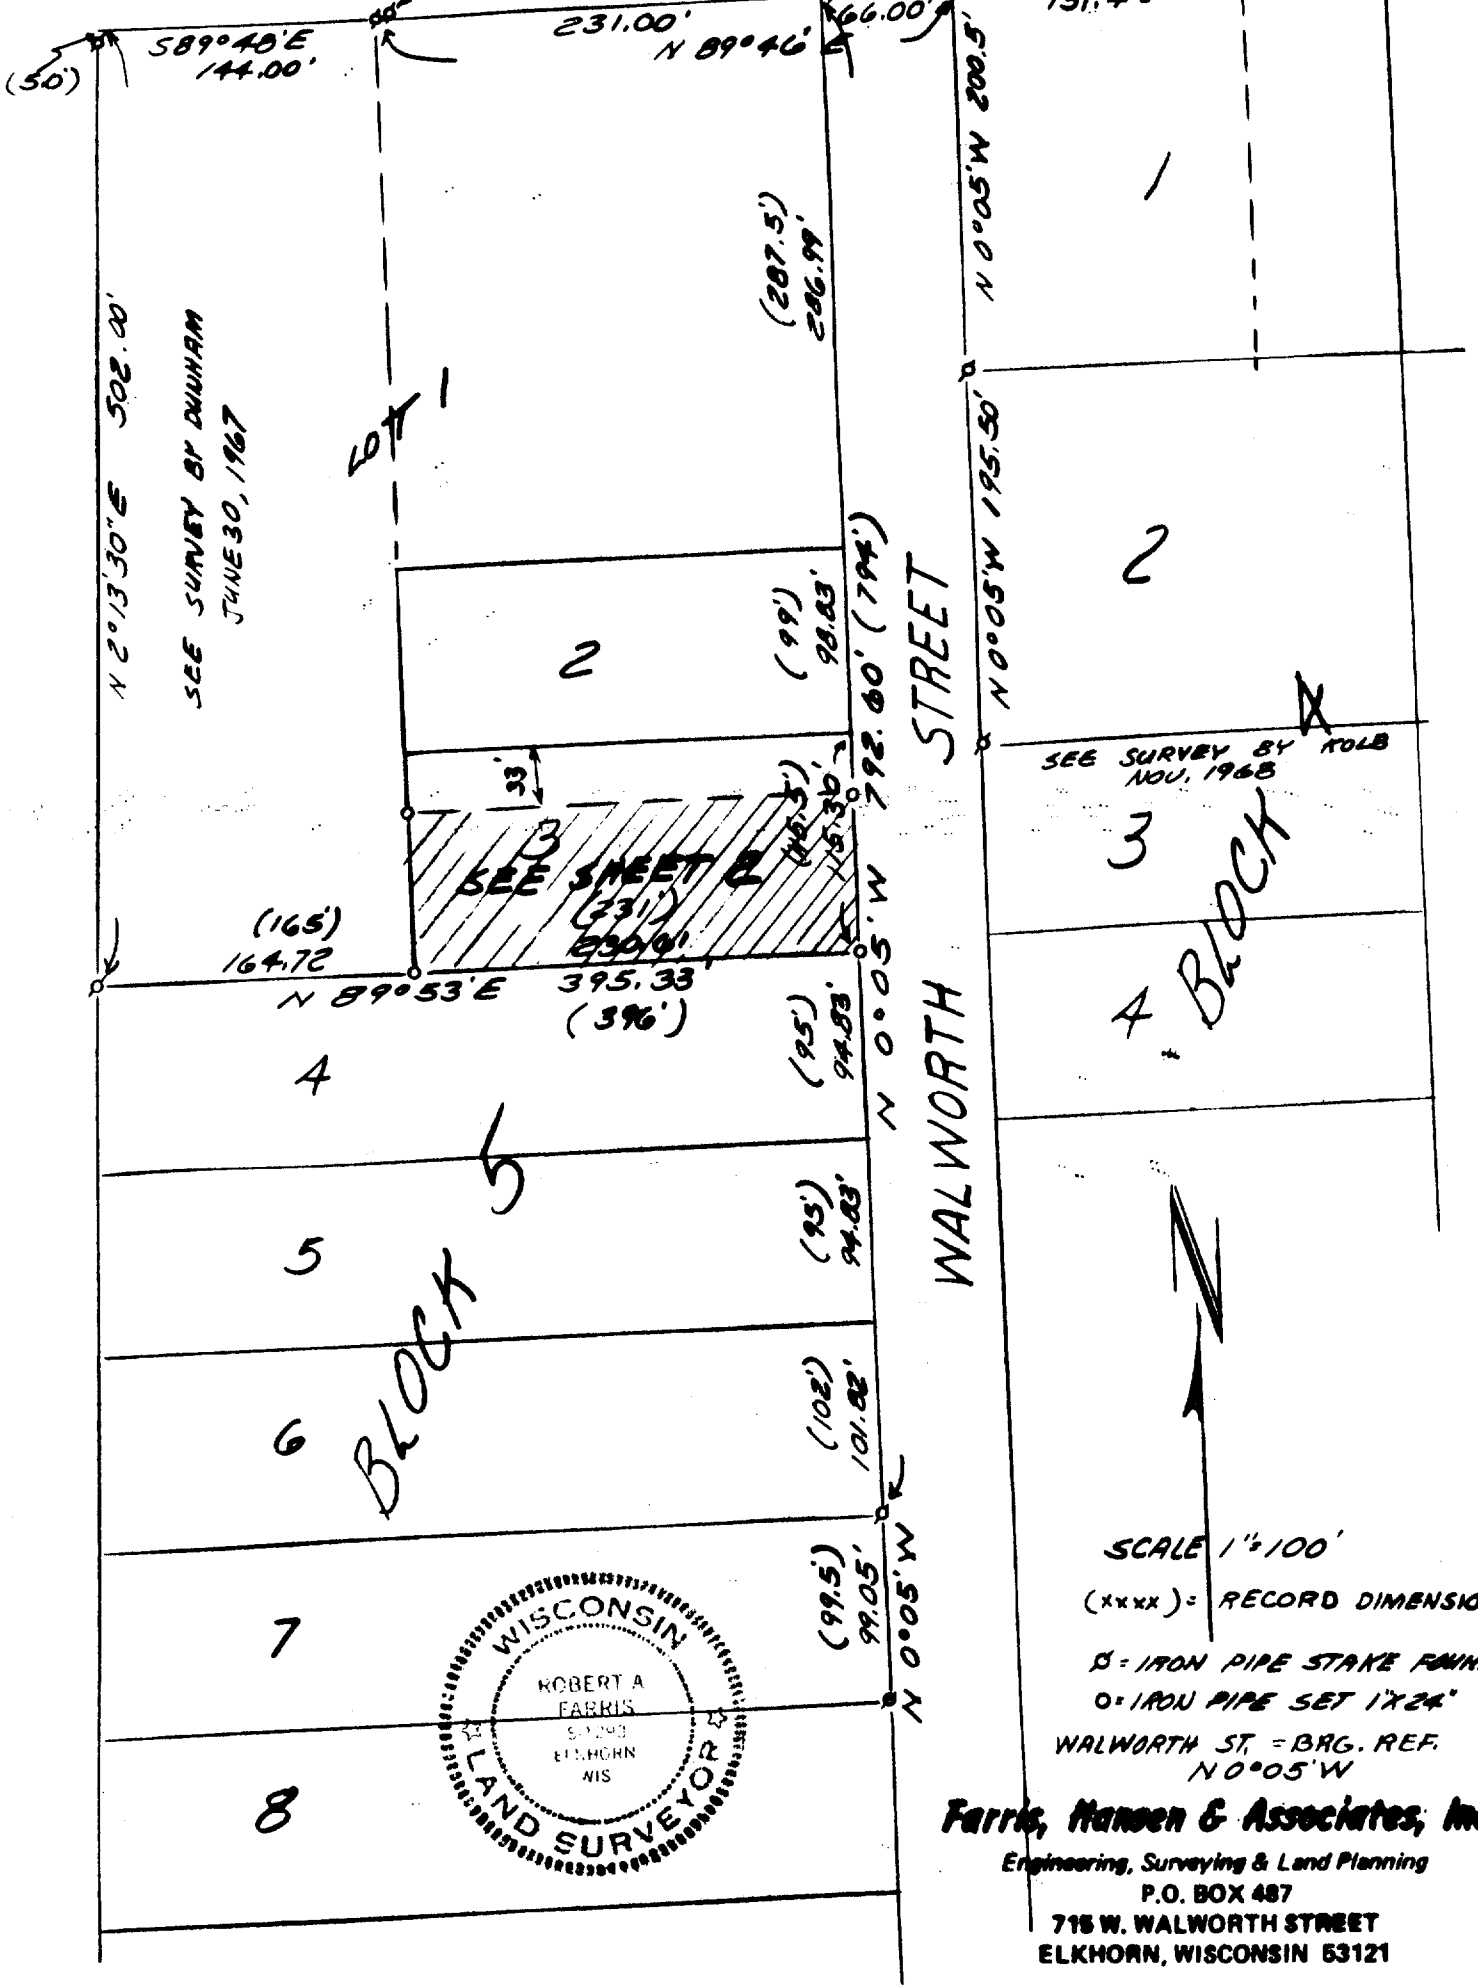

PLAT OF SURVEY OF LOT 3 OF BLOCK 5 OF CITIZENS ADDITION TO THE VILLAGE OF SHARON, WALWORTH COUNTY, WISCONSIN EXCEPTING THE NORTH 33 FEET OF SAID LOT 3

I hereby certify that at the direction of Donald Weig that I have surveyed the property described hereon and that this Plat of Survey is a true and accurate representation of the lot lines and building locations to the best of my professional knowledge and belief.

Robert A. Farris
Robert A. Farris RLS

Dated October 6, 1984

SHEET 1 OF 2
Project No. 2306

UCA-00082-

8-99v

WALWORTH ST.

SIDEWALK

33.00'

N 0°05'W 82.30'
(82.5')

Lot 3
115.30'
(115.5')

PORCH

RESIDENCE

PORCH

BITUMINOUS DRIVE

N 89°53'E 230.61'
(231')

28.4'

GARAGE
(BARN)

2.0'

WALWORTH ST. N 0°05'W

MAP SCALE 1"=20'

(xxx) = RECORD DIMENSION

o = SET IRON PIPE STAKE 1"x24"

Farris, Hansen & Associates, Inc.

Engineering, Surveying & Land Planning

P.O. BOX 487

715 W. WALWORTH STREET

ELKHORN, WISCONSIN 53121

NORTH LINE OF LOT 3 OF BLOCK 5 OF CITIZENS ADD.
(231')

Lot 2
Lot 3

Lot 3

Lot 4

33.00'

17'

N 0°05'W 82.30'
(82.5')
FENCE 0.2' EAST OF LINE

0.7'

