


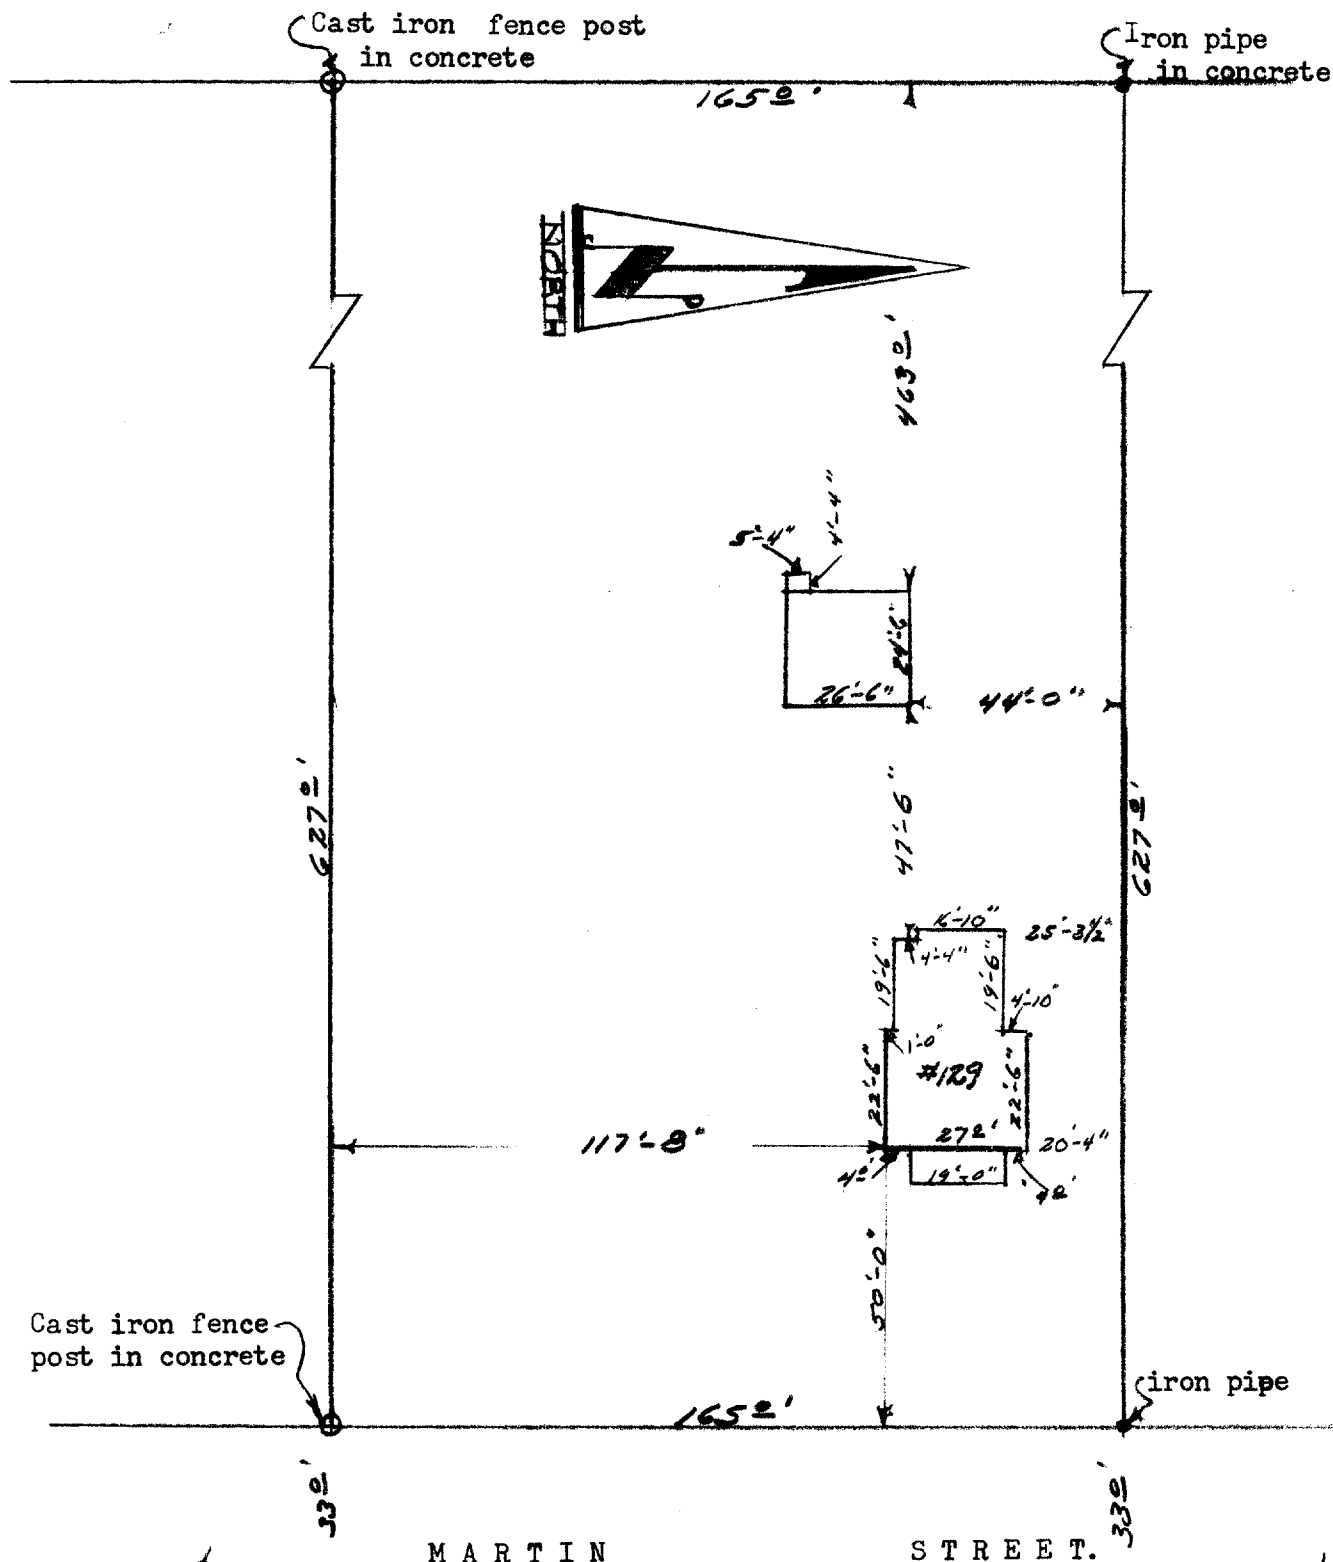

Cast iron fence post in concrete

iron pipe

DESCRIPTION: The south one-half of the north one-half of Lot 28 Block 9 of Citizens Addition to the Village of Sharon Walworth County, Wisconsin.

CERTIFICATE: I, James F. Biagi, surveyor do hereby certify that I have surveyed the property hereon described and that the location of the improvements are as shown.

May 17th 1965.

James F. Biagi, RLS 292.
Elkhorn, Wisconsin.

