

FARRIS, HANSEN & ASSOCIATES, INC.


ENGINEERING — ARCHITECTURE — SURVEYING
 7 RIDGWAY COURT — P.O. BOX 437 — ELKHORN, WISCONSIN 53121
 PHONE: (262) 723-2098 FAX: (262) 723-5886

PLAT OF SURVEY

LOT 2, BLOCK 2 OF BIGFOOT RIDGE OF WALWORTH
 LOCATED IN THE VILLAGE OF WALWORTH,
 WALWORTH COUNTY, WISCONSIN


— WORK ORDERED BY —
 WALTER MOONEY
 410 BRENNAN DRIVE
 WALWORTH, WI 53184

ASSIGNED EAST LINE OF LOT 2, BLOCK 2
 OF BIGFOOT RIDGE OF WALWORTH
 N 03°47'36" W

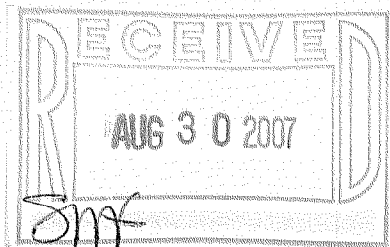

SUMMER DRIVE {66' WIDE R.O.W.}

BRENNAN DRIVE {66' WIDE R.O.W.}

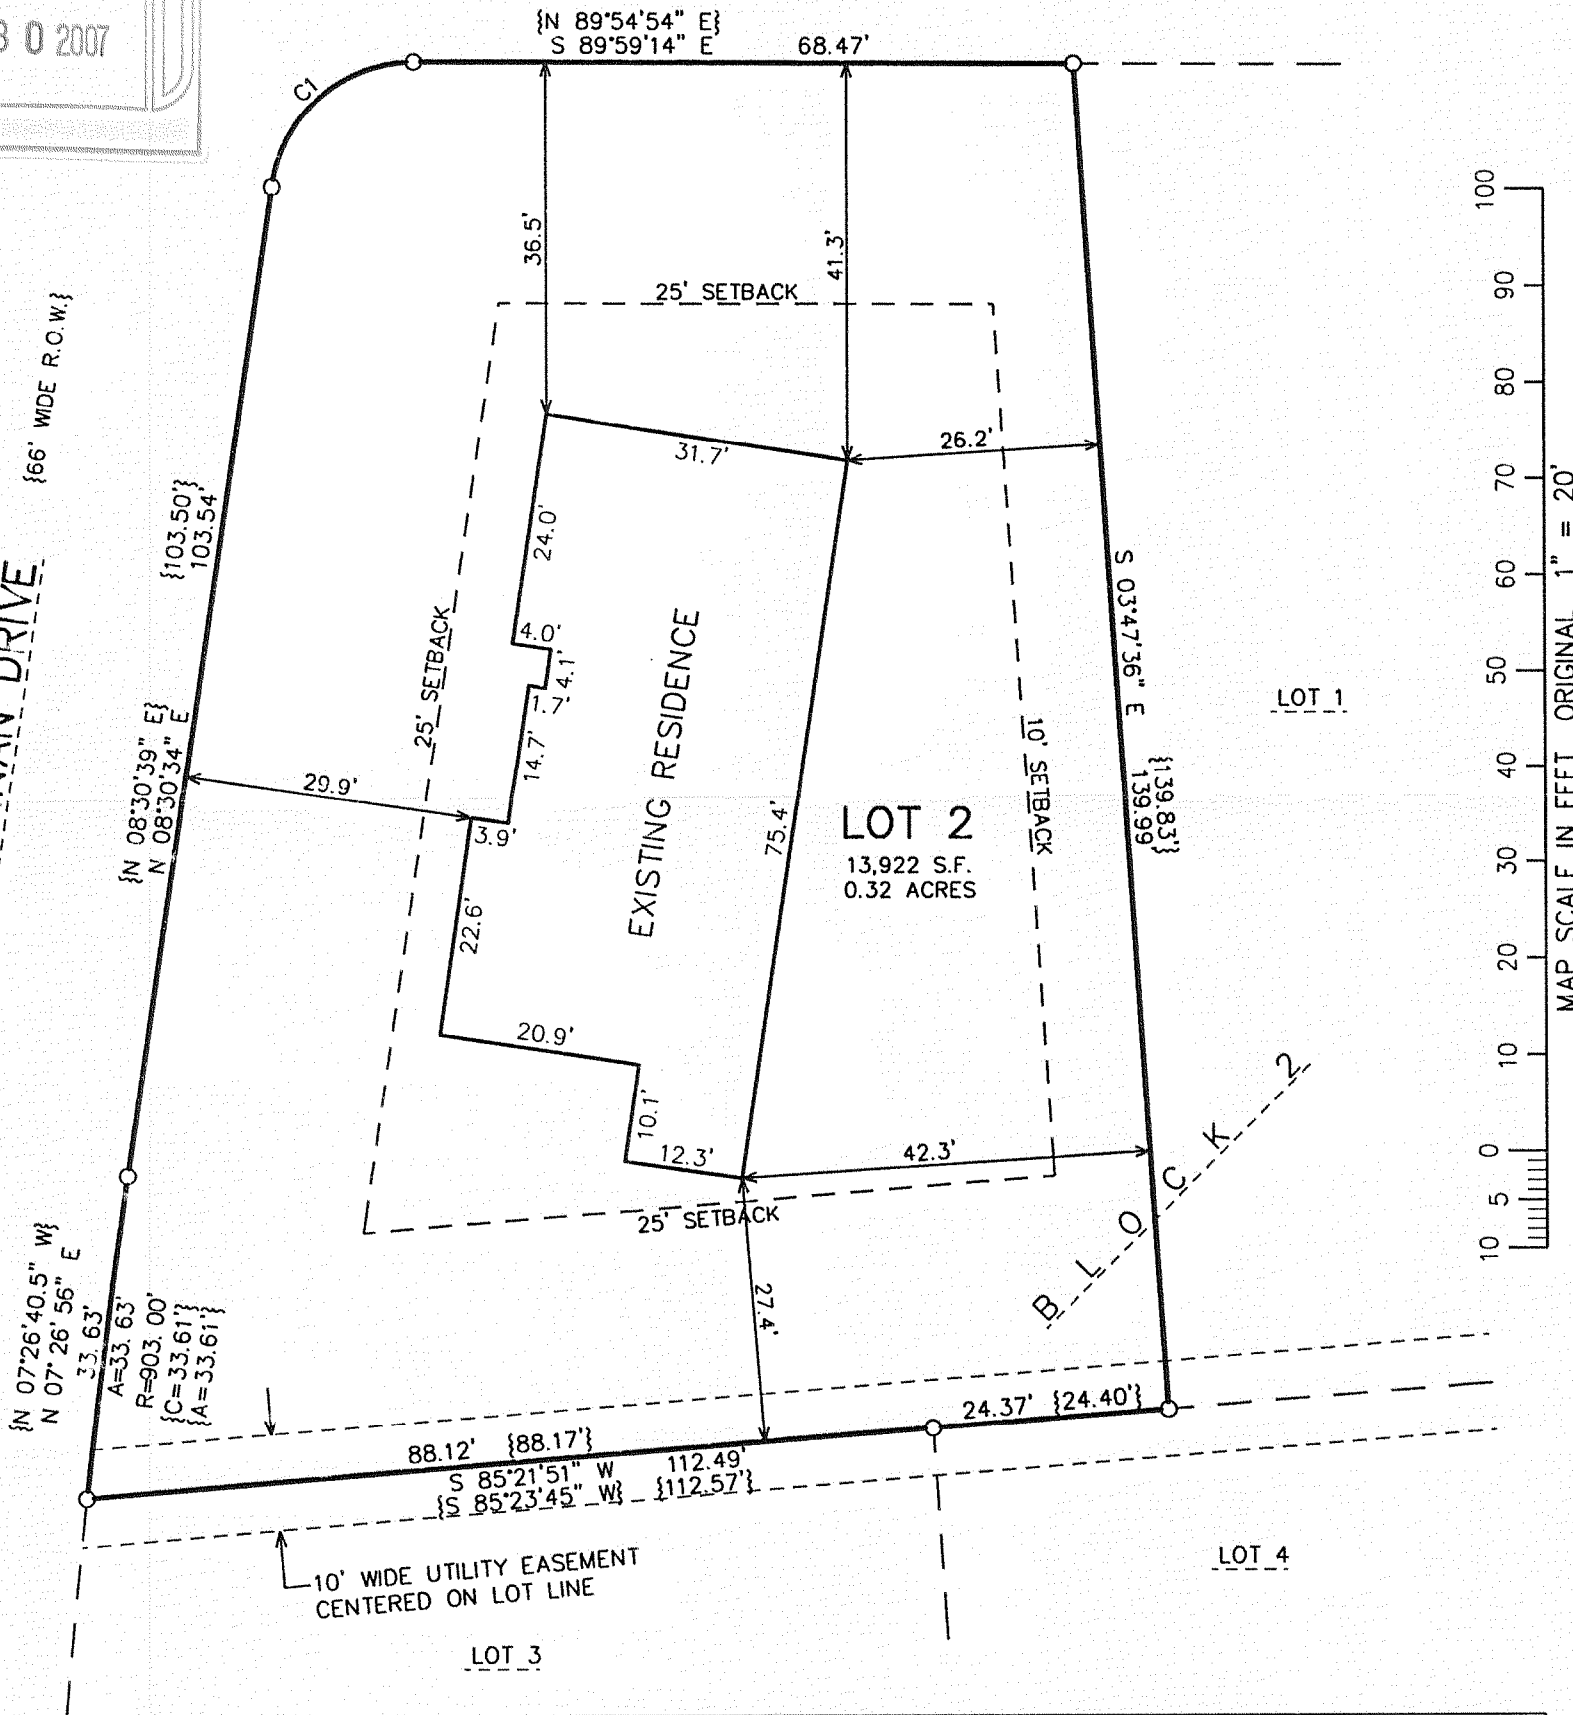


CURVE	ARC	RADIUS	CHORD LENGTH	CHORD BEARING
C1	21.44'	15.00'	19.66'	N 48°27'18" E
	{21.31}'		{19.56}'	{N 49°12'46.0" E}

NOTE: COPIES OF THIS MAP TO WHICH THE FOLLOWING CERTIFICATE WILL APPLY SHOW THE SURVEYOR'S ORIGINAL SEAL AND SIGNATURE IN RED INK. COPIES BY ANY OTHER MEANS MAY HAVE ALTERATIONS WHICH DO NOT REPRESENT THE SURVEYOR'S WORK PRODUCT.

I HEREBY CERTIFY THAT THE ABOVE DESCRIBED PROPERTY HAS BEEN SURVEYED UNDER MY DIRECTION AND THAT THE ABOVE MAP IS A TRUE REPRESENTATION THEREOF AND SHOWS THE SIZE AND LOCATION OF THE PROPERTY AND ITS EXTERIOR BOUNDARIES. THIS SURVEY IS MADE FOR THE USE OF THE PRESENT OWNERS OF THE PROPERTY, AND ALSO THOSE WHO PURCHASE, MORTGAGE, OR GUARANTEE THE TITLE THERETO WITHIN ONE YEAR FROM THE DATE HEREOF.

DATED: AUGUST 14, 2007

Peter S. Gordon
 PETER S. GORDON R.L.S. 2101

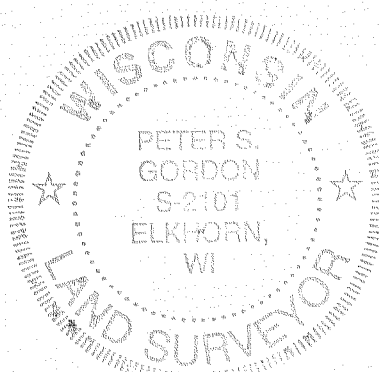

LEGEND
 O = FOUND IRON PIPE STAKE
 {XXX} = RECORDED AS

PROJECT: 3271.02.02
 DATE: 08/14/2007
 SHEET 1 OF 1

AUG 20 2007 VBIG - 11

009-1058

8/14/2007 X:\Projects\3271\lock_2\Lot_2\Doc\SURVEY_20070814