

LAND-MARK SURVEYING

Mark L. Miritz

Wisconsin Professional Land Surveyor S-2582



N9330 Knuteson Drive
Whitewater, WI 53190
Phone: (262) 495-3284
MARKMIRITZ@
LAND-MARKSURVEYING.COM

PLAT OF SURVEY

LOT 4 OF GLENN T. JOHNSON SUBDIVISION LOCATED
IN THE NORTHWEST 1/4 OF SECTION 22, TOWN 1 NORTH,
RANGE 16 EAST, VILLAGE OF WALWORTH, WALWORTH
COUNTY, WISCONSIN.

ORDERED BY:
BECKY MERWIN
RAULAND AGENCY INC.
118 KENOSHA STREET
WALWORTH, WI 53184

SITE ADDRESS: 225 GRACE STREET, WALWORTH, WI

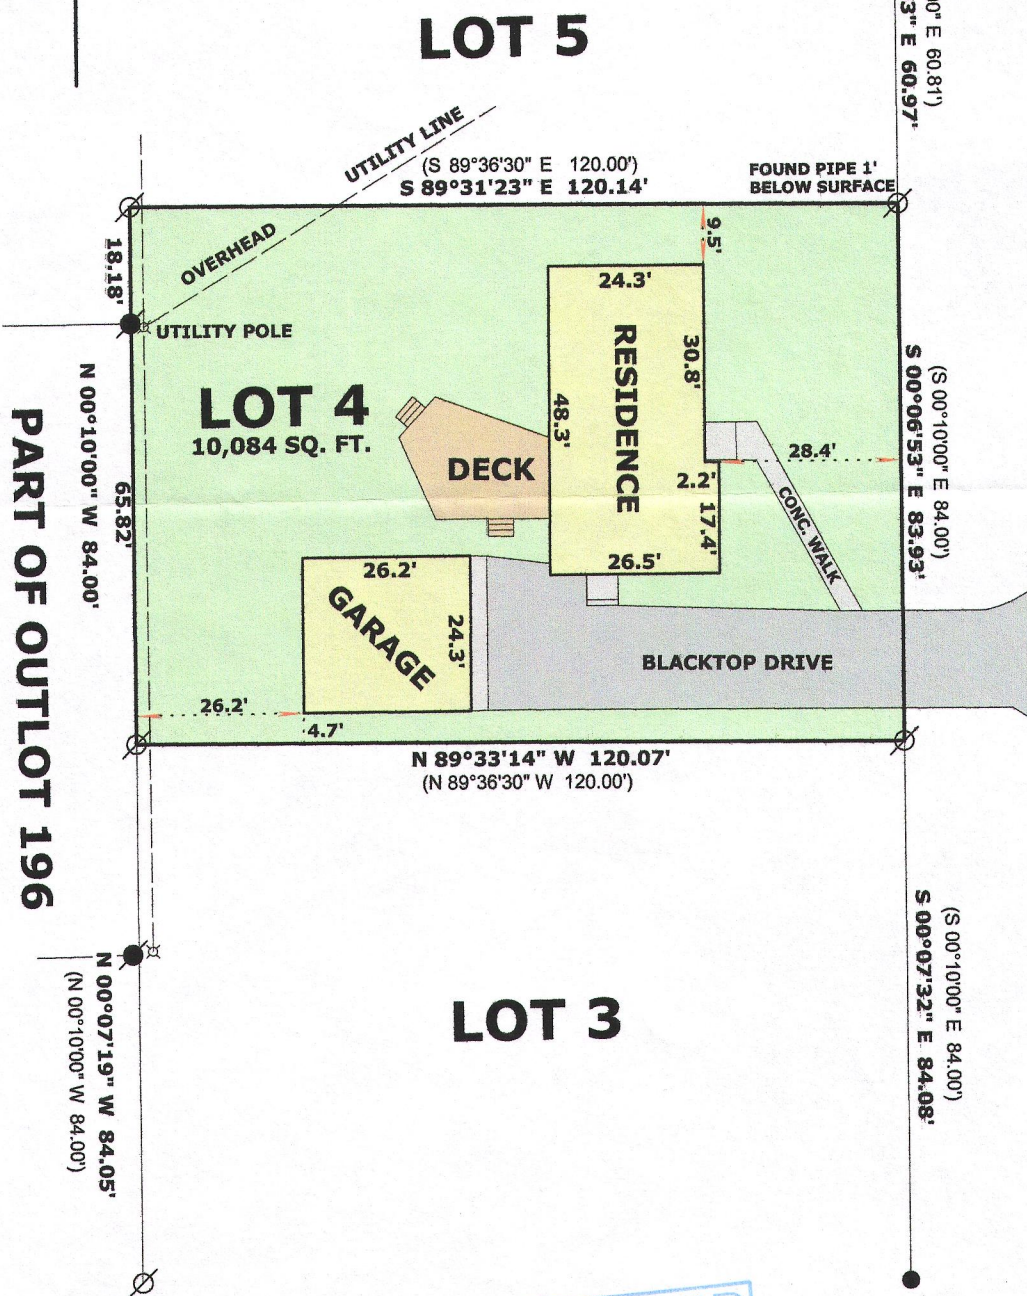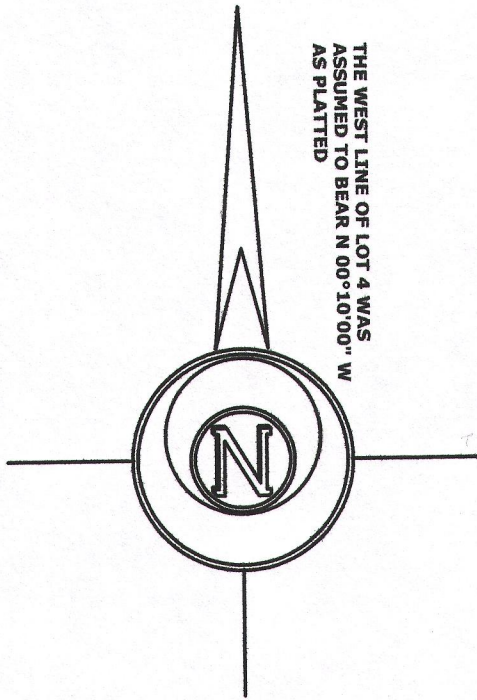

LEGEND

- FOUND IRON PIPE 1 1/2"
- FOUND IRON ROD 1"
- FOUND IRON ROD 3/4"
- (xx) RECORDED AS DIMENSION



SCALE: 1 INCH = 30 FEET

"I hereby certify that the above described property has been surveyed by me or under my direction and that the above map is a true representation thereof and shows the size and location of the property, its exterior boundaries, the location of all visible structures and dimensions of all principal buildings thereon, boundary fences, apparent easements, roadways and visible encroachments, if any."
"This survey is made for the use of the present owners of the property, and also those who purchase, mortgage, or guarantee the title thereto within one year from date hereof."

Mark L. Miritz
MARK L. MIRITZ
WISCONSIN PROFESSIONAL
LAND SURVEYOR S-2582

VG TJ-4 009-1229

DATE: 10/10/15 JOB NO. 151005