


O. L. 118

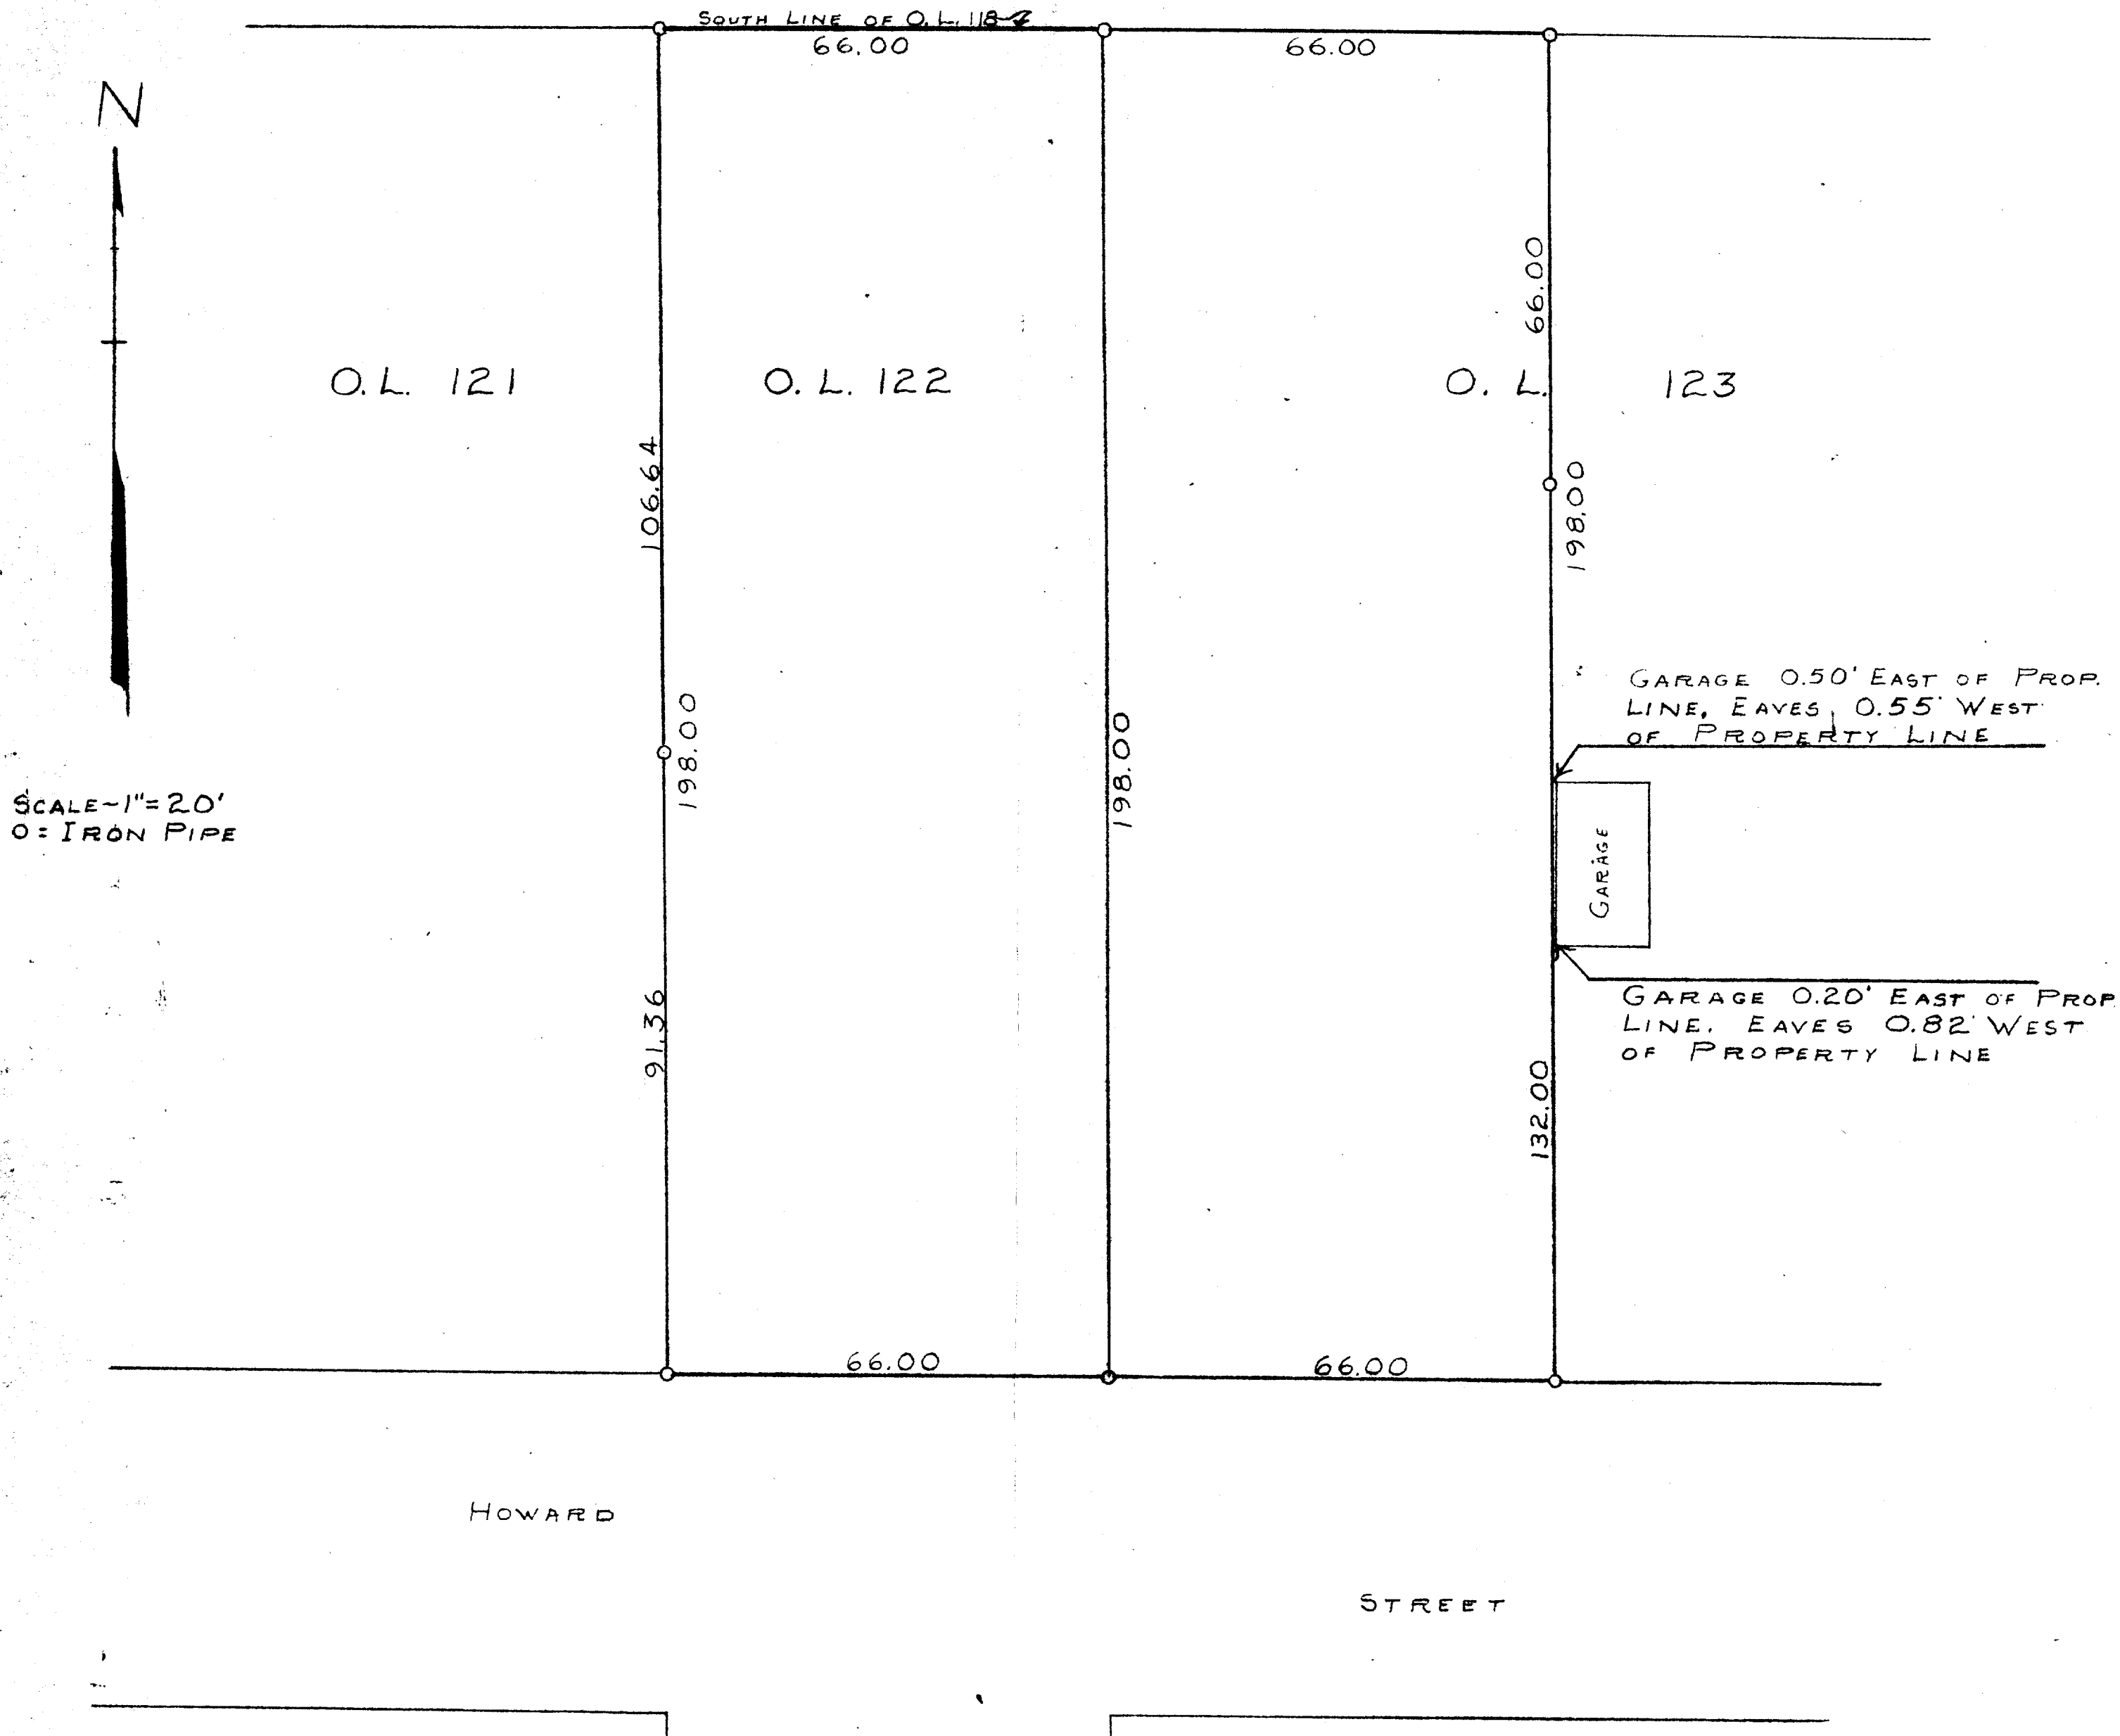

PLAT OF SURVEY OF OUTLOT 122 AND THE WEST 66' OF OUTLOT 123
LOCATED IN THE VILLAGE OF WALWORTH, WALWORTH COUNTY, WISCONSIN
OCTOBER 1952

George F. Dunham
SURVEYOR

9-1