


HAROLD H. KOLB
REGISTERED PROFESSIONAL LAND SURVEYOR
LAKE GENEVA, WISCONSIN




PLAT OF SURVEY OF

**Lot 4, Block 1, Crandall and Swinney's
 Subdivision, Village of Walworth,
 Walworth County, Wisconsin.**

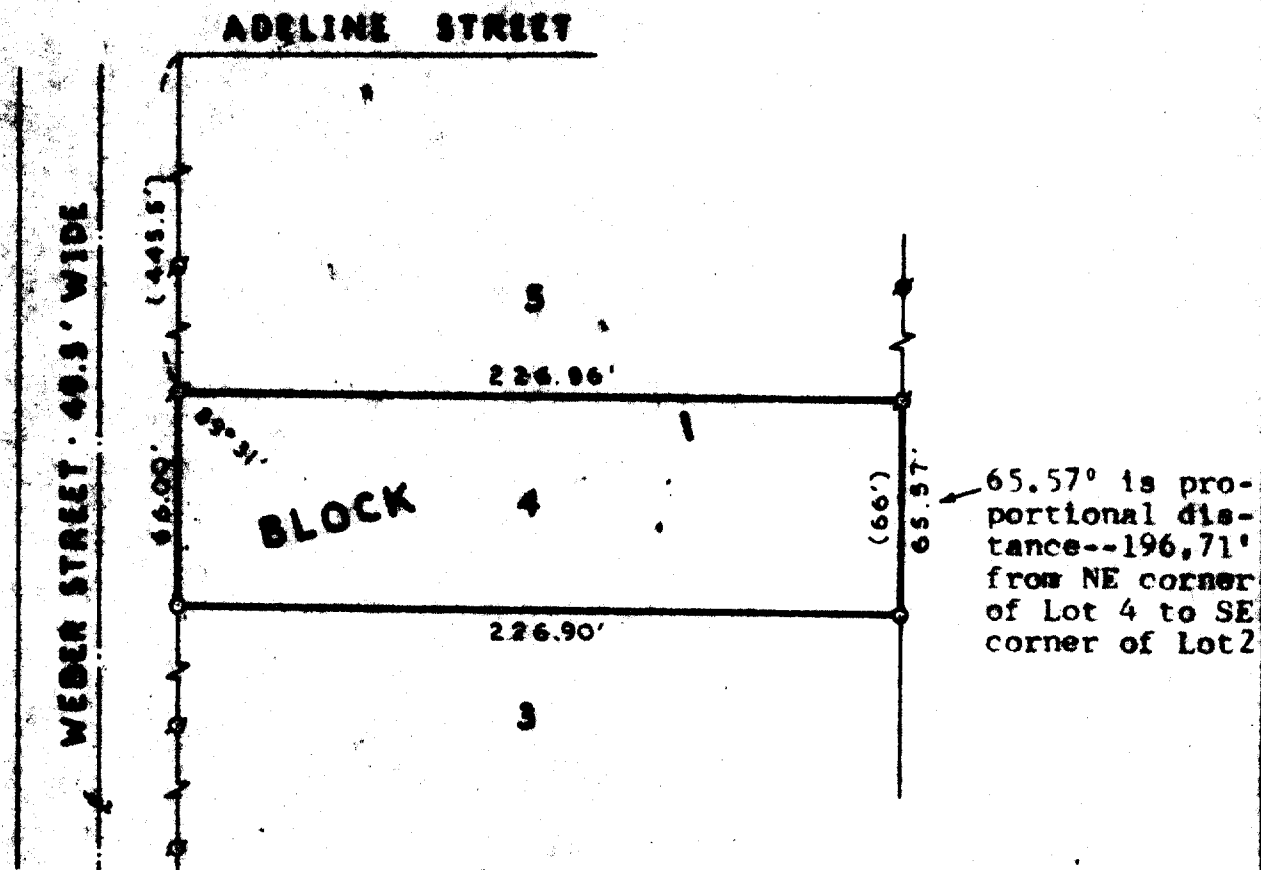

LEGEND

- 6 - IRON PIPE FOUND
- 5 - IRON PIPE PLACED
- 4 - CONCRETE MONUMENT
- 3 - SPICE
- (1) - AS PLATTED

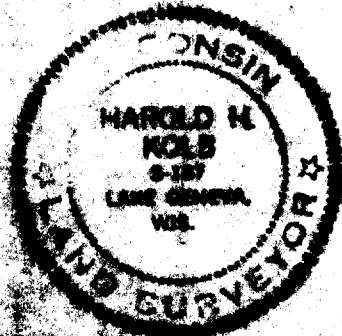

**I, HAROLD H. KOLB, DO HEREBY CERTIFY THAT I HAVE
 SURVEYED THE PROPERTY HEREON DESCRIBED ACCORDING
 TO THE OFFICIAL RECORDS, AND THAT THE PLAT HEREON
 IS A CORRECT REPRESENTATION OF THE LOT LINES.**

Harold H. Kolb
HAROLD H. KOLB
WISCONSIN REGISTERED LAND SURVEYOR, 5-187
DATE November 2, 1972

4-101