

GRID NORTH
WISCONSIN STATE PLANE COORDINATE SYSTEM - SOUTH ZONE

WEST LINE OF THE NW 1/4 OF SECTION 27-1-16
BEARS N 01°42'46" W
NAD 1927

FARRIS, HANSEN & ASSOCIATES, INC.

ENGINEERING - ARCHITECTURE - SURVEYING

7 RIDGWAY COURT - P.O. BOX 437 - ELKHORN, WISCONSIN 53121

PHONE: (262) 723-2098 FAX: (262) 723-5886


PLAT OF SURVEY

LOT 44 OF INDIAN PRAIRIE SUBDIVISION



LOCATED IN THE NW 1/4 OF SECTION 27,
TOWN 1 NORTH, RANGE 16 EAST,
WALWORTH COUNTY, WISCONSIN

- WORK ORDERED BY -
BERINGER HOMES
6595 NORTH LAZY RIVER
JANESVILLE, WI 53545

COTTON GRASS LANE
66' WIDE R.O.W.

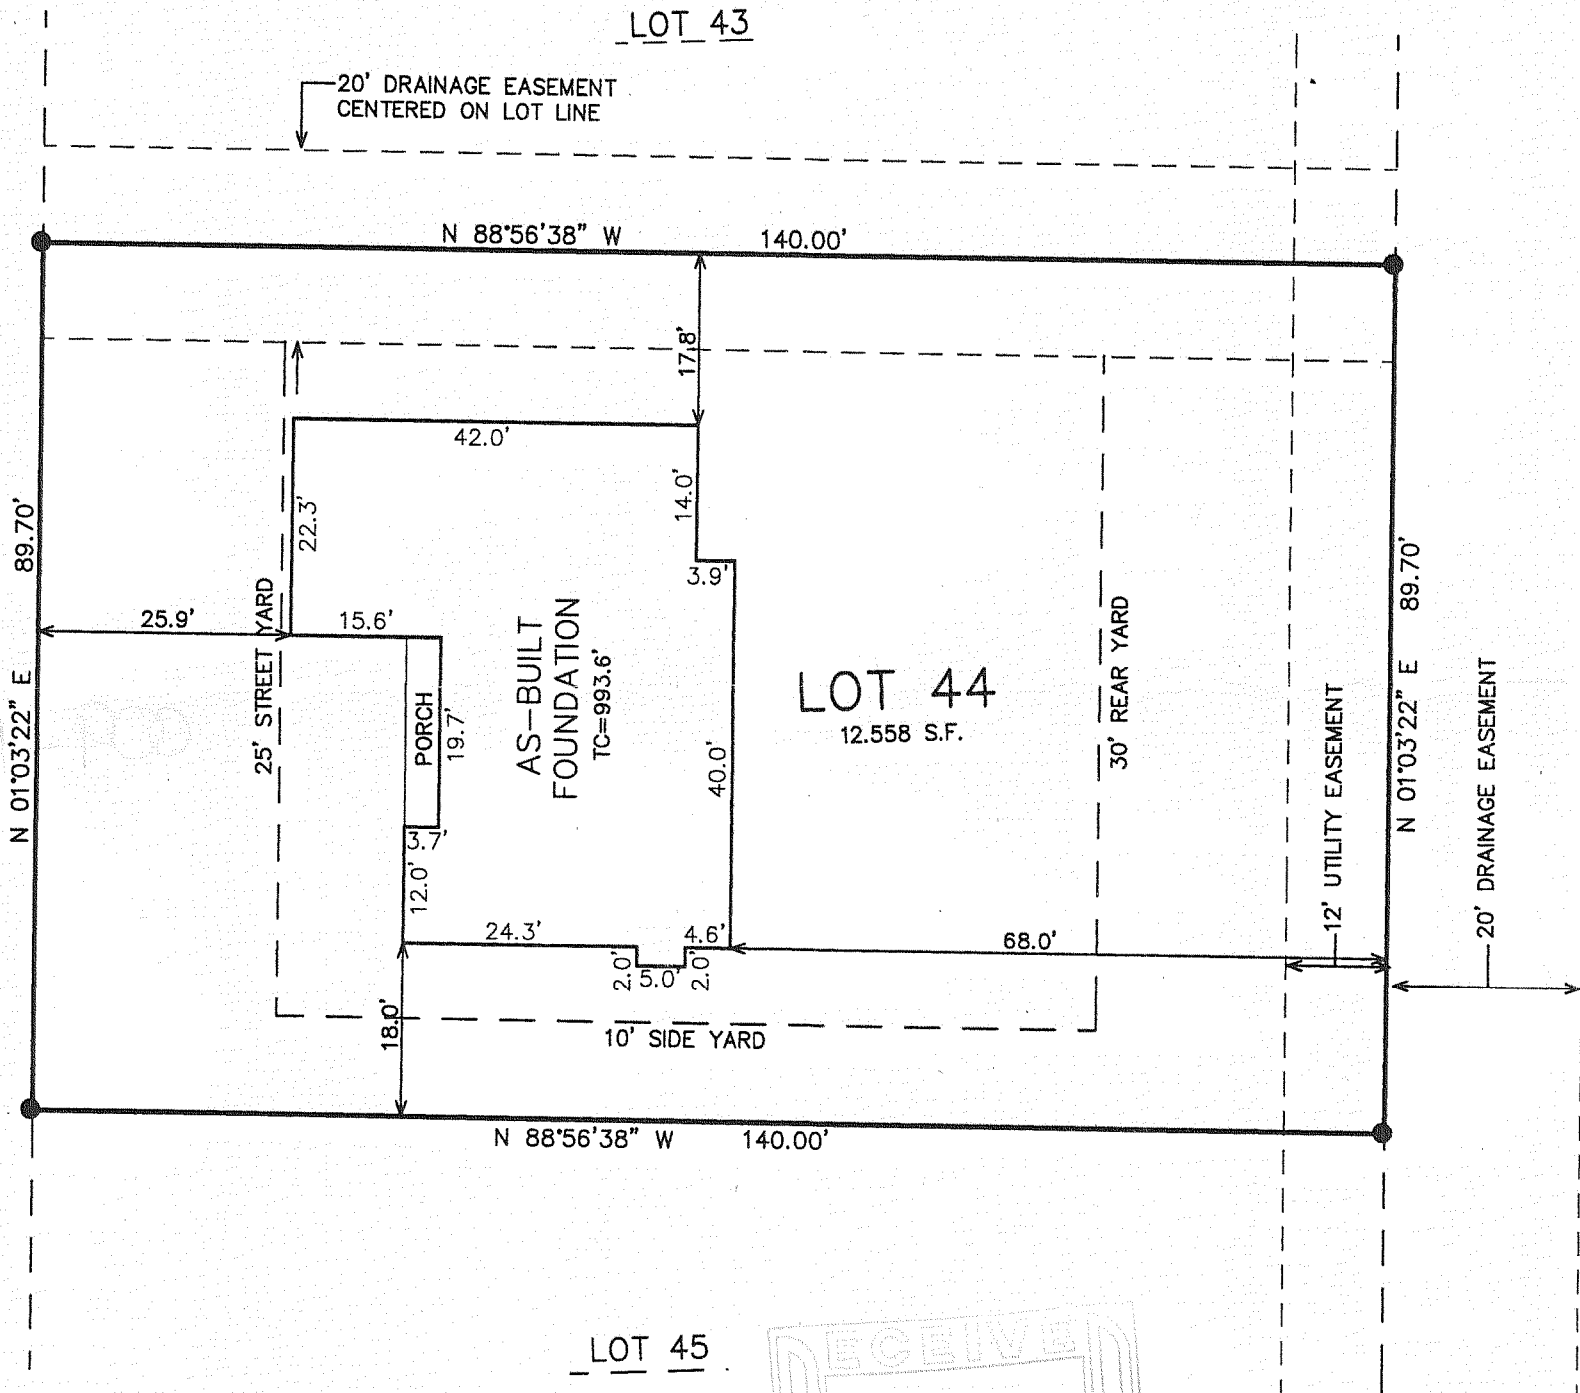

LOT 45

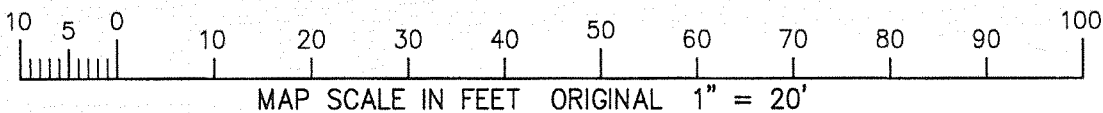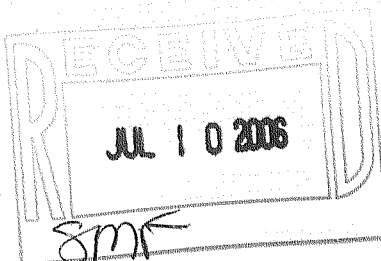

NOTE: COPIES OF THIS MAP TO WHICH THE FOLLOWING CERTIFICATE WILL APPLY SHOW THE SURVEYOR'S ORIGINAL SEAL AND SIGNATURE IN RED INK. COPIES BY ANY OTHER MEANS MAY HAVE ALTERATIONS WHICH DO NOT REPRESENT THE SURVEYOR'S WORK PRODUCT.

I HEREBY CERTIFY THAT THE ABOVE DESCRIBED PROPERTY HAS BEEN SURVEYED UNDER MY DIRECTION AND THAT THE ABOVE MAP IS A TRUE REPRESENTATION THEREOF AND SHOWS THE SIZE AND LOCATION OF THE PROPERTY AND ITS EXTERIOR BOUNDARIES. THIS SURVEY IS MADE FOR THE USE OF THE PRESENT OWNERS OF THE PROPERTY, AND ALSO THOSE WHO PURCHASE, MORTGAGE, OR GUARANTEE THE TITLE THERETO WITHIN ONE YEAR FROM THE DATE HEREOF.

DATED: JANUARY 27, 2005

REVISED 02/09/2006
TO SHOW SIZE AND LOCATION OF
PROPOSED RESIDENCE

REVISED 05/24/2006
TO SHOW SIZE AND LOCATION OF
AS-BUILT FOUNDATION



LEGEND

● = FOUND IRON REBAR STAKE

(XXX) = RECORDED AS

G.E. = GARAGE ENTRY ELEVATION

T.C. = TOP OF FOUNDATION ELEVATION

XXX.X = EXISTING GROUND ELEVATION

PETER S. GORDON R.L.S. 2101

PROJECT: 5189.44
DATE: 01/27/2005
SHEET 1 OF 1

VIP-44

009-1024