

|                                                                                                                    |                                                                                                                                                                           |
|--------------------------------------------------------------------------------------------------------------------|---------------------------------------------------------------------------------------------------------------------------------------------------------------------------|
| <p><b>LAND-MARK SURVEYING</b><br/> <b>Mark L. Miritz</b><br/> <b>Wisconsin Registered Land Surveyor S-2582</b></p> | <p><b>N9330 Knuteson Drive</b><br/> <b>Whitewater, WI 53190</b><br/> <b>Phone: (262) 495-3284</b><br/> <b>FAX : (262) 495-8421</b><br/> <b>LAND-MARKSURVEYING.COM</b></p> |
|--------------------------------------------------------------------------------------------------------------------|---------------------------------------------------------------------------------------------------------------------------------------------------------------------------|


LAND-MARKSURVEYING.COM

# PLAT OF SURVEY

**LOT 5 OF SUHR'S SUBDIVISION LOCATED IN PART OF THE SW 1/4 OF THE SW 1/4 OF SECTION 22, TOWN 1 NORTH, RANGE 16 EAST, VILLAGE OF WALWORTH, WALWORTH COUNTY, WISCONSIN**

**ORDERED BY:**  
**TOM GUEQUIERRE**  
**THE RAULAND AGENCY**  
**118 KENOSHA STREET**  
**WALWORTH, WI 53184**

AUG 1 2006

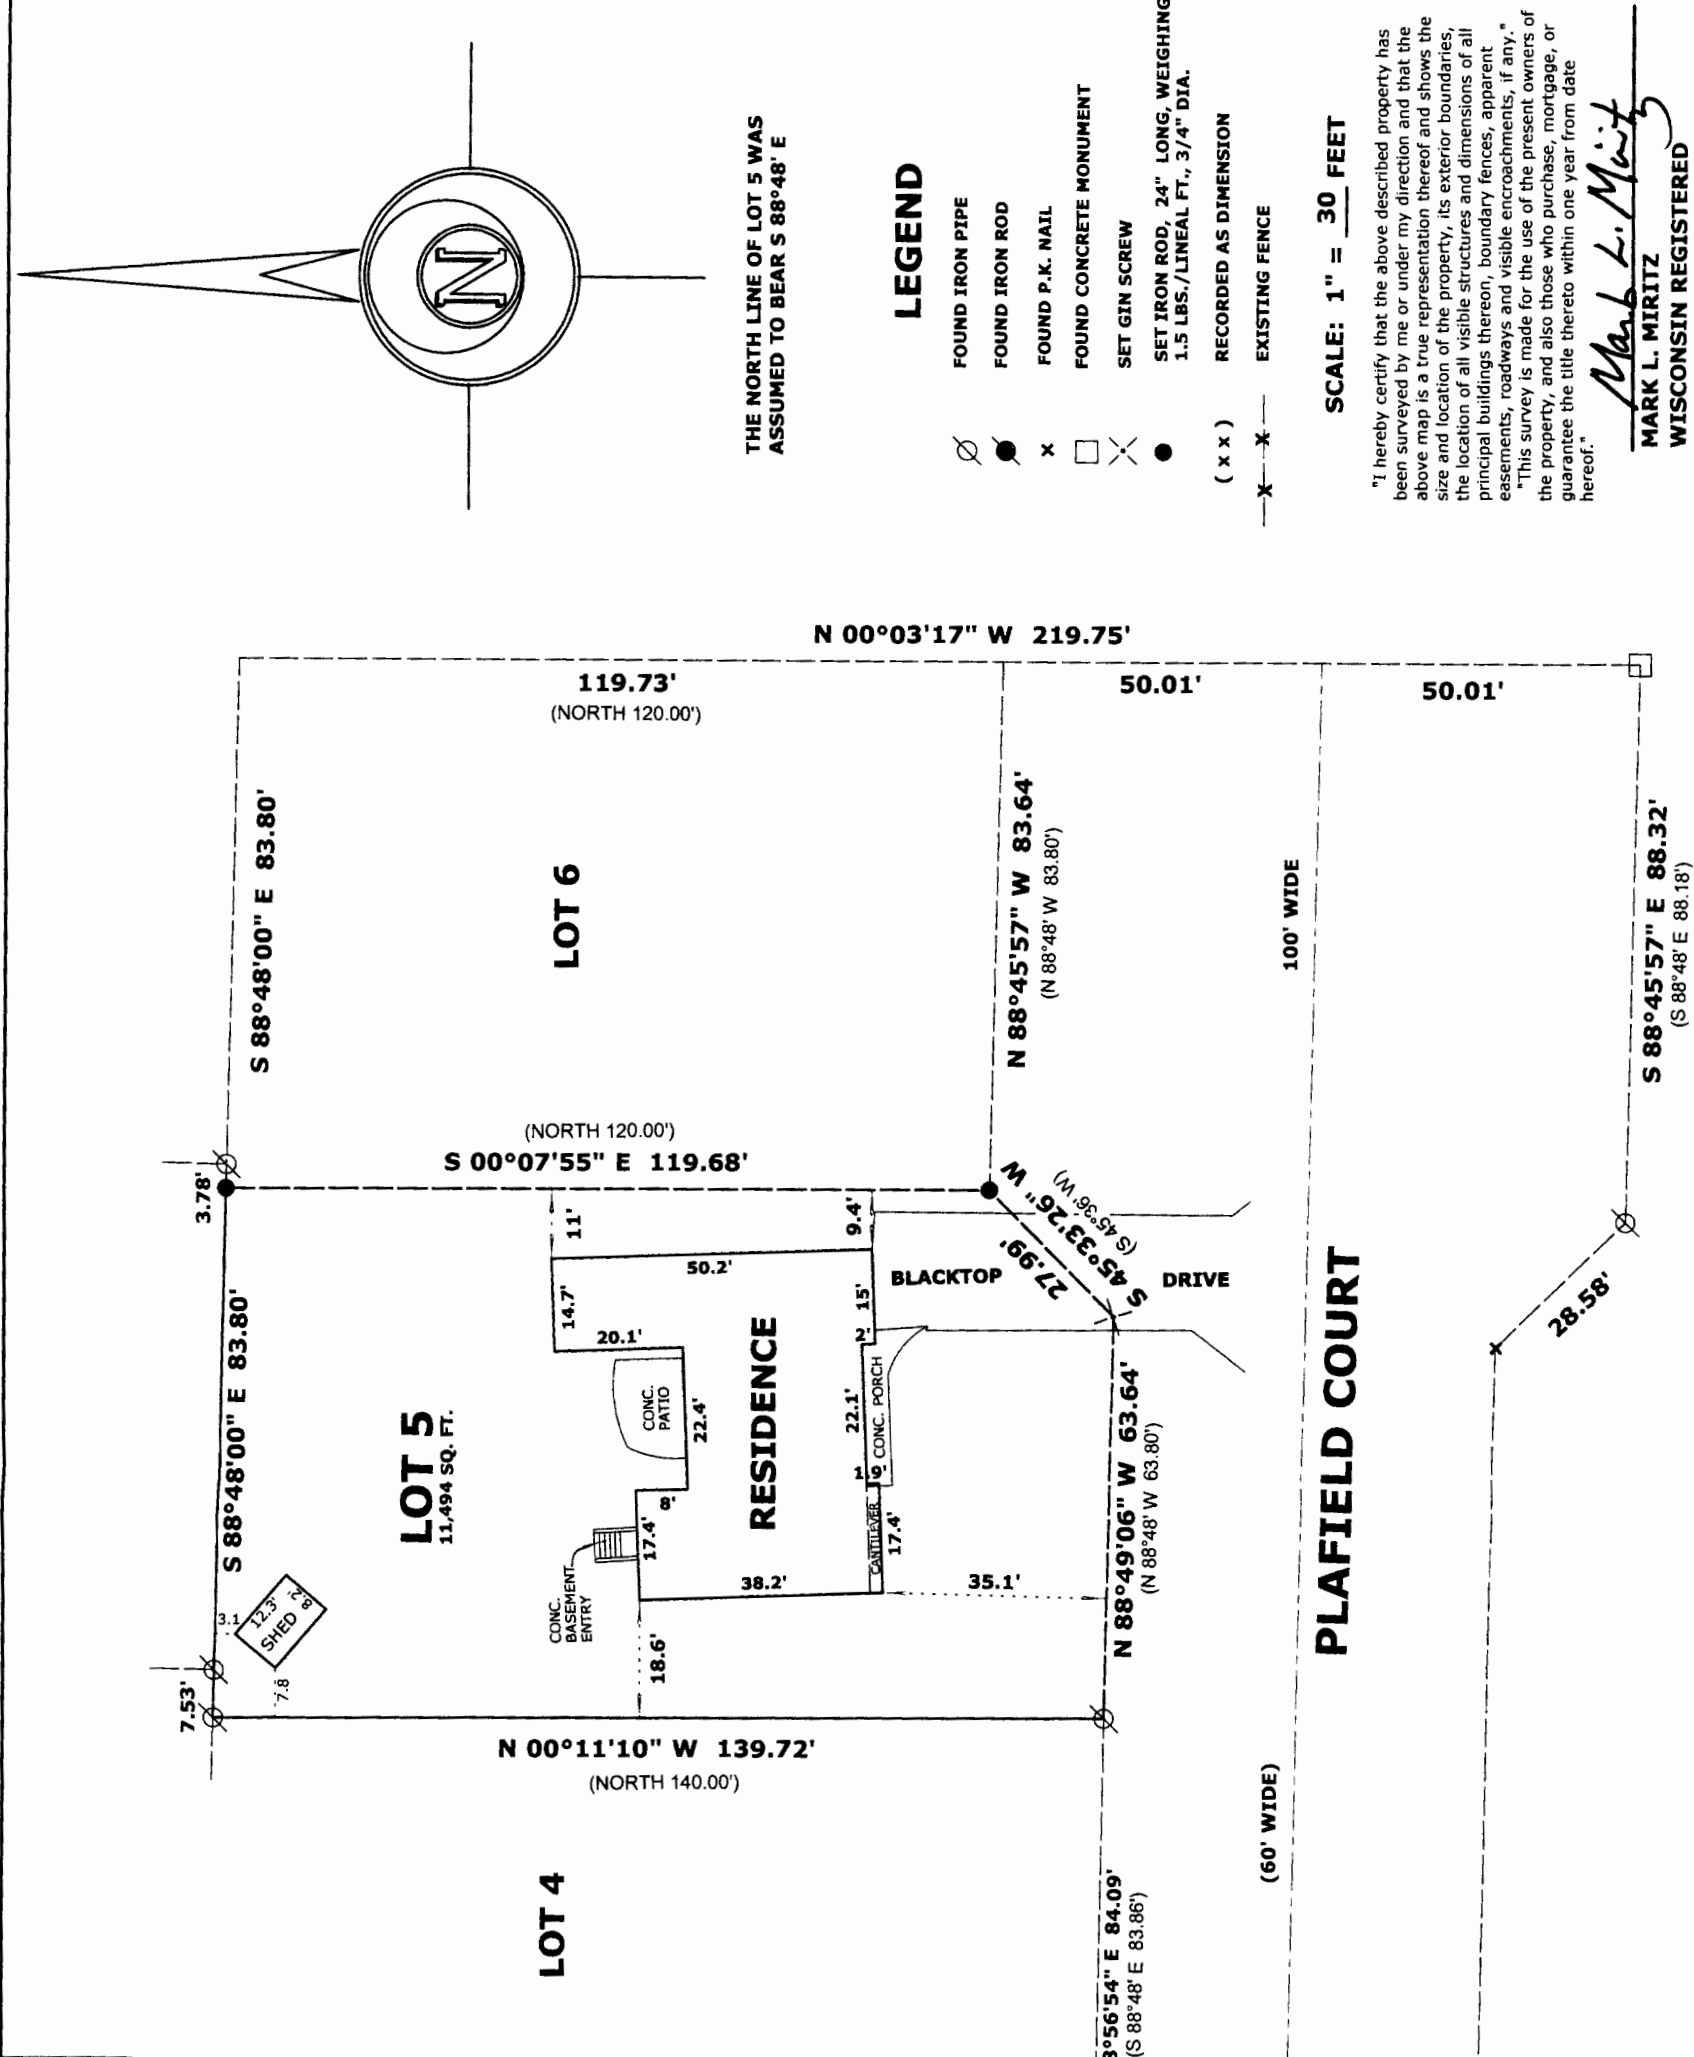

"I hereby certify that the above described property has been surveyed by me or under my direction and that the above map is a true representation thereof and shows the size and location of the property, its exterior boundaries, the location of all visible structures and dimensions of all principal buildings thereon, boundary fences, apparent easements, roadways and visible encroachments, if any."

"This survey is made for the use of the present owners of the property, and also those who purchase, mortgage, or guarantee the title thereto within one year from date hereof."

**50.01'**

**28.50'**

hereof."

*Mark L. Miritz*

**MARK L. MIRITZ**  
**WISCONSIN REGISTERED**  
**LAND SURVEYOR S-2582**

**S 88°45'57" E 88.32'**  
(S 88°48' E 88.18')

58'

DATE: MAY 28, 2006 JOB NO. 06.510