

LAND-MARK SURVEYING

Mark L. Miritz

Wisconsin Registered Land Surveyor S-2582

N9330 Knuteson Drive
Whitewater, WI 53190
Phone:(262)495-3284

PLAT OF SURVEY


LEGAL DESCRIPTION:

IN THE SOUTHEAST 1/4 OF THE SOUTHEAST 1/4,
SECTION 22, TOWNSHIP 1 NORTH, RANGE 16 EAST,
IN THE VILLAGE OF WALWORTH, WALWORTH
COUNTY, WISCONSIN.

LOT 55 OF OAK KNOLLS OF WALWORTH ADDITION
NO. 1 AS RECORDED IN CAB. B ON SLIDE 164

OWNER:
DAVID W. & BETHANY L. WARO
922 WILLIAMS ST.
WALWORTH, WI. 53184

ORDERED BY:
BECKY MERVIN
RAULAND AGENCY
P.O. BOX 159
WALWORTH, WI. 53184

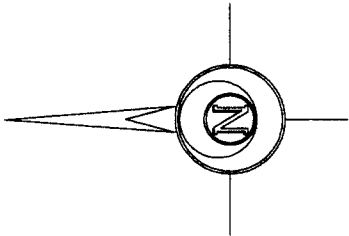

BASIS OF BEARINGS:
THE SW'LY LINE OF LOT 55
BEING N 49°18'32" W

LEGEND

- Ø FOUND IRON PIPE
- FOUND IRON ROD
- ☒ FOUND COUNTY MONUMENT
- ☐ FOUND CONCRETE MONUMENT
- + CHISEL CUT IN CONCRETE
- SET IRON ROD, 24" LONG, WEIGH-
ING 1.5 LBS./LINEAL FT., 3/4" DIA
- (x x) RECORDED AS DIMENSION
- X-X- EXISTING FENCE



SCALE: 1" = 30 FEET

"I hereby certify that the above described property has been surveyed by me or under my direction and that the above map is a true representation thereof and shows the size and location of the property, it's exterior boundaries, the location of all visible structures and dimensions of all principal buildings thereon, boundary fences, apparent easements, roadways and visible encroachments, if any."

"This survey is made for the use of the present owners of the property, and also those who purchase, mortgage, or guarantee the title thereto within one year from date hereof."

Mark L. Miritz
MARK L. MIRITZ
WISCONSIN REGISTERED
LAND SURVEYOR S-2582

DATE: 05/17/06 JOB NO. 06.506

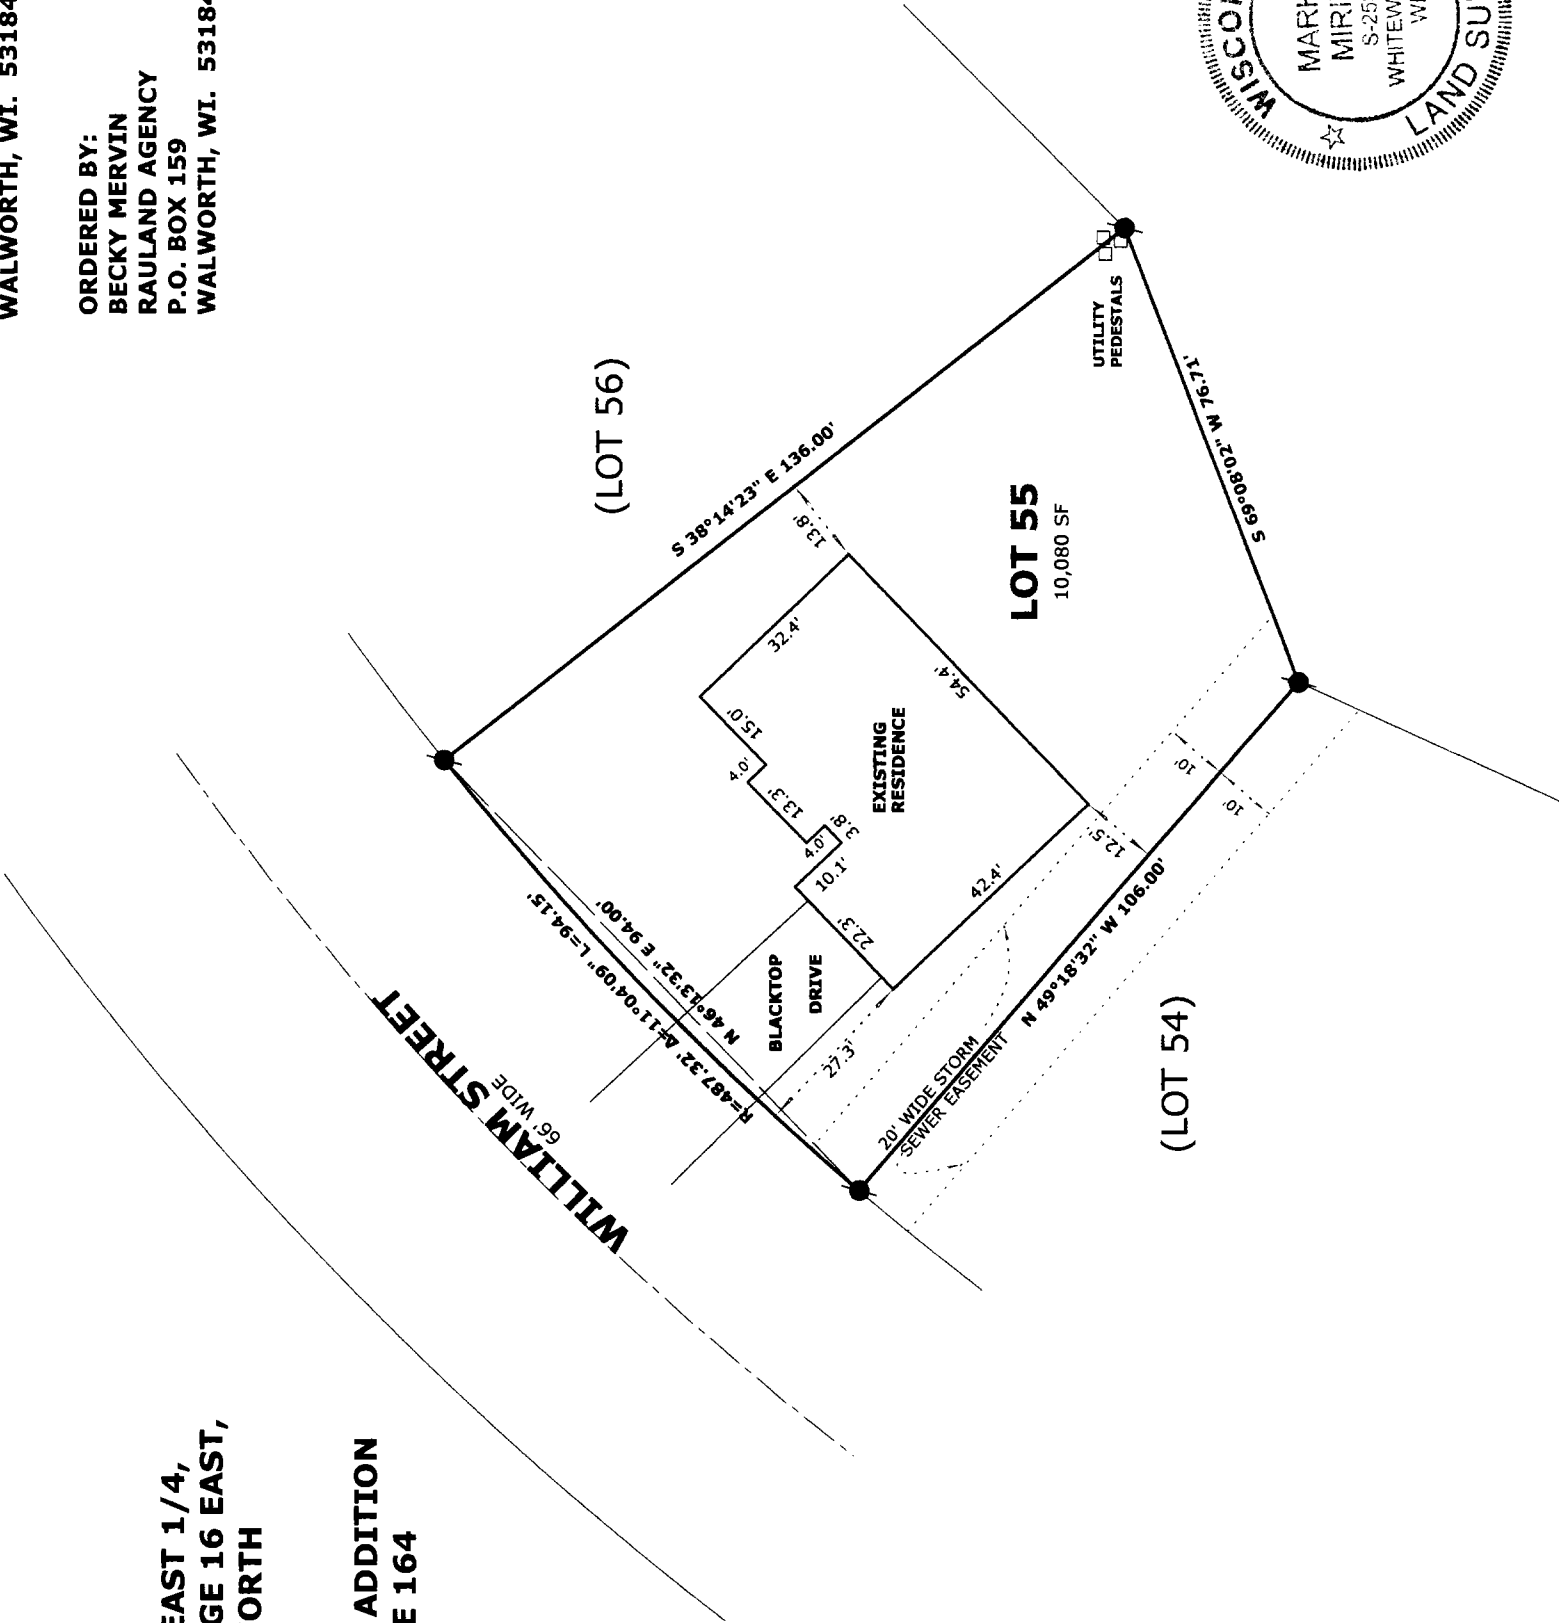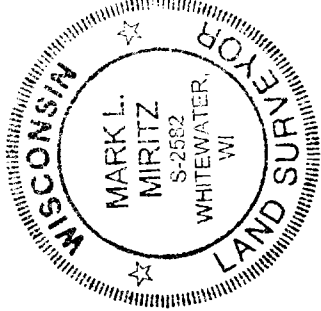

2006

gmf

V0K1-28

009-1029