


HAROLD H. KOLB
REGISTERED PROFESSIONAL LAND SURVEYOR
TWIST BUILDING
LAKE GENEVA, WIS. 53147

PLAN OF SURVEY OF

OUT-LOTS 86, 87, 88, 110, 111 AND 112 OF THE ADDITION PLAN
OF THE VILLAGE OF KENOSHA, AND A PARCEL OF LAND LOCATED IN
THE SOUTHWEST 1/4 OF SECTION 28, T 1 N, R 14 E, KENOSHA
COUNTY, WISCONSIN.

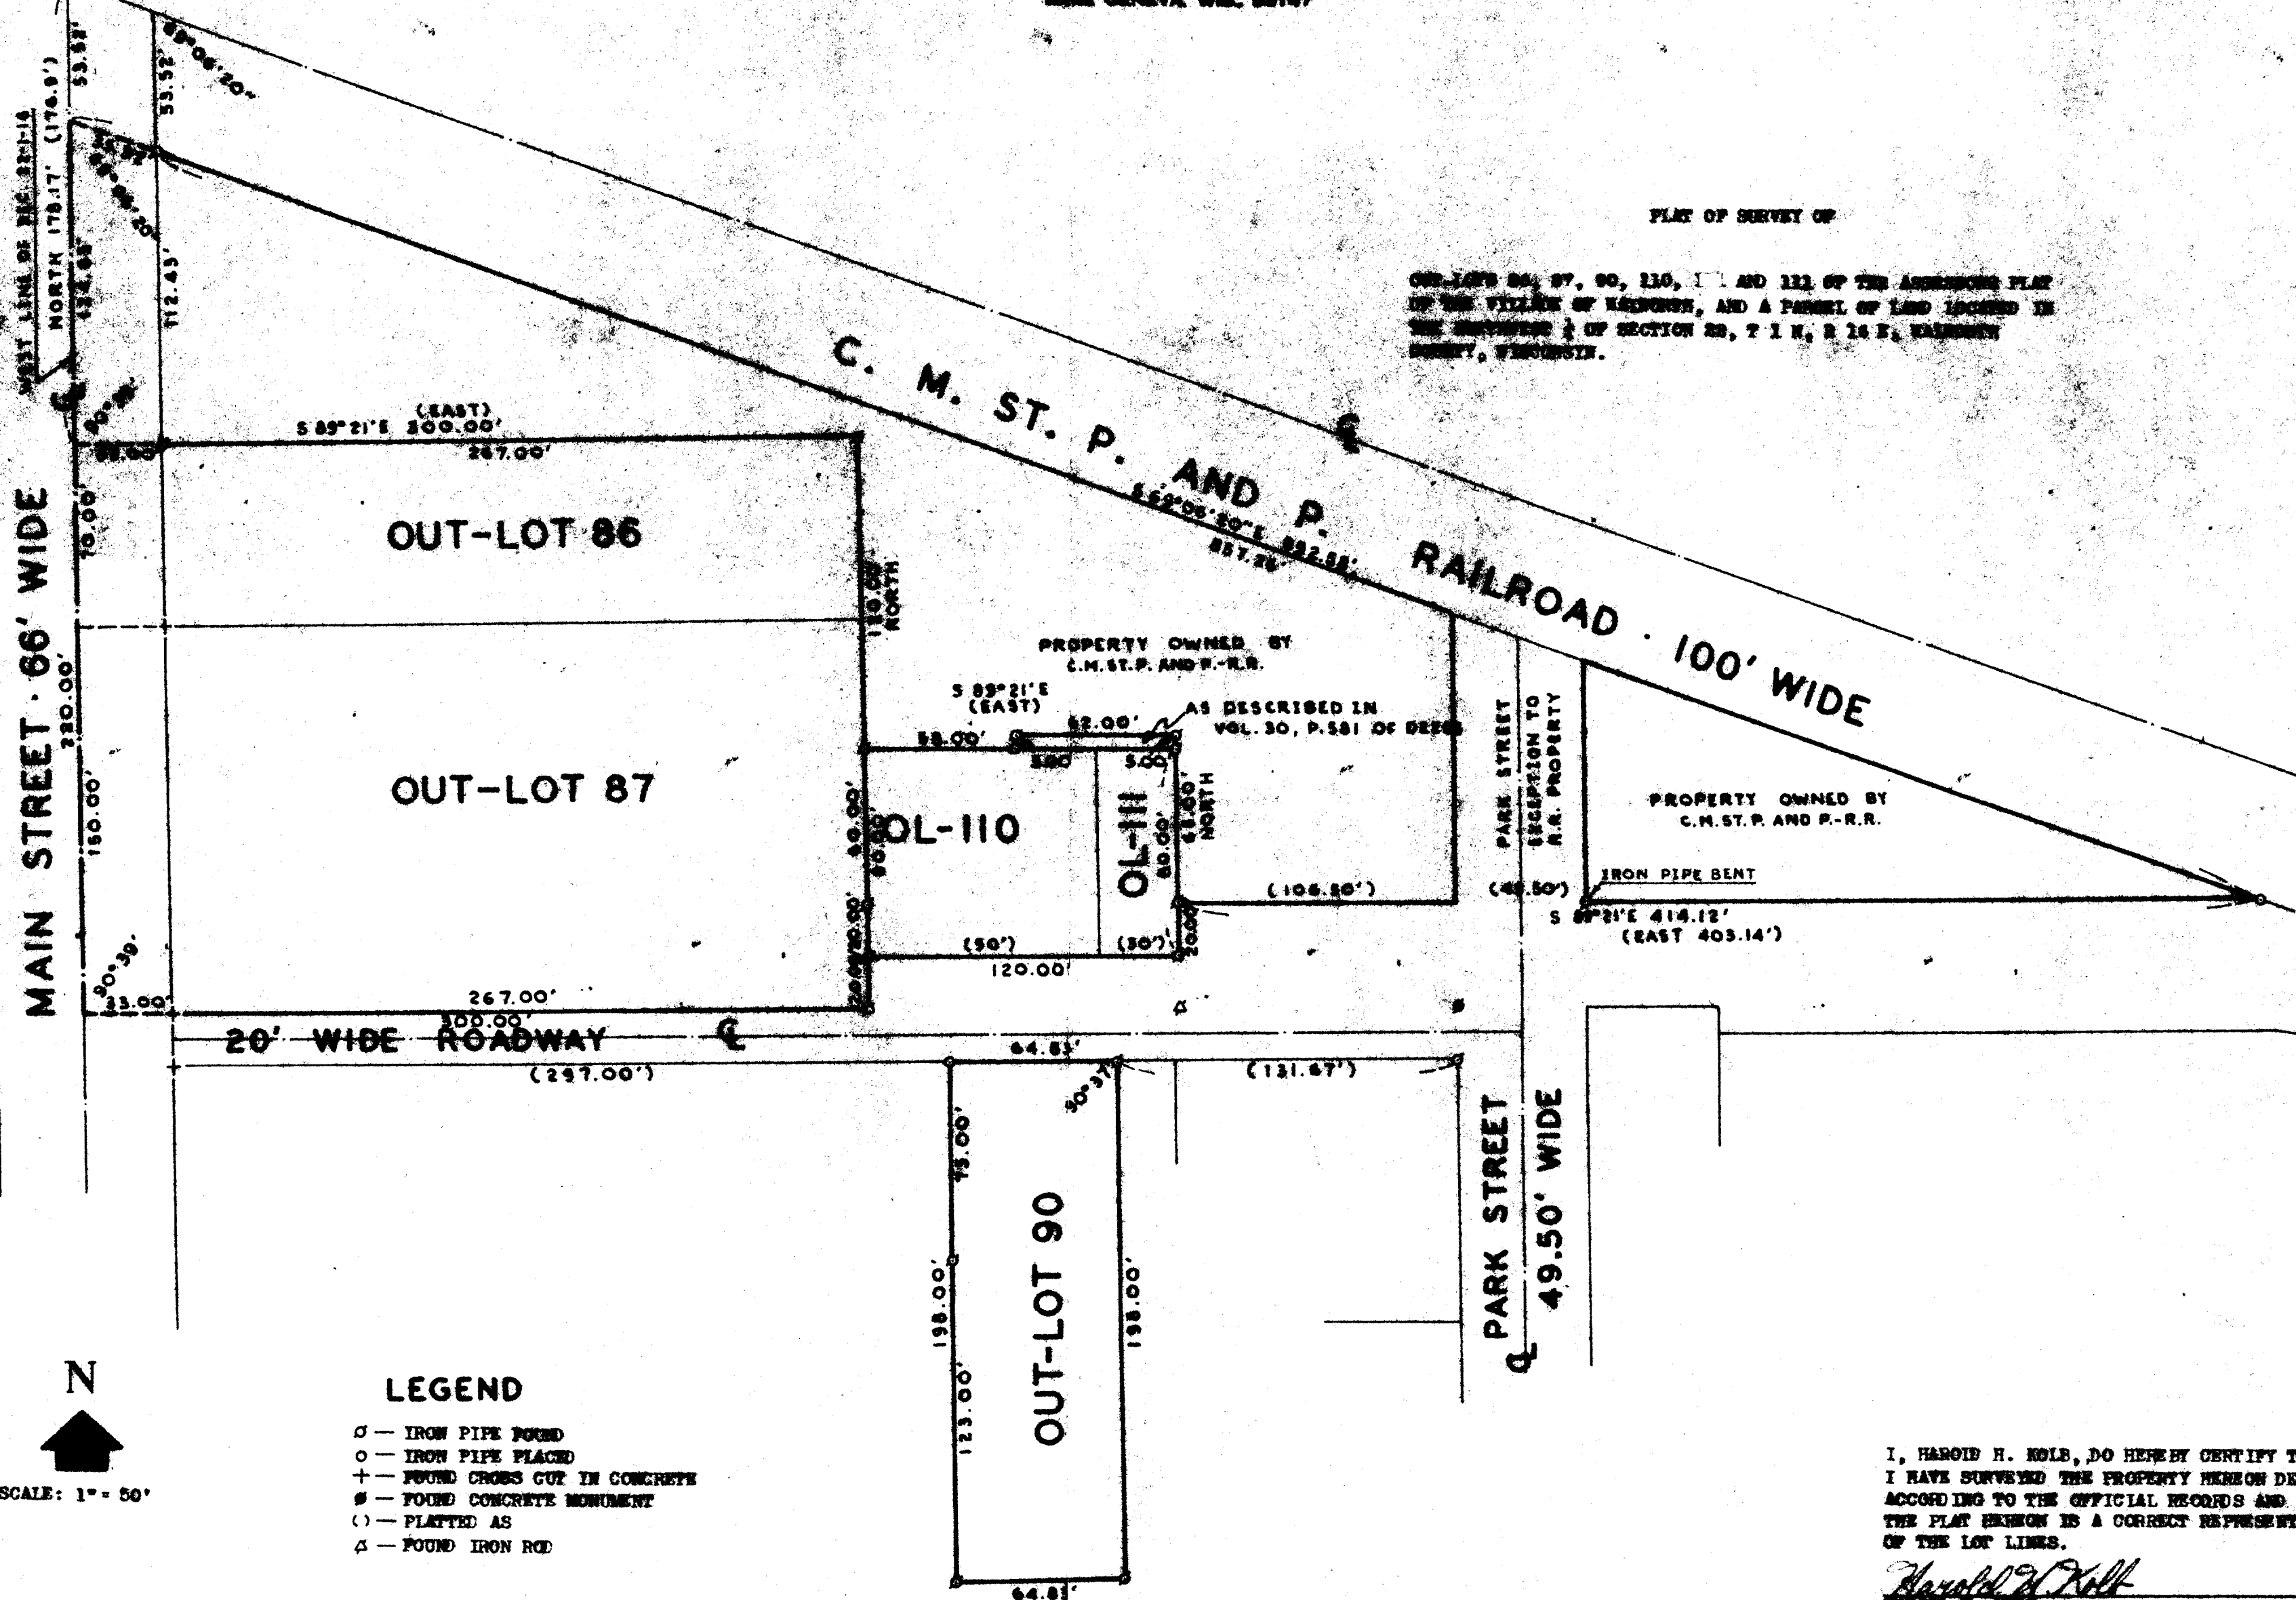

I, HAROLD H. KOLB, DO HEREBY CERTIFY THAT
I HAVE SURVEYED THE PROPERTY HEREON DESCRIBED
ACCORDING TO THE OFFICIAL RECORDS AND THAT
THE PLAN HEREON IS A CORRECT REPRESENTATION
OF THE LOT LINES.

Harold H. Kolb
HAROLD H. KOLB

WISCONSIN REGISTERED SURVEYOR, S-187

DATE: November 10, 1972

KWP-100, 125, 126
103

9-106