


FARRIS, HANSEN & ASSOCIATES, INC.

ENGINEERING — ARCHITECTURE — SURVEYING
7 RIDGWAY COURT — P.O. BOX 437 — ELKHORN, WISCONSIN 53121
PHONE: (262) 723-2098 FAX: (262) 723-5886

ASSIGNED THE EASTERLY BOUNDARY OF
LOT 4 N 04°12'07" W PER RECORD
PLAT OF BIGFOOT RIDGE OF WALWORTH

— WORK ORDERED BY —
SHOREWEST REALTY, INC.
623 MAIN STREET
LAKE GENEVA, WI 53147

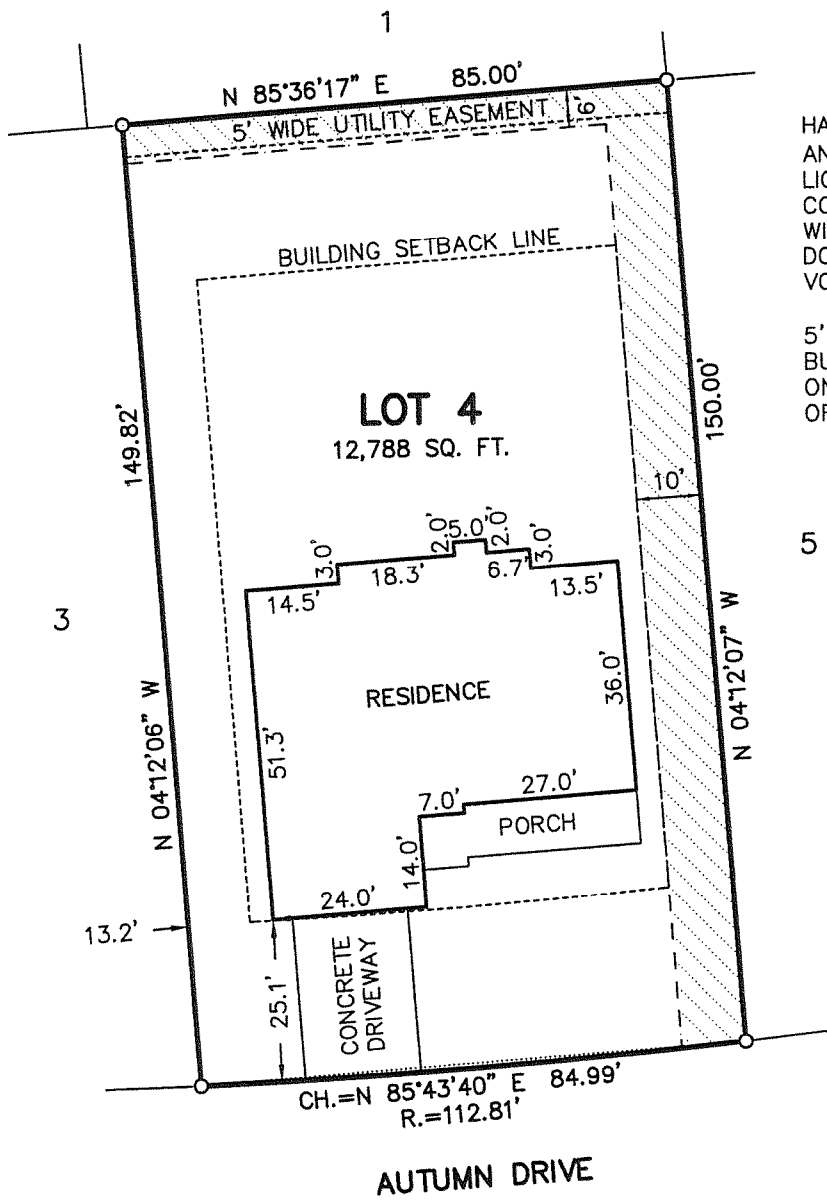

HATCHED AREA REPRESENTS 10' WIDE AND 6' WIDE WISCONSIN POWER & LIGHT COMPANY, GENERAL TELEPHONE CO., AND TCI CABLEVISION OF WISCONSIN, INC. EASEMENTS PER DOCUMENT NO. 327940 RECORDED IN VOL. 640 ON PAGE 5106.

5' WIDE UTILITY EASEMENT AND BUILDING SETBACK LINES AS SHOWN ON RECORD PLAT OF BIGFOOT RIDGE OF WALWORTH.

LEGEND
O—FOUND IRON PIPE STAKE



PLAT OF SURVEY

Lot 4 in Block 3 of Bigfoot Ridge of Walworth, a Subdivision located in the SE 1/4 of the SW 1/4 of Section 22, T1N, R16E, Village of Walworth, Walworth County, Wisconsin.

Tax Key No: VBIG 00017

LEGAL DESCRIPTION OF RECORD FROM TITLE COMMITMENT PROVIDED BY CLIENT



NOTE: COPIES OF THIS MAP TO WHICH THE FOLLOWING CERTIFICATE WILL APPLY SHOW THE SURVEYOR'S ORIGINAL SEAL AND SIGNATURE IN RED INK. COPIES BY ANY OTHER MEANS MAY HAVE ALTERATIONS WHICH DO NOT REPRESENT THE SURVEYOR'S WORK PRODUCT. I HEREBY CERTIFY THAT THE ABOVE DESCRIBED PROPERTY HAS BEEN SURVEYED UNDER MY DIRECTION AND THAT THE ABOVE MAP IS A TRUE REPRESENTATION THEREOF AND SHOWS THE SIZE AND LOCATION OF THE PROPERTY, ITS EXTERIOR BOUNDARIES, THE LOCATION OF ALL VISIBLE STRUCTURES, AND DIMENSIONS OF ALL PRINCIPLE BUILDINGS THEREON, BOUNDARY FENCES, APPARENT EASEMENTS, ROADWAYS, AND VISIBLE ENCROACHMENTS, IF ANY. THIS SURVEY IS MADE FOR THE USE OF THE PRESENT OWNERS OF THE PROPERTY, AND ALSO THOSE WHO PURCHASE, MORTGAGE, OR GUARANTEE THE TITLE THERETO WITHIN ONE YEAR FROM THE DATE HEREOF.

DATED: 7/14/2008

PETER S. GORDON

PROJECT: 7681
DATE: 07/14/2008
SHEET 1 OF 1

VBIG-17
JUL 15 2008

009-1077