


ABELL SURVEYING & MAPPING


1140 SEQUOIA STREET • DELAVAN, WISCONSIN 53115
262-728-6737

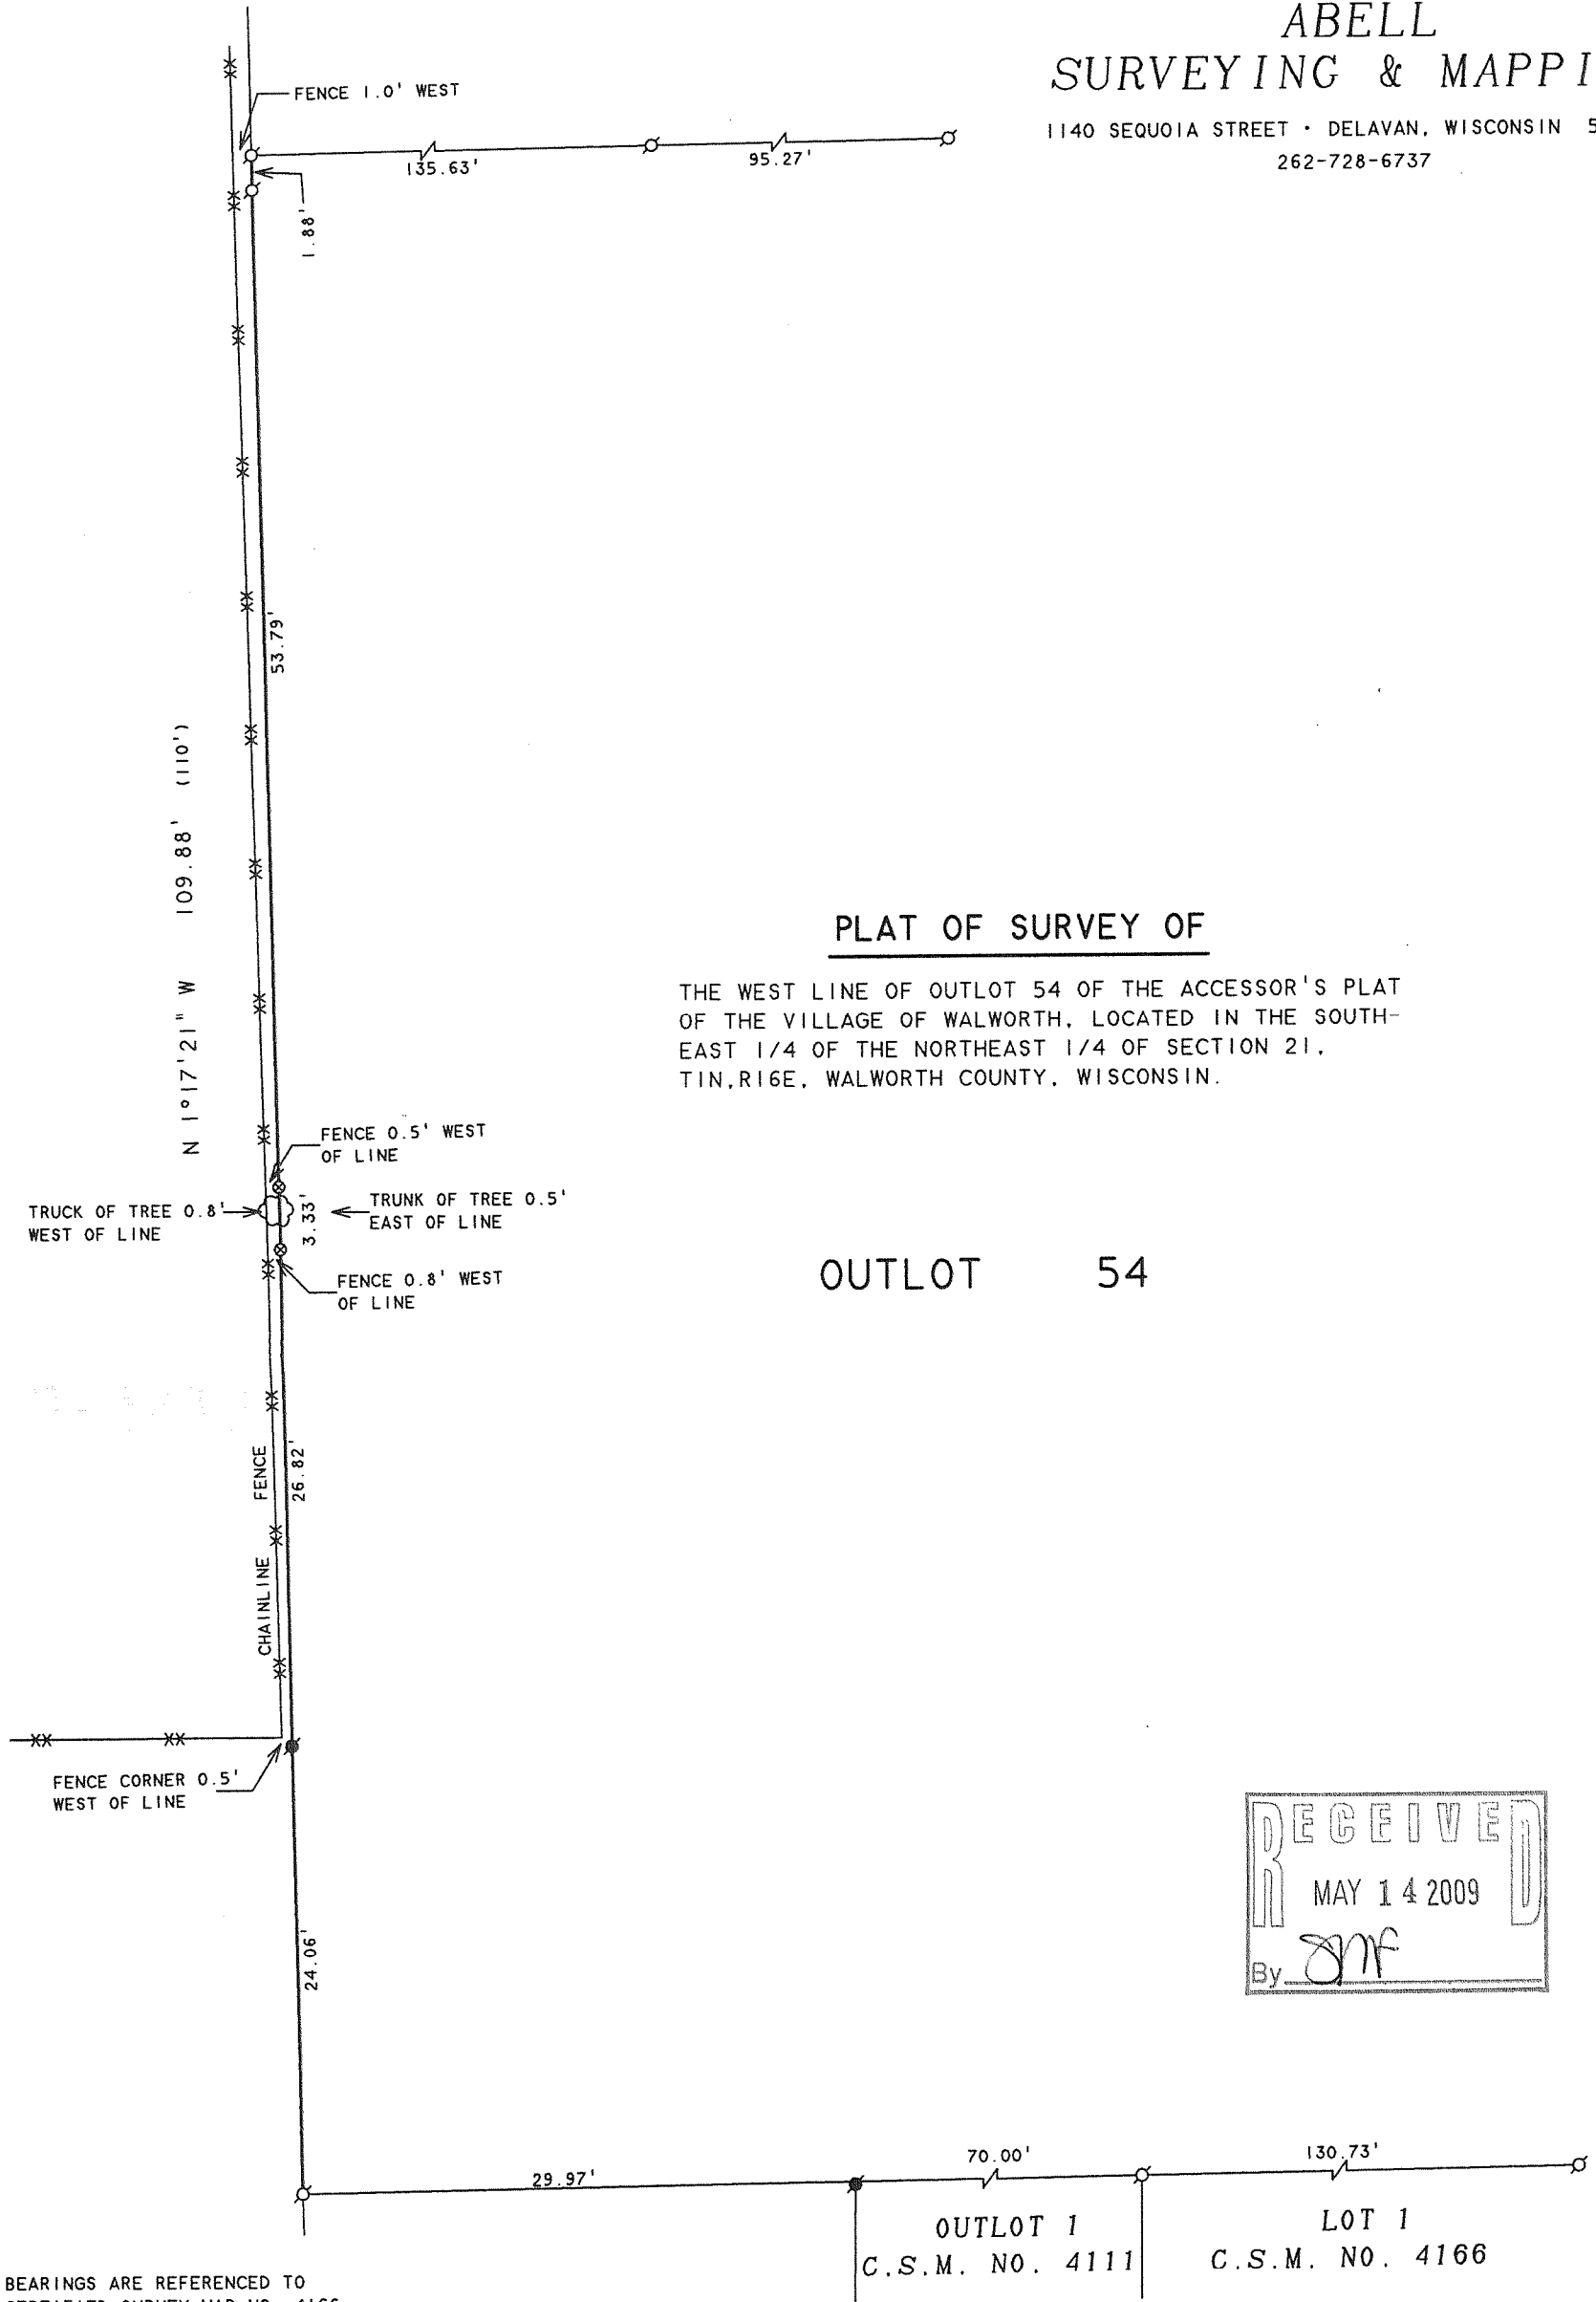

PLAT OF SURVEY OF

THE WEST LINE OF OUTLOT 54 OF THE ACCESSOR'S PLAT
OF THE VILLAGE OF WALWORTH, LOCATED IN THE SOUTH-
EAST 1/4 OF THE NORTHEAST 1/4 OF SECTION 21,
T1N, R16E, WALWORTH COUNTY, WISCONSIN.

OUTLOT 54

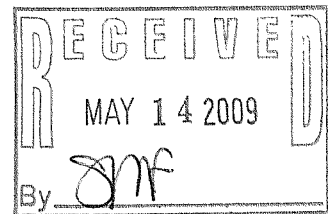

BEARINGS ARE REFERENCED TO
CERTIFIED SURVEY MAP NO. 4166

N



SCALE 1"=10'

LEGEND

- - IRON PIPE FOUND
- - IRON ROD FOUND
- ⊗ - 12" SPIKE SET
- ⊙ - TREE
- () - RECORDED AS

ORDERED BY: JIM DAHLKE
8437 E. STATE ROAD "67"
CLINTON, WI 53525

I, DAVID F. ABELL, DO HEREBY CERTIFY THAT I HAVE SURVEYED THE PROPERTY HEREON
DESCRIBED ACCORDING TO THE OFFICIAL RECORDS AND THAT THE PLAT HEREON IS A
CORRECT REPRESENTATION OF THE PROPERTY LINES TO THE BEST OF MY KNOWLEDGE AND
BELIEF.

David F. Abell

DAVID F. ABELL
WISCONSIN REGISTERED LAND SURVEYOR, S-1596

February 17, 2009

DATE: February 17, 2009 JOB NUMBER - 09001
NOTE: THIS IS NOT A CERTIFIED COPY UNLESS SEALED.

VWP-57

009-1088