


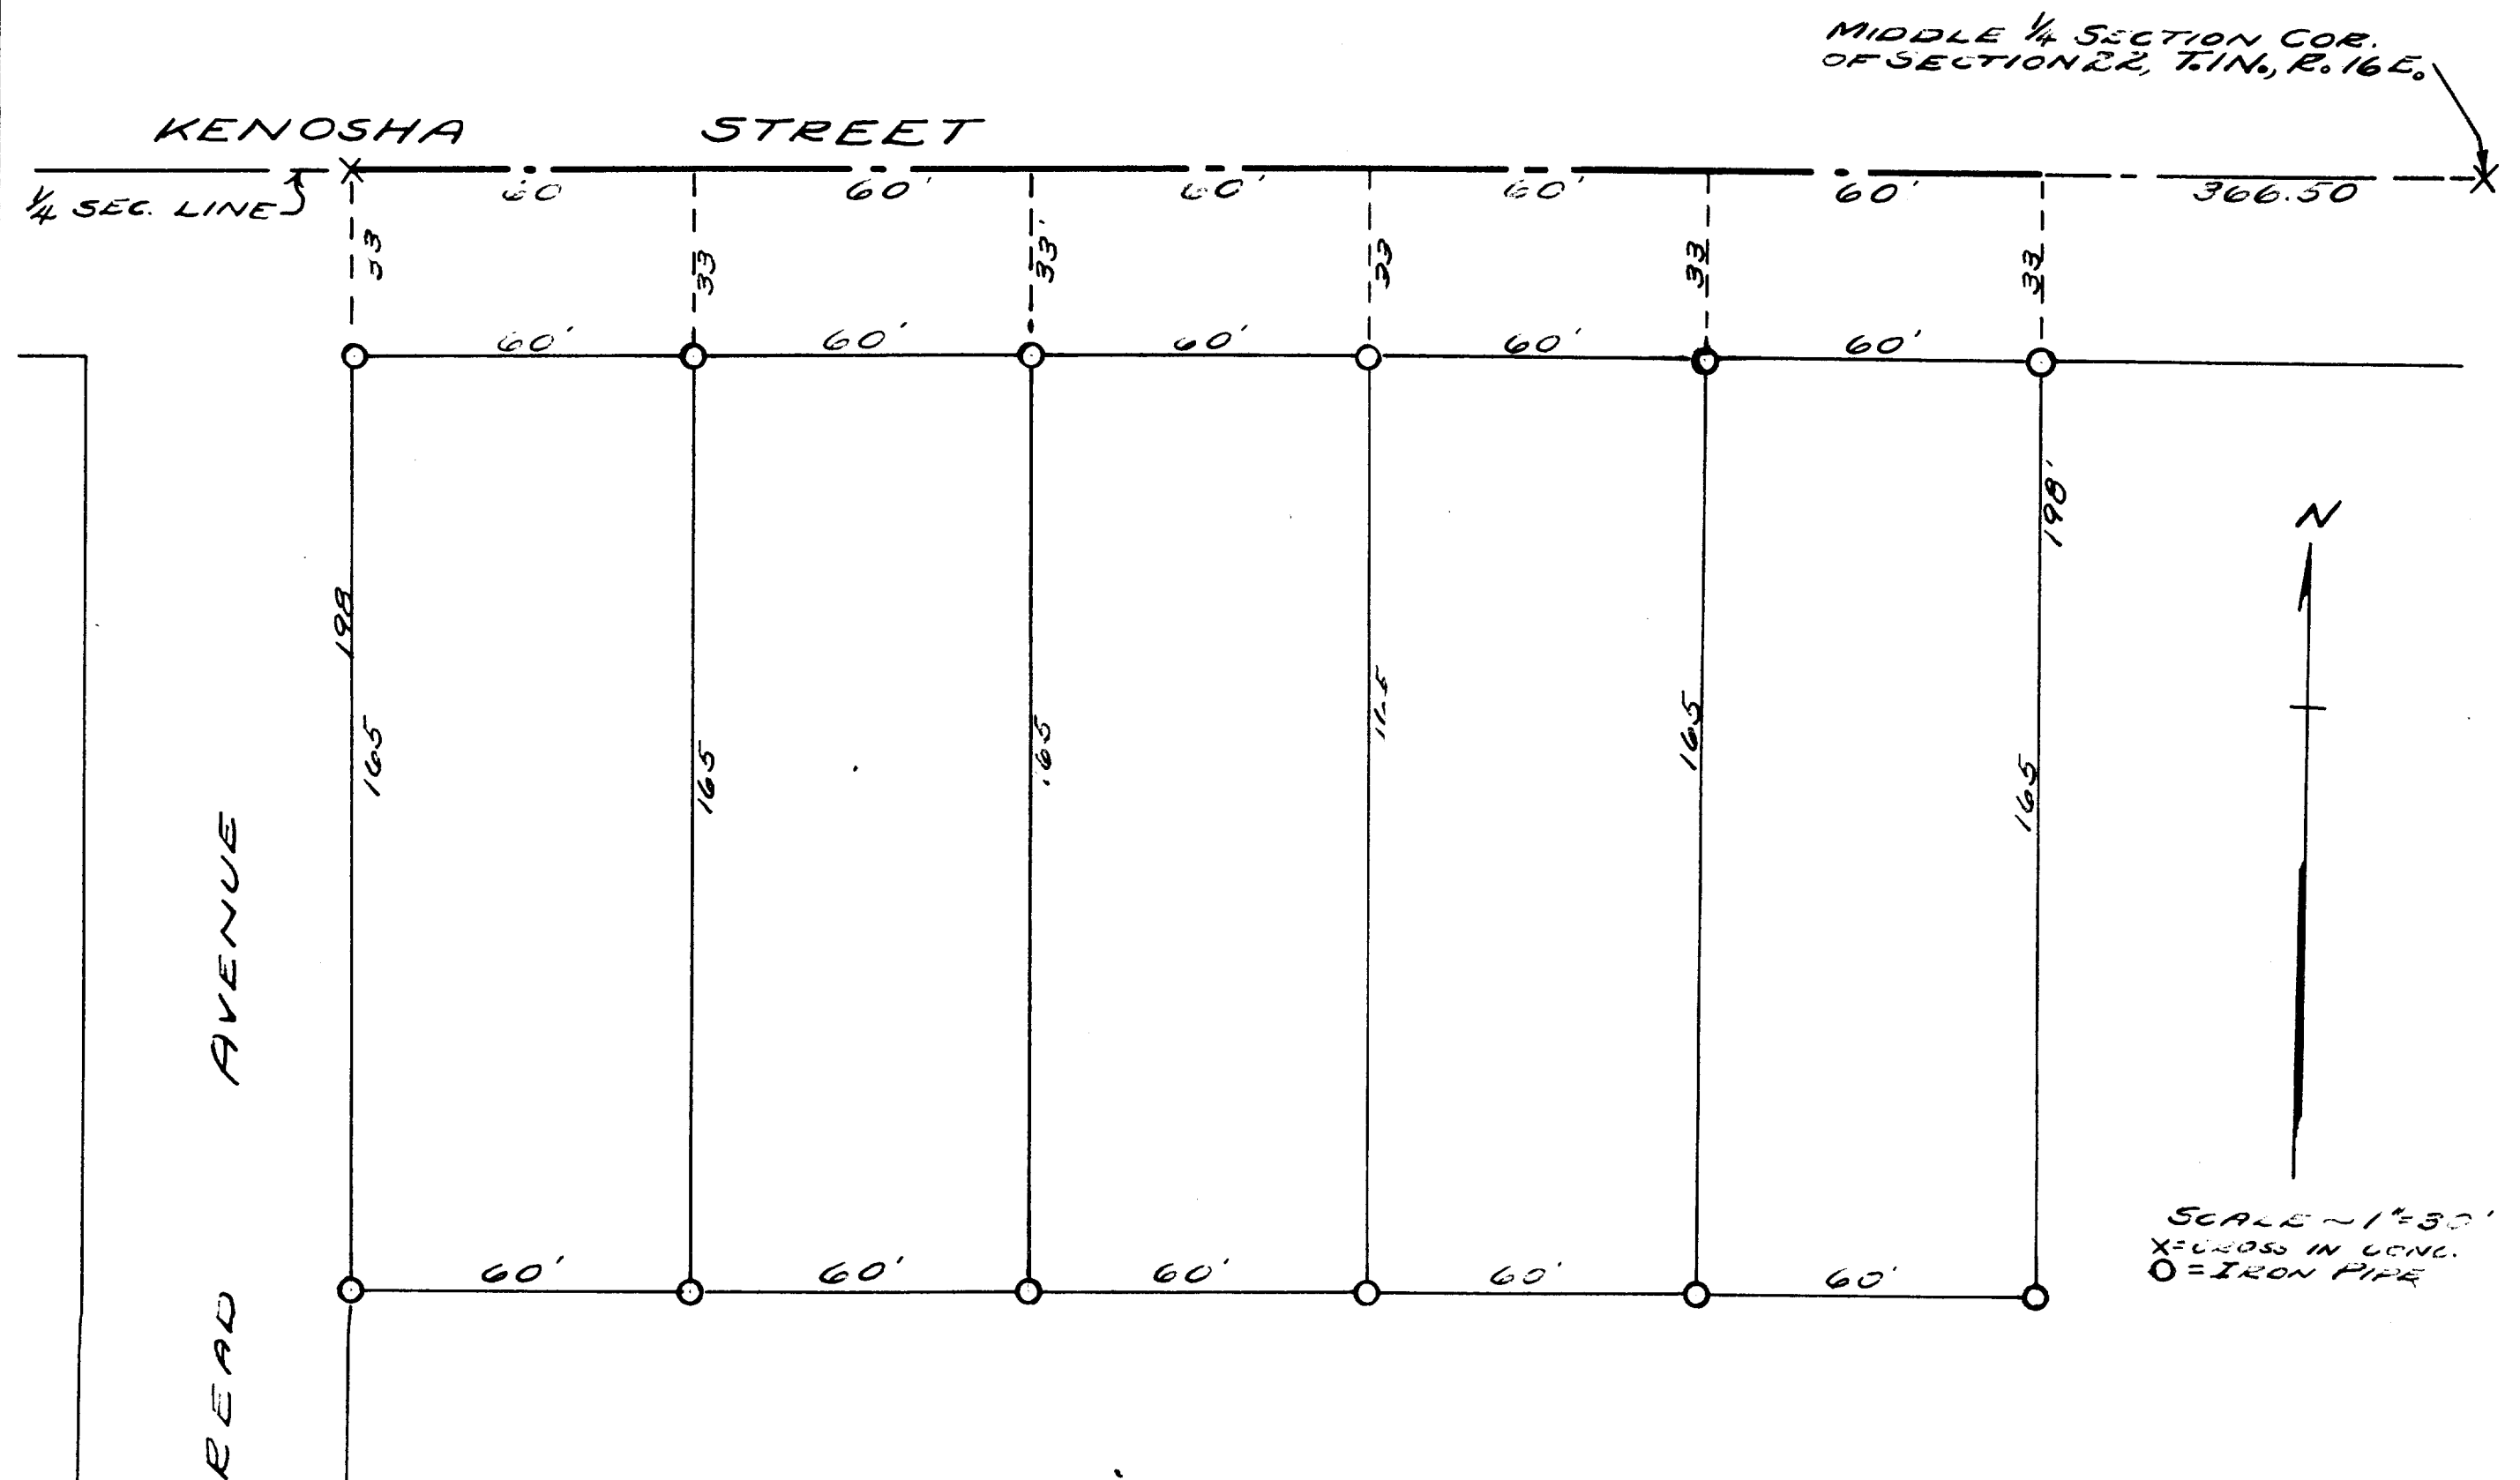

PLAT OF SURVEY OF PART OF OUTLOT 218 OF THE
ASSESSORS PLAT OF THE VILLAGE OF WALWORTH,
WALWORTH COUNTY, WISCONSIN.

JULY 2, 1946

H. E. Johnson
SURVEYOR

9-10J