

FARRIS, HANSEN & ASSOC. INC.

7 RIDGWAY COURT- P.O. BOX 437
ELKHORN, WISCONSIN 53121
PHONE (262) 723-2098
FAX (262) 723-5886
WORK ORDERED BY:
HARRY & CAROL VANDYKE
C/O THE RAULAND AGENCY
118 KENOSHA STREET/PO BOX 159
WALWORTH, WISCONSIN 53184



PLAT OF SURVEY

LOTS 1 & 2 OF CERTIFIED SURVEY MAP NO. 3577

RECORDED AS DOCUMENT NO. 567629
BEING LOT 7 OF FOX LANE SUBDIVISION
LOCATED IN PART OF THE SW 1/4 OF THE SW 1/4 OF
SECTION 15, TOWN 1 NORTH, RANGE 16 EAST,
VILLAGE OF WALWORTH, WALWORTH COUNTY, WISCONSIN

LEGEND

- = FOUND IRON REBAR STAKE, 3/4" DIA.
- (XXX) = RECORDED AS

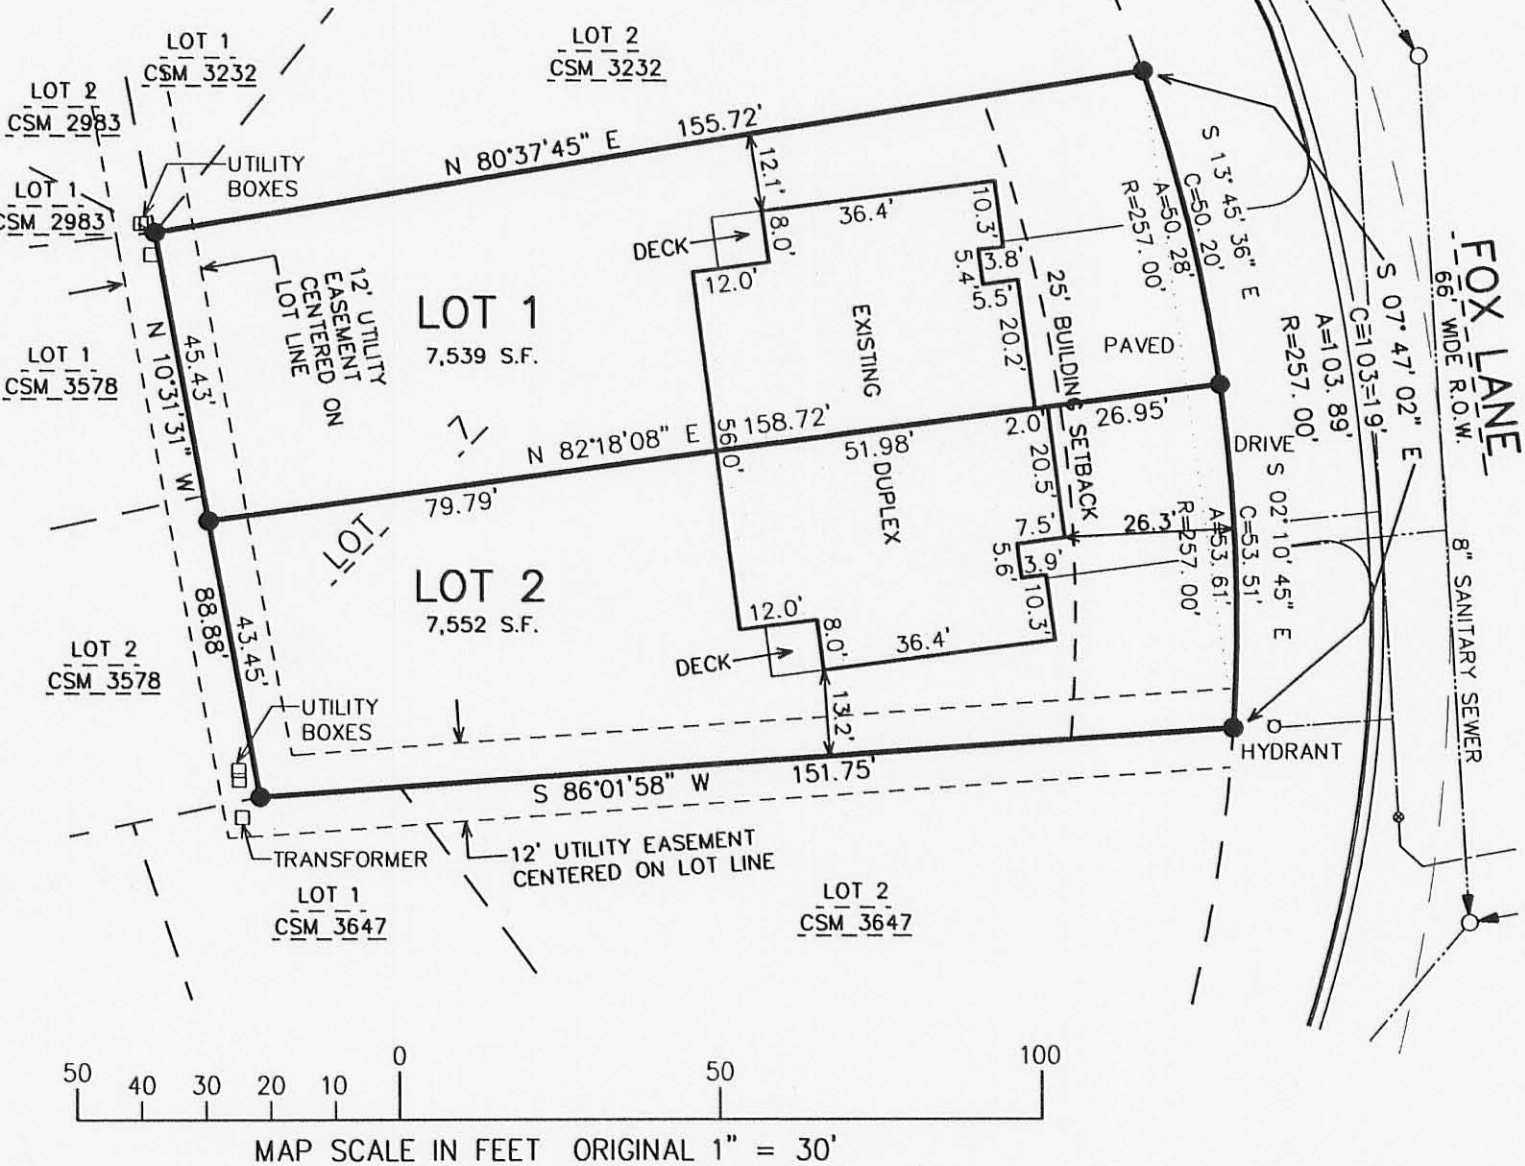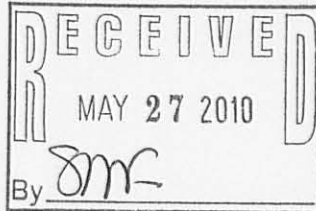

NOTE: COPIES OF THIS MAP TO WHICH THE FOLLOWING CERTIFICATE WILL APPLY SHOW THE SURVEYOR'S ORIGINAL SEAL AND SIGNATURE IN RED INK. COPIES BY ANY OTHER MEANS MAY HAVE ALTERATIONS WHICH DO NOT REPRESENT THE SURVEYOR'S WORK PRODUCT.

I HEREBY CERTIFY THAT THE ABOVE DESCRIBED PROPERTY HAS BEEN SURVEYED UNDER MY DIRECTION AND THAT THE ABOVE MAP IS A TRUE REPRESENTATION THEREOF AND SHOWS THE SIZE AND LOCATION OF THE PROPERTY, ITS EXTERIOR BOUNDARIES, THE LOCATION OF ALL VISIBLE STRUCTURES, AND DIMENSIONS OF ALL PRINCIPLE BUILDINGS THEREON, BOUNDARY FENCES, APPARENT EASEMENTS, ROADWAYS, AND VISIBLE ENCROACHMENTS, IF ANY. THIS SURVEY IS MADE FOR THE USE OF THE PRESENT OWNERS OF THE PROPERTY, AND ALSO THOSE WHO PURCHASE, MORTGAGE, OR GUARANTEE THE TITLE THERETO WITHIN ONE YEAR FROM THE DATE HEREOF.

DATED: APRIL 22, 2010

Peter S. Gordon
PETER S. GORDON



THIS INSTRUMENT DRAFTED
BY PETER S. GORDON
PROJECT NO. 4039.07.10
DATED: 4/22/2010
SHEET 1 OF 1 SHEETS

VA3577-1

APR 27 2010

VA3577-2

009-1110