


PREPARED FOR:
JAY HICKS
KEEFE REAL ESTAT, INC.
751 GENEVA PARKWAY
LAKE GENEVA, WI
53147

PLAT OF SURVEY

-OF-

OUTLOT 229, ASSESSOR'S PLAT, VILLAGE OF WALWORTH,
COUNTY OF WALWORTH, WI

KROTT SURVEYING INC.
N3705 WILLOW BEND LANE
LAKE GENEVA WI. 53147
PHONE # (262)248-3697
FAX # (262)249-0639

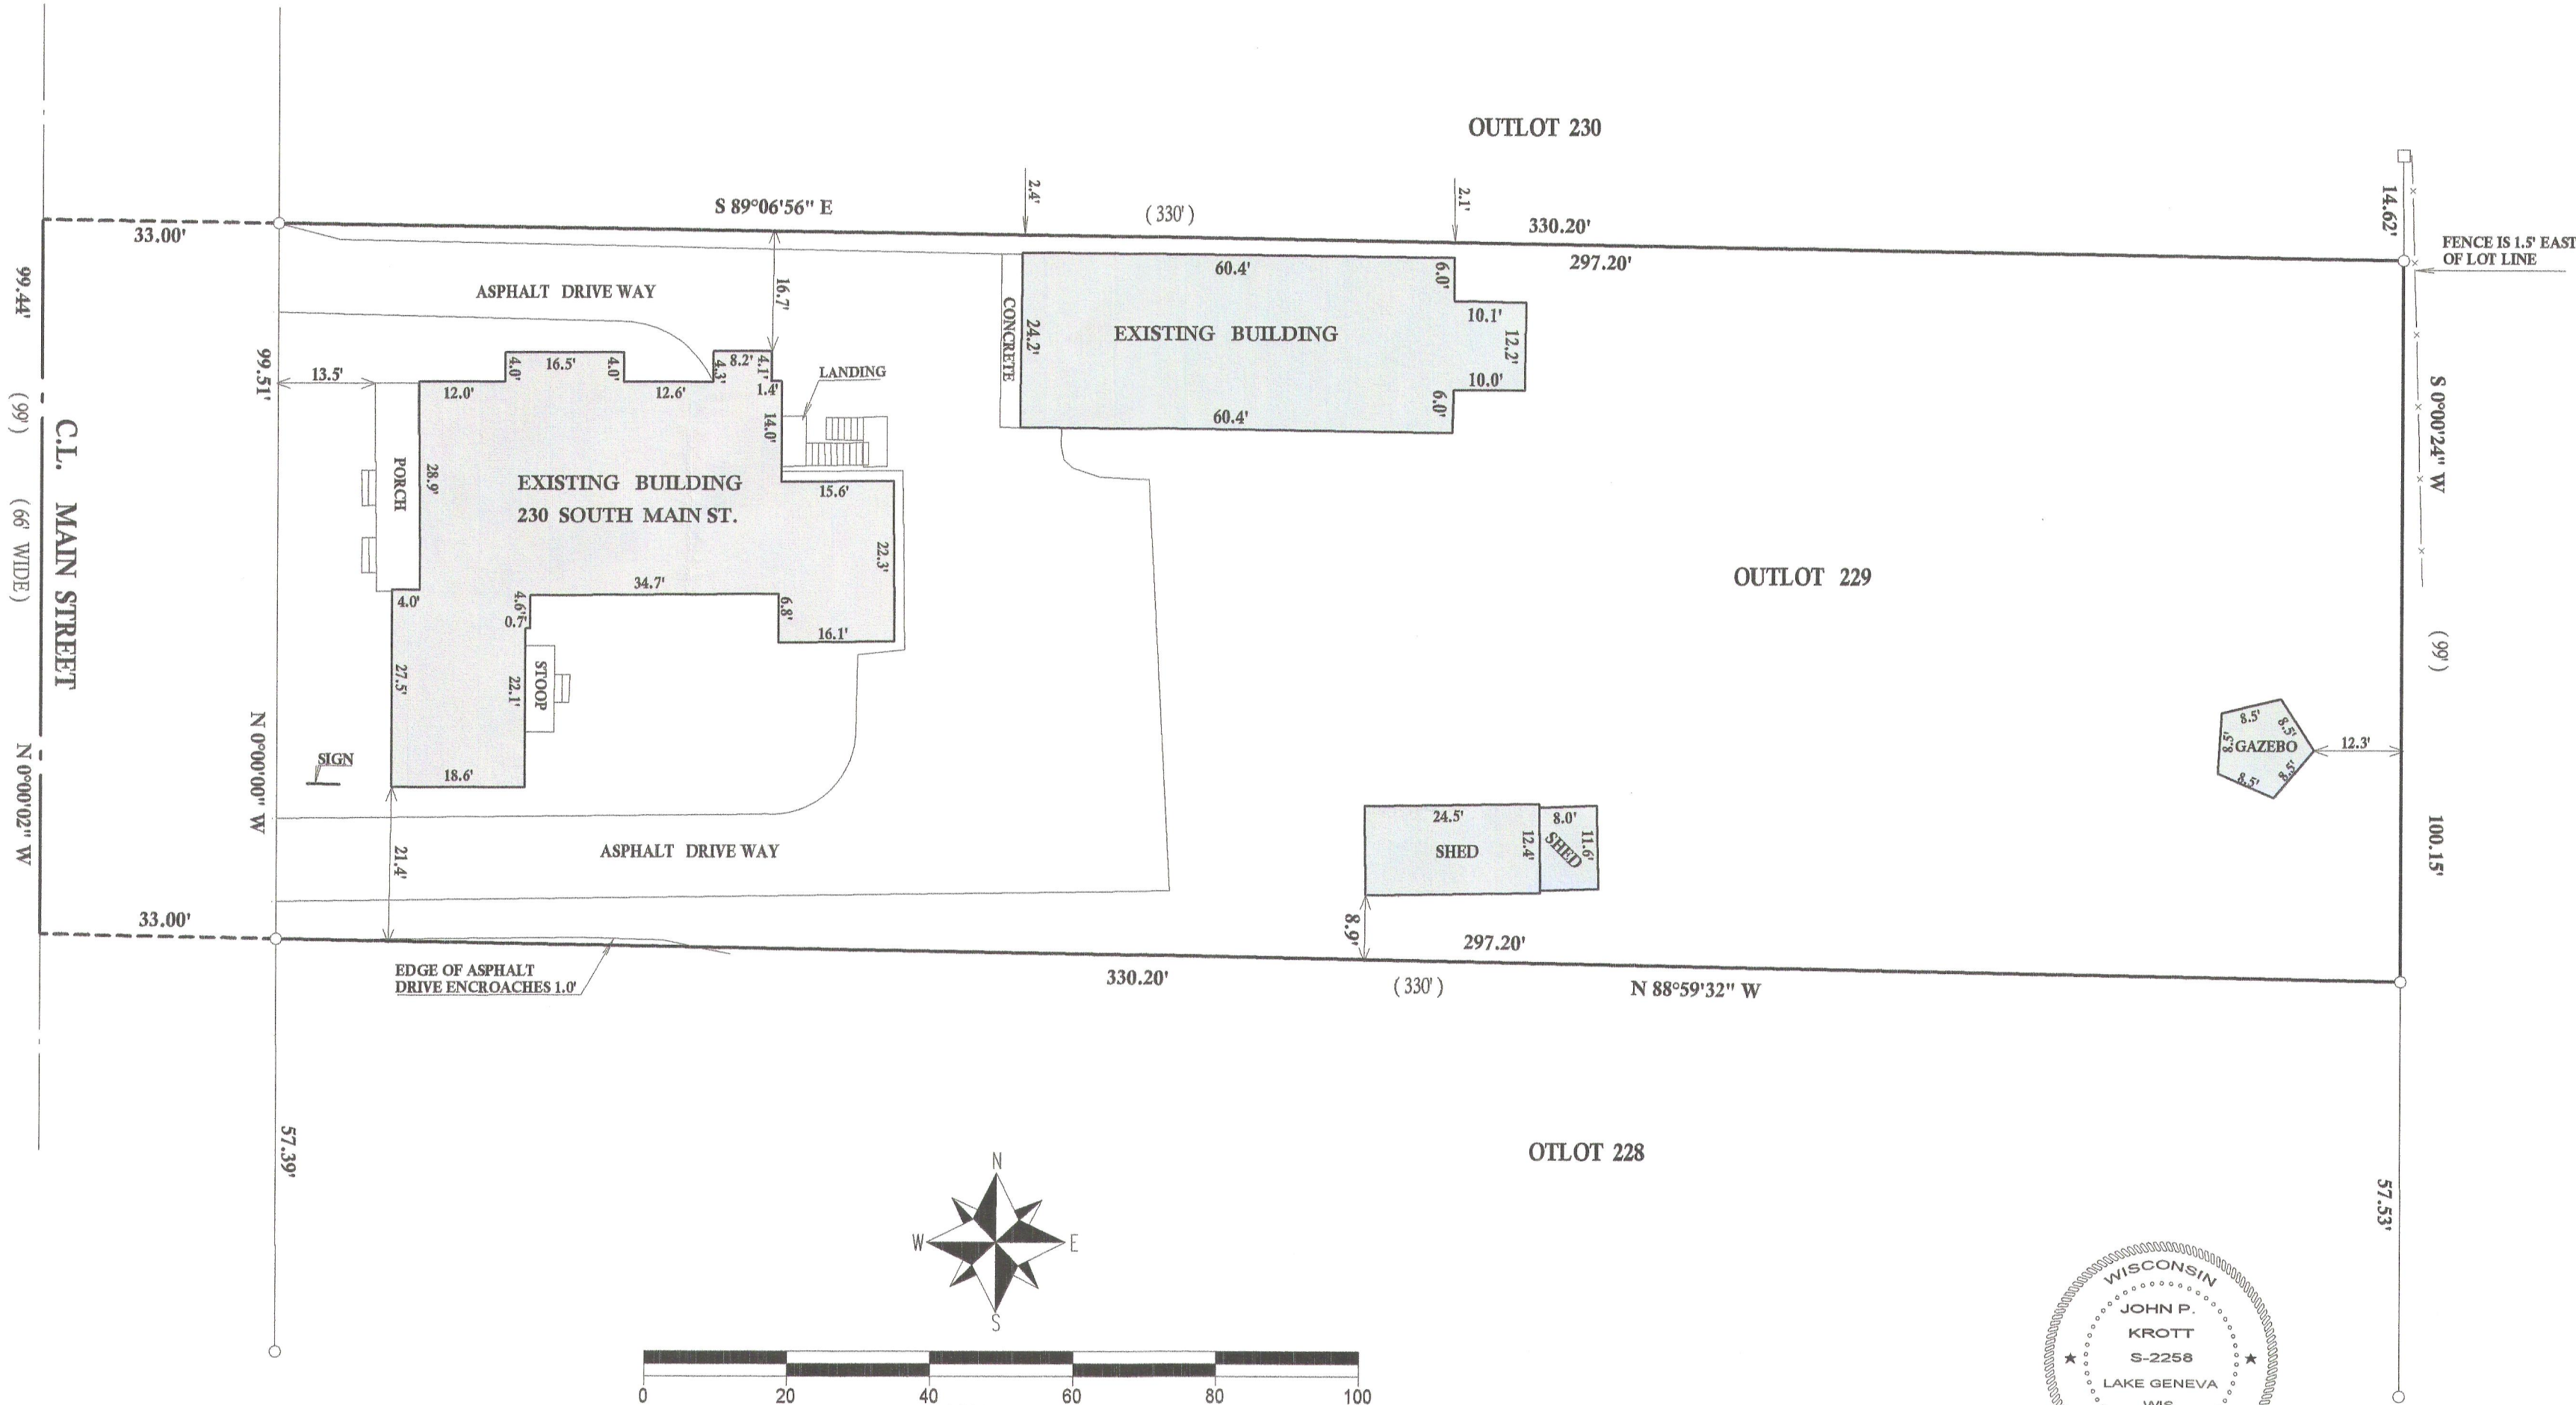


LEGEND
○ FOUND IRON PIPE
□ FOUND IRON BAR
■ SET IRON BAR
(xx) RECORDED AS

JOB # 11-173 TAX ID # VWP 00335

RECEIVED
APR 18 2012
By *SMK*

I have surveyed the above-described property and the above map is a true representation thereof and shows the size and location of the property, its exterior boundaries, the location and dimensions of all structures thereon, fences apparent easements and roadways and visible encroachments, if any.

This survey is made for the exclusive use of the present owners of the property, and also those who purchase, mortgage, or insure the title thereto within one (1) year from date hereof; and as to them I warrant the accuracy of said survey map.

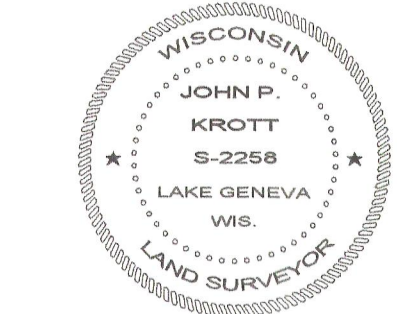

DATED THIS 6th, DAY OF DECEMBER, 2011

John P. Krott

JOHN KROTT S - 2258
Wisconsin Registered Land Surveyor
(original if signed in red)

009-1136