



FARRIS, HANSEN & ASSOCIATES, INC.

ENGINEERING - ARCHITECTURE - SURVEYING
7 RIDGWAY COURT - P.O. BOX 437 - ELKHORN, WISCONSIN 53121
PHONE: (262) 723-2098 FAX: (262) 723-5886


PLAT OF SURVEY

LOT 1 OF CERTIFIED SURVEY MAP NO. 3669

BEING A PART OF THE NW 1/4 OF THE SE 1/4 OF SECTION 22,
TOWN 1 NORTH, RANGE 16 EAST, VILLAGE OF WALWORTH,
WALWORTH COUNTY, WISCONSIN

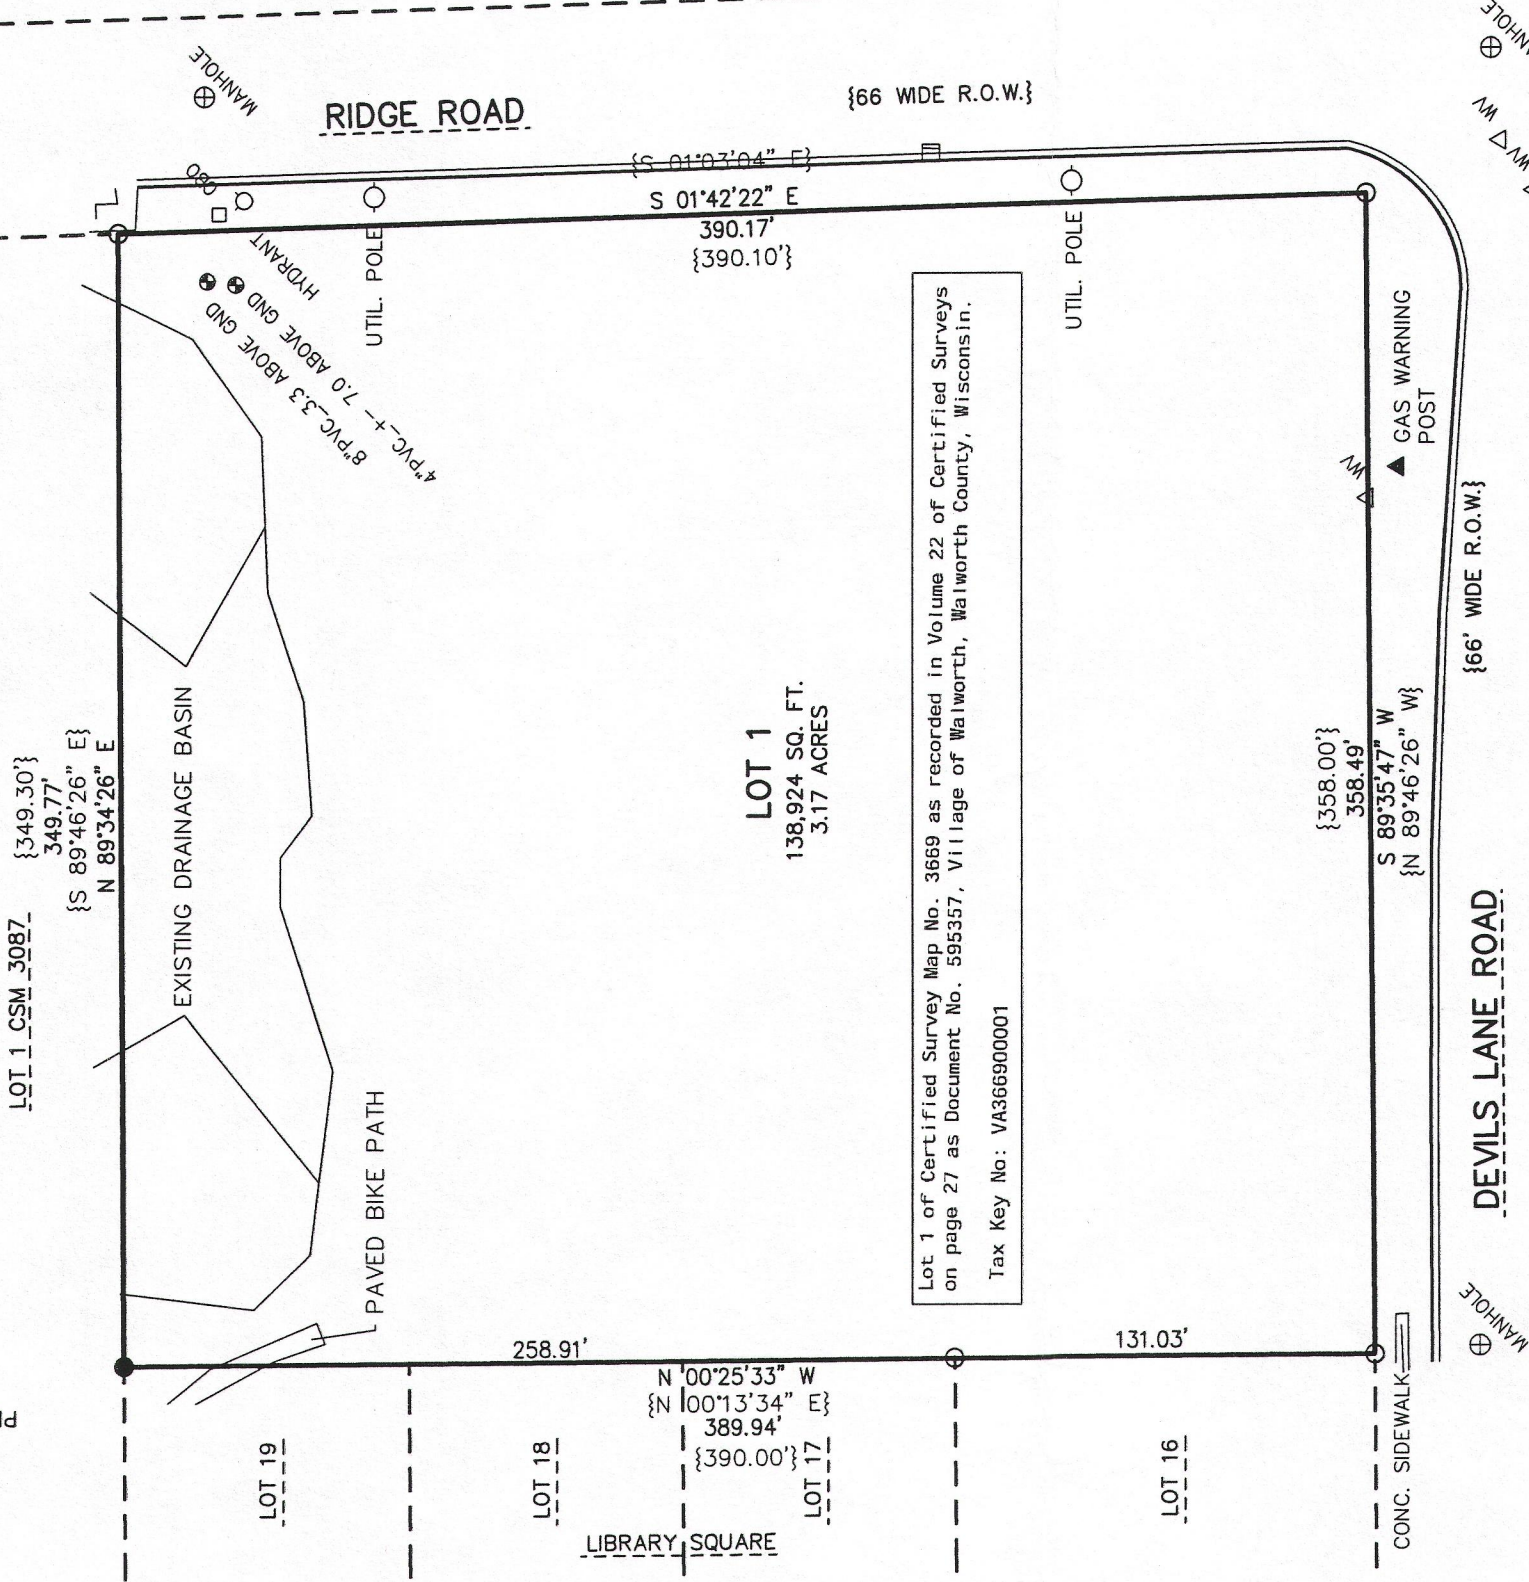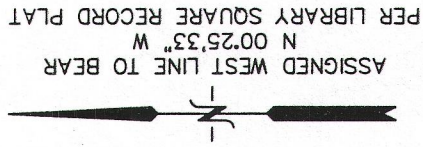

PER DOCUMENT 0597481 LOT 1 IS RESTRICTED FOR USE AS A PUBLIC LIBRARY
ANY OTHER USE SHALL REQUIRE CONSENT OF THE VILLAGE OF WALWORTH LIBRARY BOARD.
DOCUMENT NUMBER 498952 ALLOWS FOR POWER POLES IN AREA NOW BEING THE ROW FOR
RIDGE ROAD.

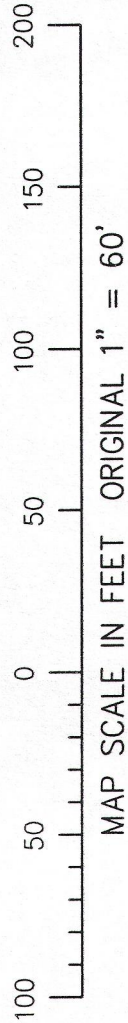

NOTE: COPIES OF THIS MAP TO WHICH THE FOLLOWING CERTIFICATE WILL APPLY SHOW
THE SURVEYOR'S ORIGINAL SEAL AND SIGNATURE IN RED INK. COPIES BY ANY OTHER
MEANS MAY HAVE ALTERATIONS WHICH DO NOT REPRESENT THE SURVEYOR'S WORK
PRODUCT.

I HEREBY CERTIFY THAT THE ABOVE DESCRIBED PROPERTY HAS BEEN SURVEYED UNDER
MY DIRECTION AND THAT THE ABOVE MAP IS A TRUE REPRESENTATION THEREOF AND
SHOWS THE SIZE AND LOCATION OF THE PROPERTY, ITS EXTERIOR BOUNDARIES, THE
LOCATION OF ALL VISIBLE STRUCTURES, AND DIMENSIONS OF ALL PRINCIPLE
BUILDINGS THEREON, BOUNDARY FENCES, APPARENT EASEMENTS, ROADWAYS, AND
VISIBLE ENCROACHMENTS, IF ANY. THIS SURVEY IS MADE FOR THE USE OF THE
PRESENT OWNERS OF THE PROPERTY, AND ALSO THOSE WHO PURCHASE, MORTGAGE, OR
GUARANTEE THE TITLE THERETO WITHIN ONE YEAR FROM THE DATE HEREOF.

DATED: MAY 8, 2013

Peter S. Gordon
PETER S. GORDON



- LEGEND
- O = IRON PIPE STAKE FOUND
 - = IRON REBAR STAKE FOUND
 - Δ = WATER VALVE
 - {XXX} = RECORDED AS PER C.S.M.
 - WORK ORDERED BY -
THE RAULAND AGENCY
PO BOX 159
WALWORTH, WI.

PROJECT: 8788
DATE: 5/8/2013
SHEET 1 OF 1

MAY 10 2013

VA366900001

009-1162