


KROTT SURVEYING INC.
N3705 WILLOW BEND LANE
LAKE GENEVA WI 53147
PHONE # (262)248-3697
FAX # (262)249-0639

-OF-

THE EAST 66 FEET OF THE FOLLOWING DESCRIBED REAL ESTATE, TO-WIT:
COMMENCING 41 2/3 RODS WEST OF THE QUARTER POST BETWEEN
SECTIONS 21 AND 22 IN TOWNSHIP 1 NORTH, RANGE 16 EAST, THENCE
SOUTH 12 RODS, THENCE WEST 11 RODS, THENCE NORTH 12 RODS, THENCE
EAST 11 RODS TO THE PLACE OF BEGINNING, IN THE VILLAGE OF WALWORTH
WALWORTH COUNTY, WISCONSIN.

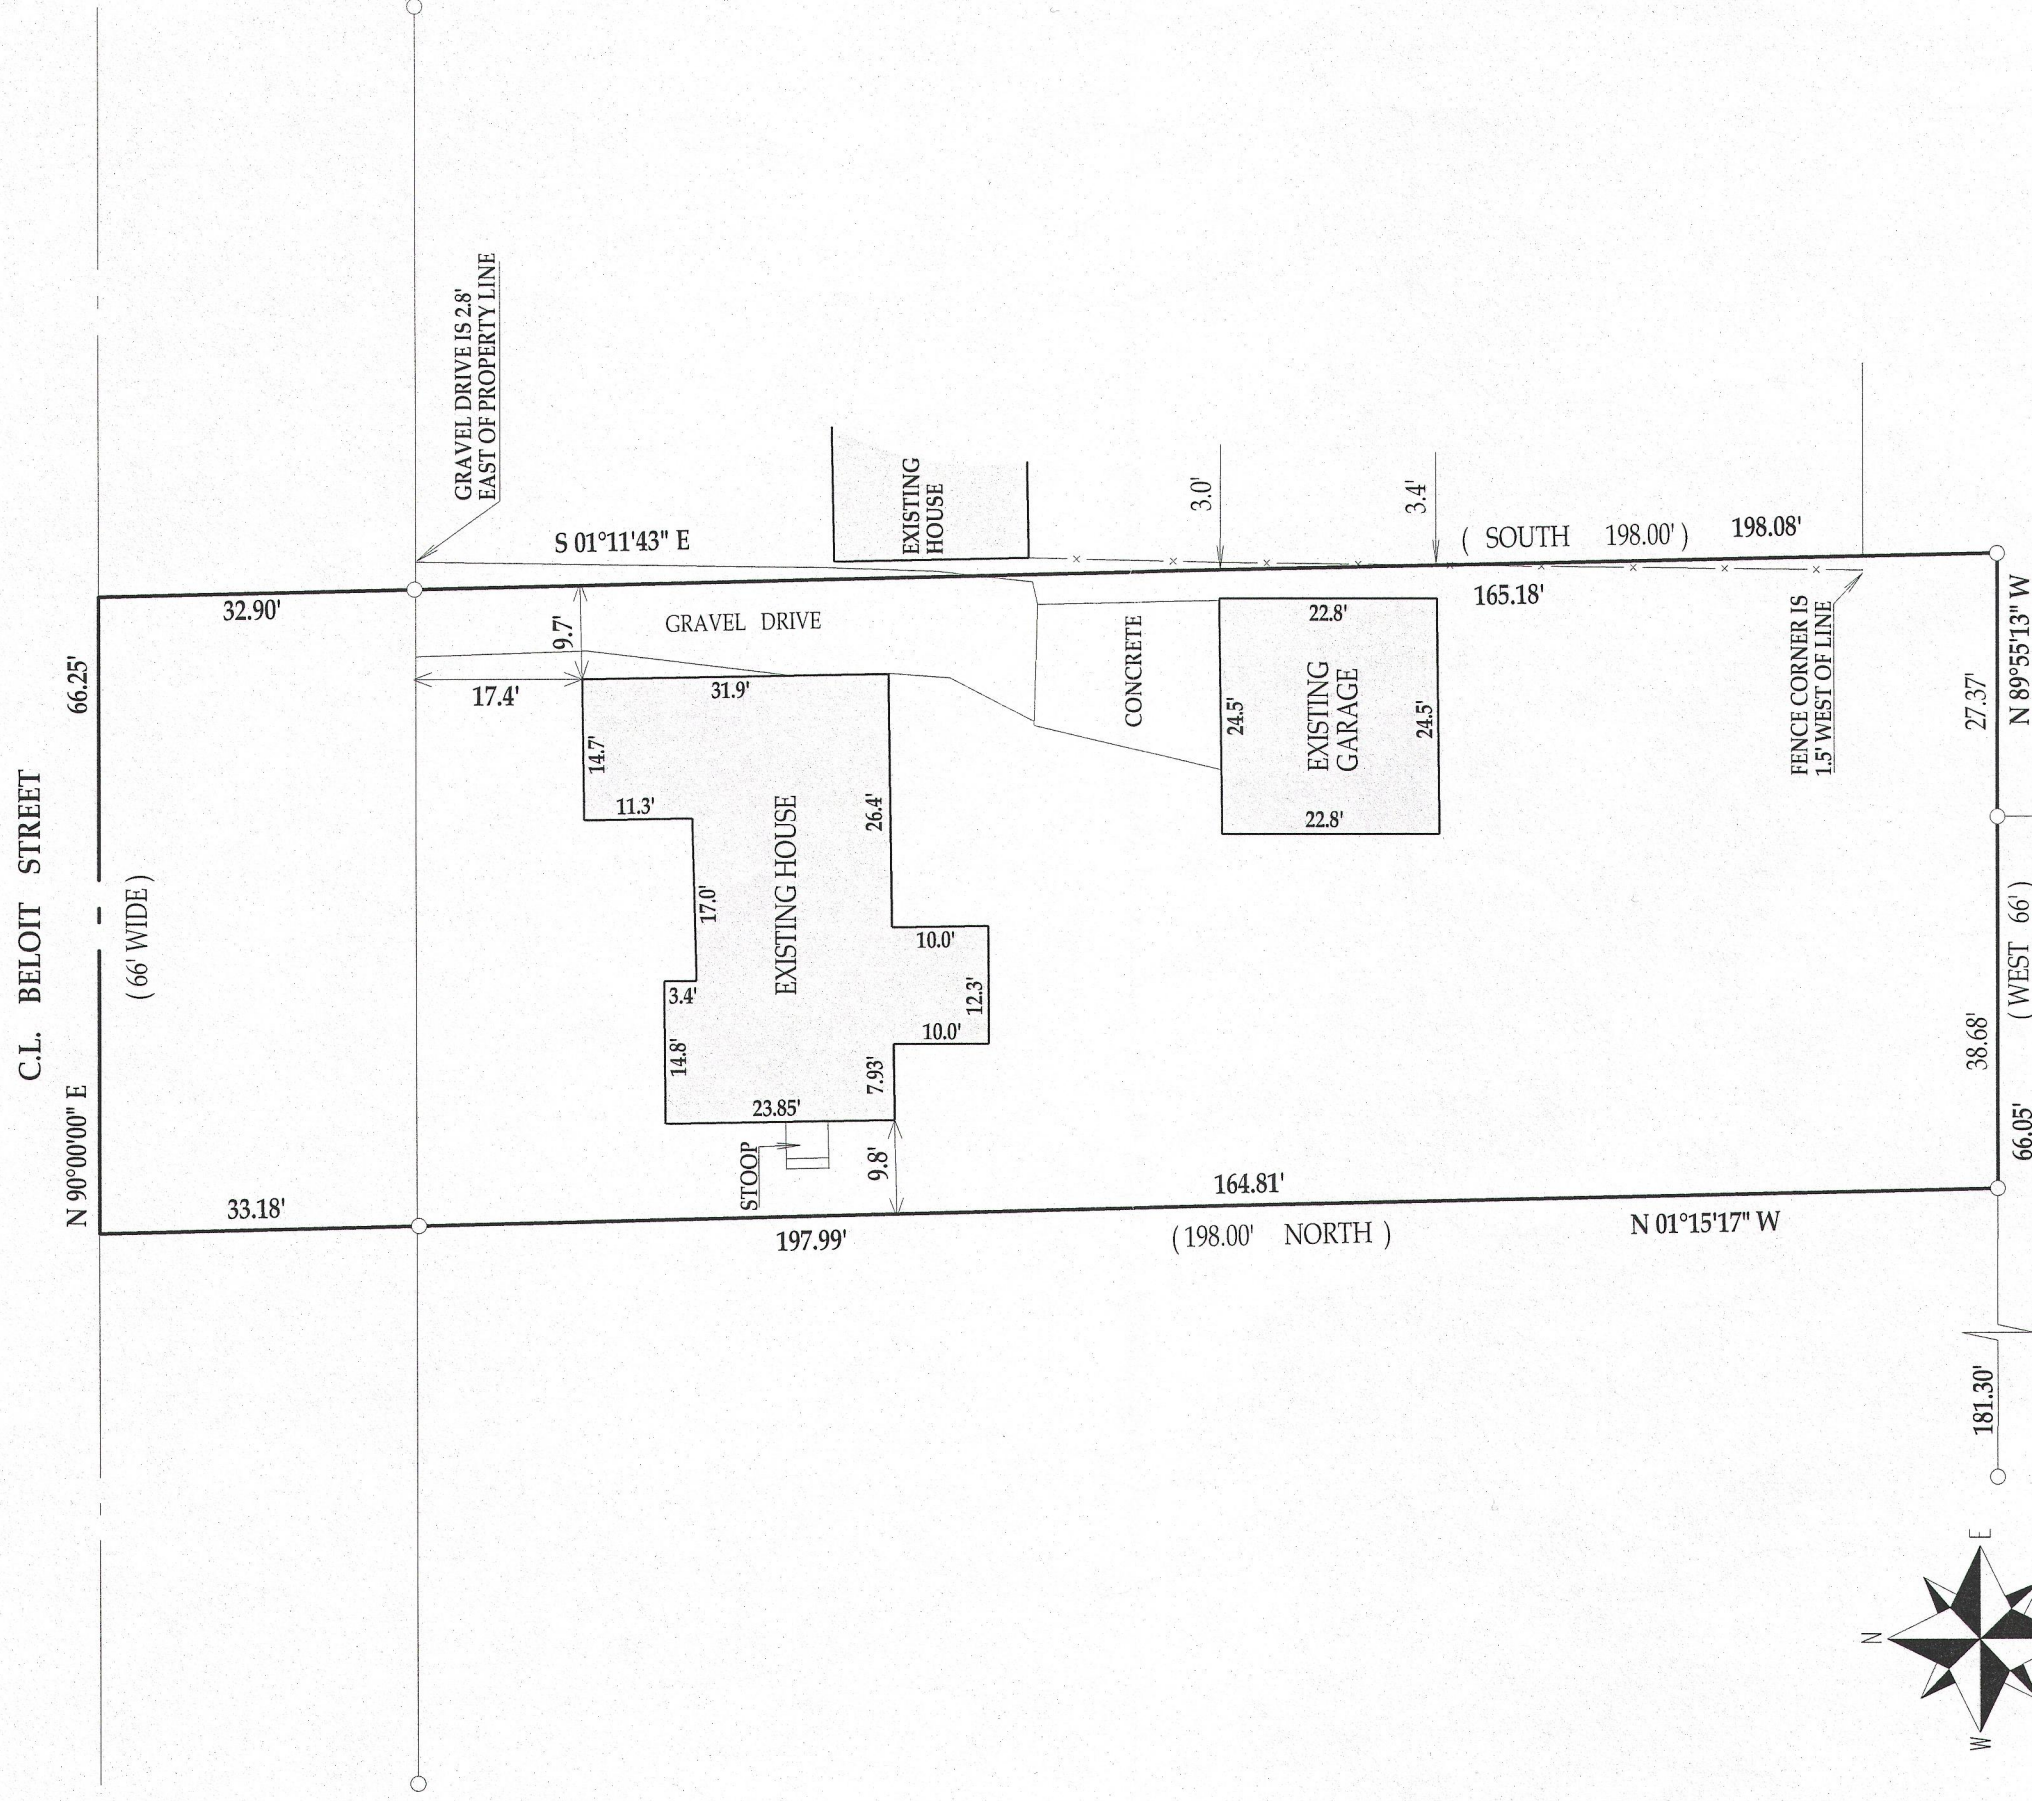

SCALE 1" = 20'

LEGEND

- FOUND IRON PIPE
- FOUND IRON BAR
- SET IRON BAR


(XX) RECORDED AS

IOB # 13-088 TAX ID # VWP00077



I have surveyed the above-described property and the above map is a true representation thereof and shows the size and location of the property, its exterior boundaries, the location and dimensions of all structures thereon, fences apparent easements and roadways and visible encroachments, if any.

This survey is made for the exclusive use of the present owners of the property, and also those who purchase, mortgage, or insure the title thereto within one (1) year from date hereof; and as to them I warrant the accuracy of said survey map.

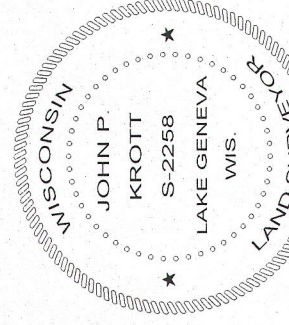

DATED THIS 25th, DAY OF JUNE, 2013

JOHN KROTT S - 2258
Wisconsin Registered Land Surveyor
(original if signed in red)

009-1163