


ORDERED BY
ALLISON OLESTON
KEEFE REAL ESTATE
LAKE GENEVA, WI.

PLAT OF SURVEY

- OF -

PATHFINDER SURVEYING INC.
(formerly)
J.K. SURVEYING INC.
P.O BOX 322
LAKE GENEVA, WI. 53147
WWW.PATHFINDERSURVEYING.NET
262-248-8303

LOT 11 IN BLOCK 3 OF BIGFOOT RIDGE OF WALWORTH ADDITION
No. 1, AS RECORDED IN CABINET C OF PLATS, SLIDE 19 AS DOCUMENT
No. 398979, VILLAGE OF WALWORTH, WALWORTH COUNTY, WISCONSIN.

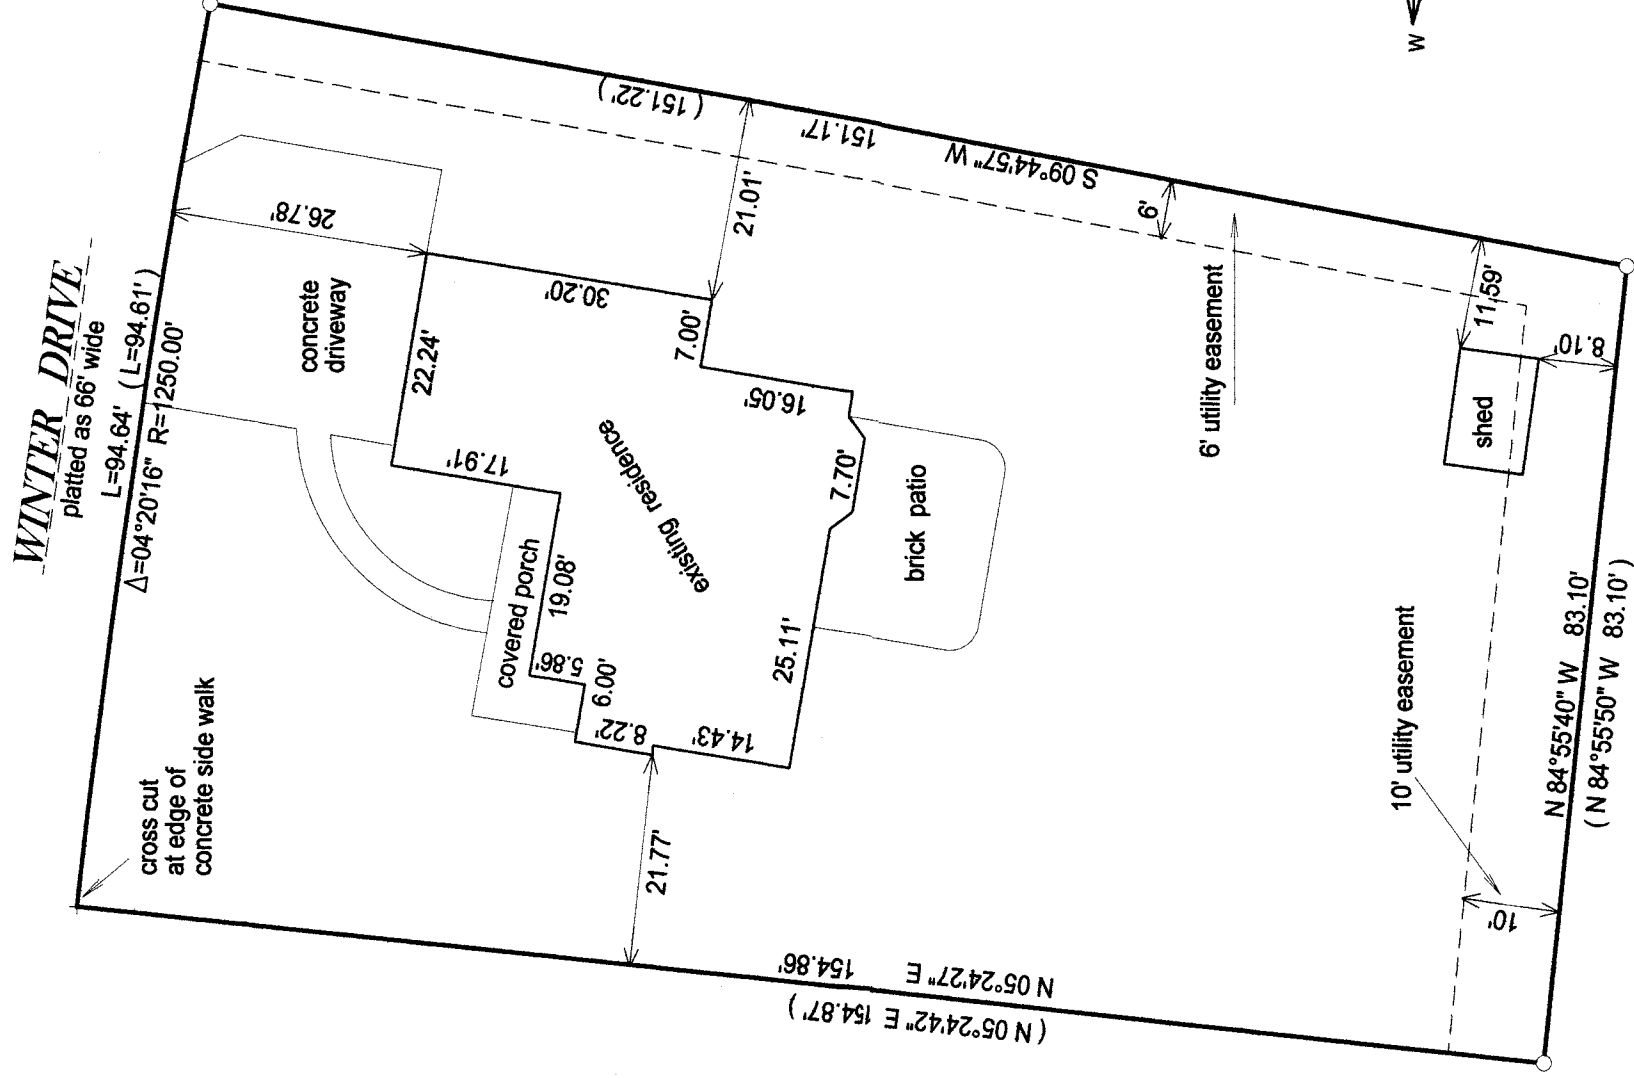

- () = recorded as
□ = found iron bar
○ = found iron pipe
● = set iron pipe
■ = set iron bar

SCALE 1" = 20'

JOB # 13-222


TAX ID #
VBIG1 00011

BASIS OF BEARING OF THIS PLAT: THE SUBDIVISION PLAT
OF RECORD.


I hereby certify that I have surveyed the above-described property and the above map is a true representation thereof and shows the size and location of the property, its exterior boundaries, the location and dimensions of all structures thereon, fences, apparent easements and roadways and visible encroachments if any.

This survey is made for the present owners of the property, and those who purchase, mortgage, or guarantee the title thereto, within one year from the date hereof.

DATED THIS 26th day of October, 2013.

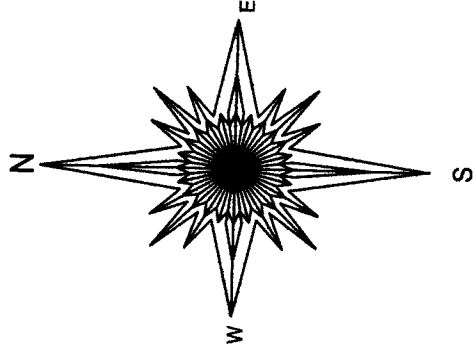

RECEIVED
JUN 13 2014
By *[Signature]*

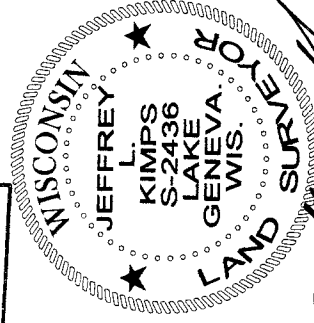

[Signature]
JEFFREY L. KIMPS S - 2436
Wisconsin Registered Land Surveyor
(original if signed in red)

VBIG1 -11 009-1193