


WEST 1/4 CORNER
OF SECTION 22
T1N R16E

E KENOSHA STREET

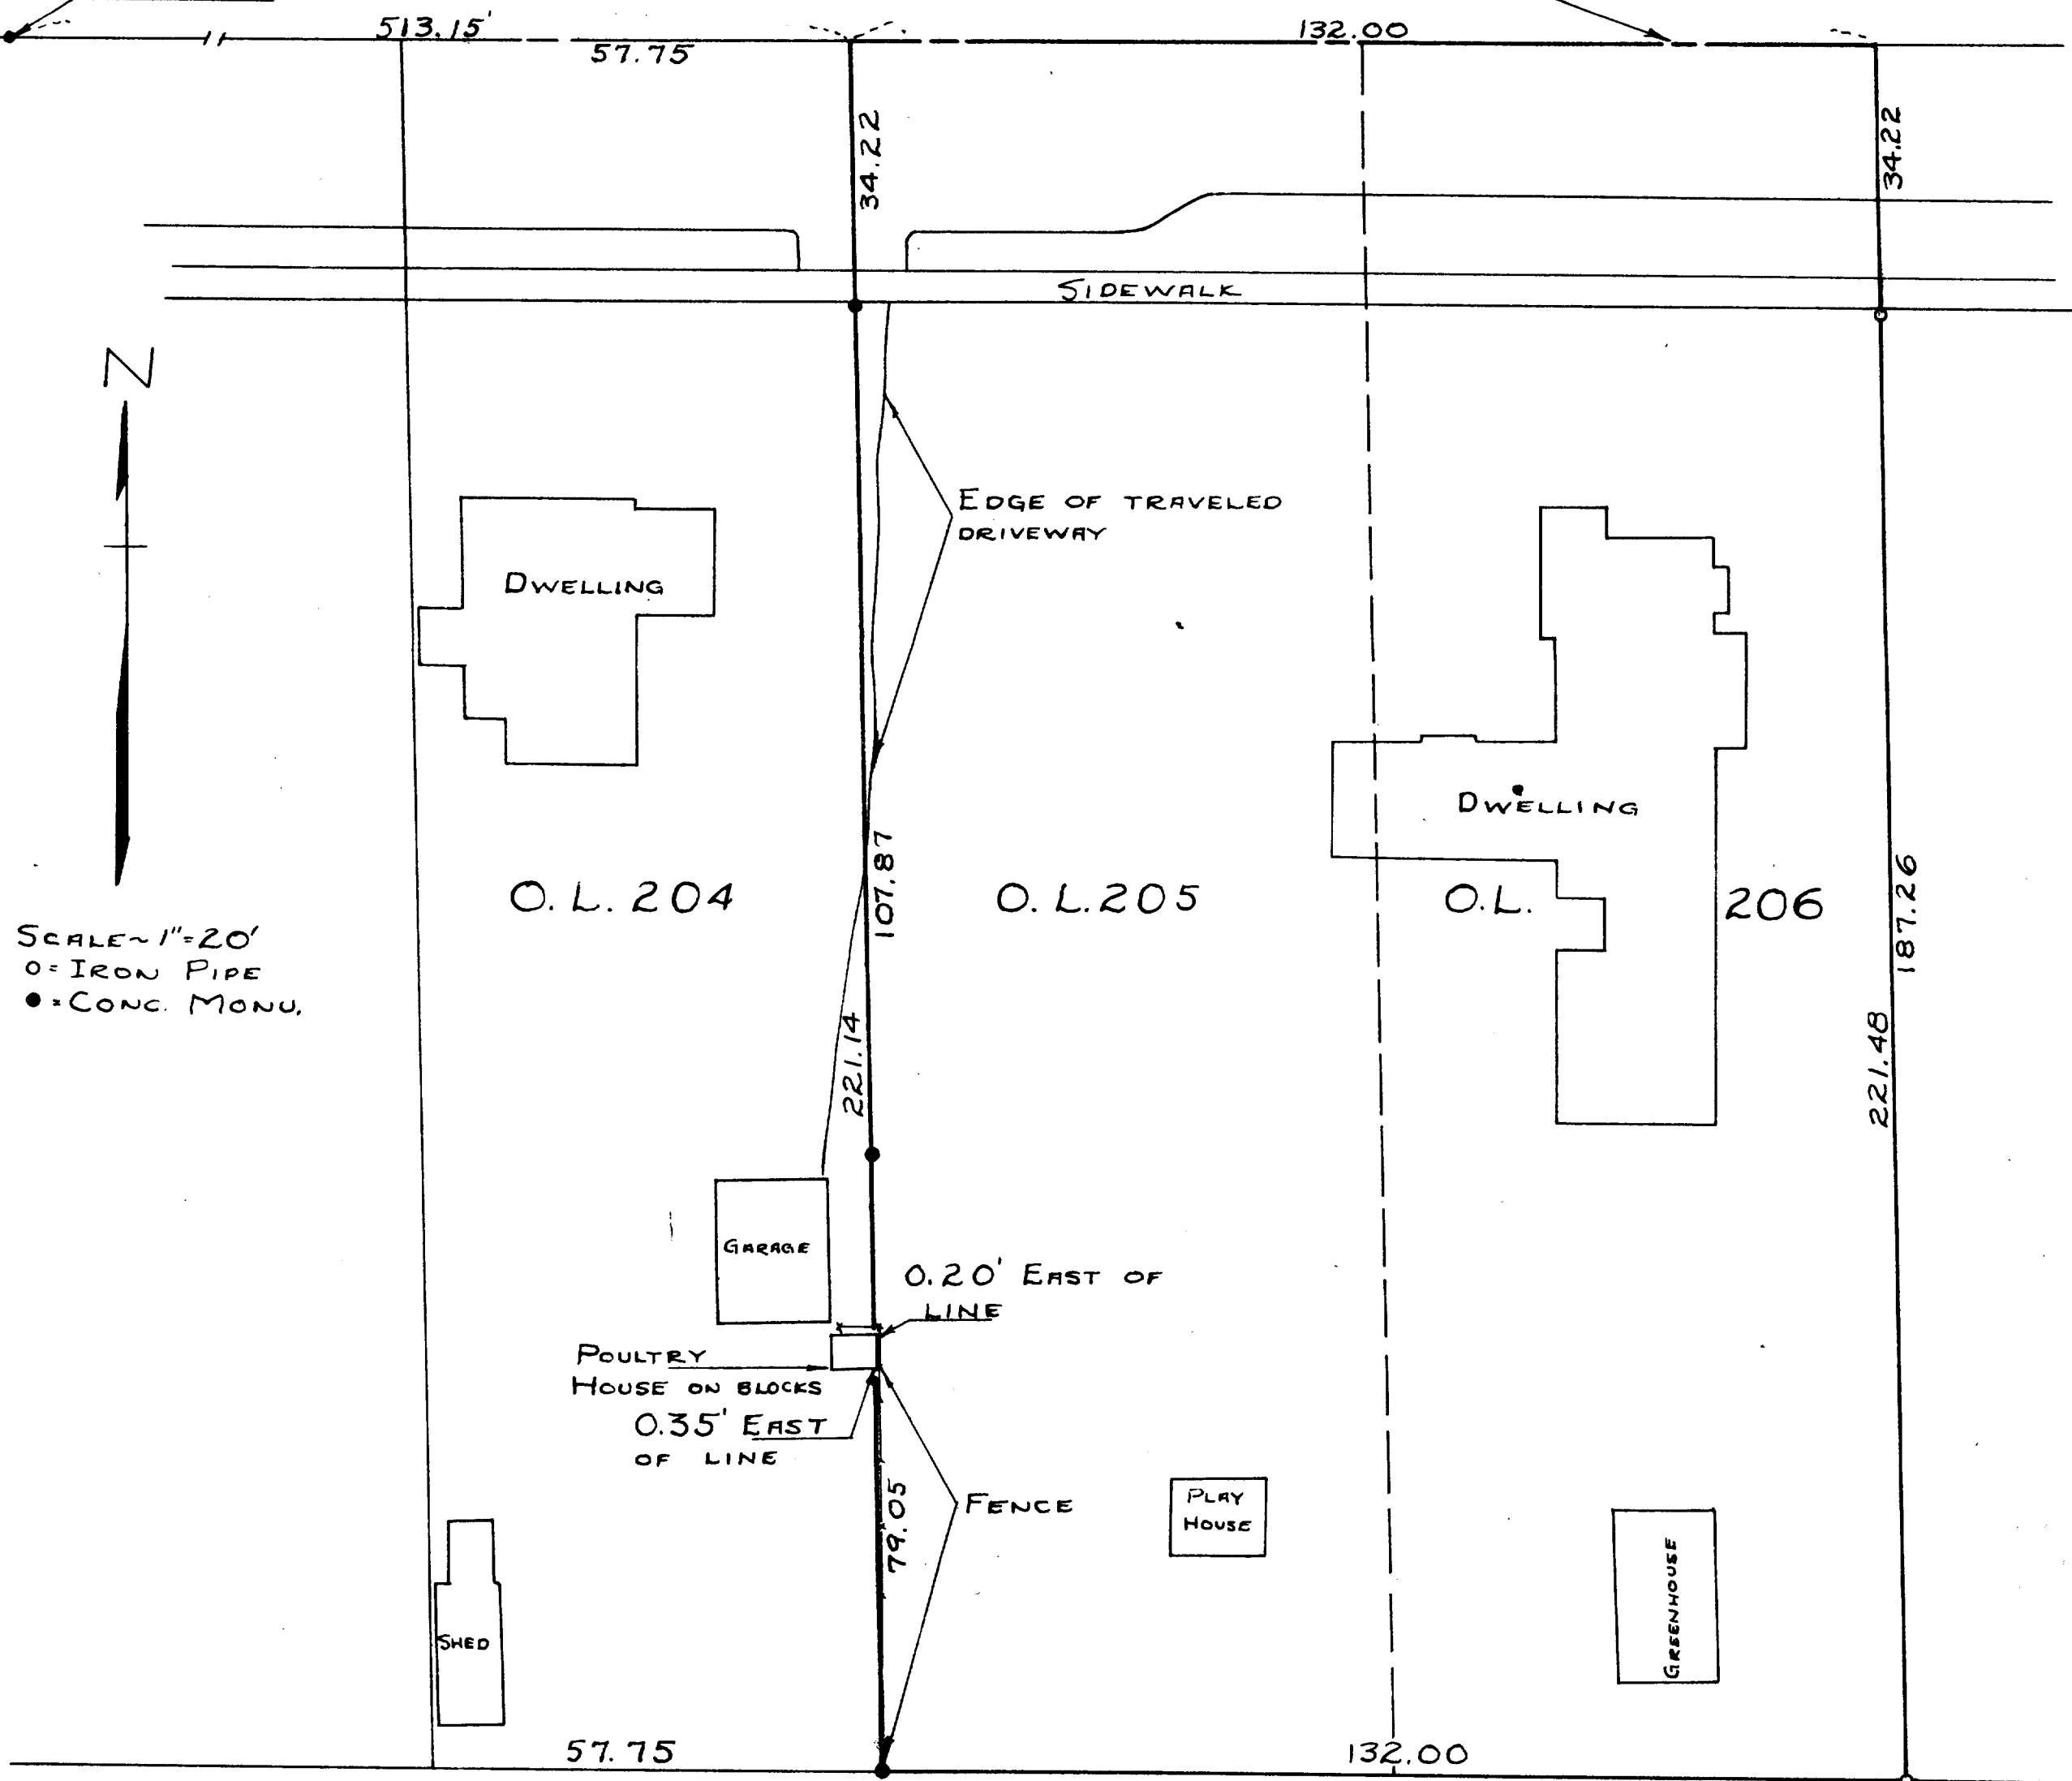

PLAT OF SURVEY OF OUTLOTS 205 AND 206 AND THE LOCATION OF BUILDINGS
ON OUTLOTS 204, 205, AND 206, LOCATED IN THE VILLAGE OF WALWORTH,
WALWORTH COUNTY, WISCONSIN.

JANUARY, 1949

Lloyd L. Jensen
COUNTY SURVEYOR

9-115