



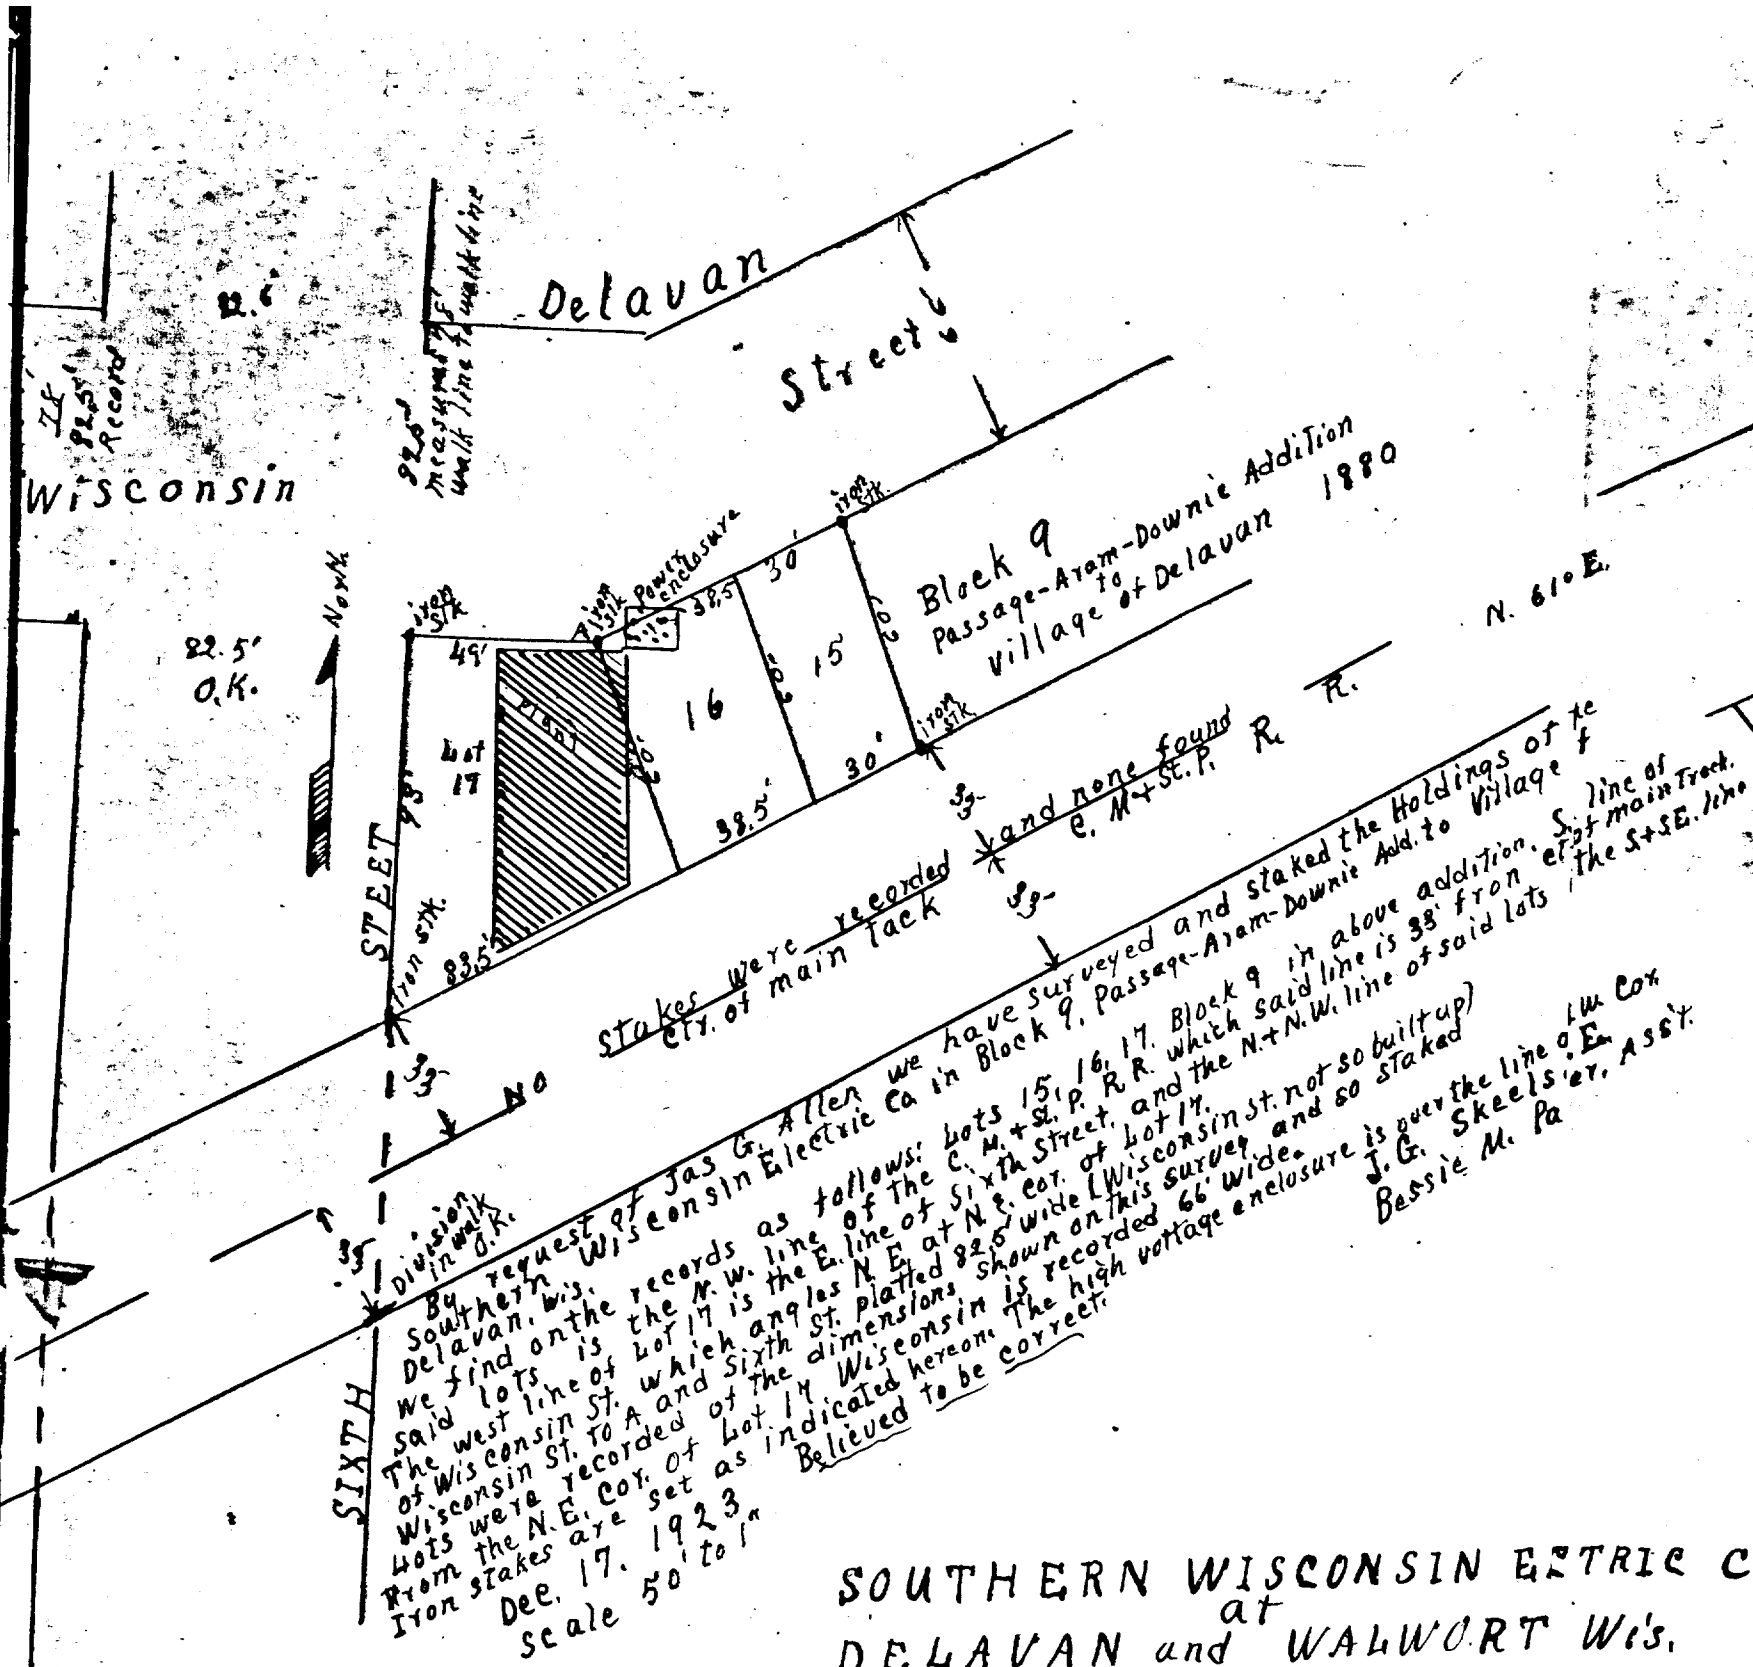


SOUTHERN WISCONSIN ELECTRIC COMPANY
at
DELANAN and WALWORTH Wis.

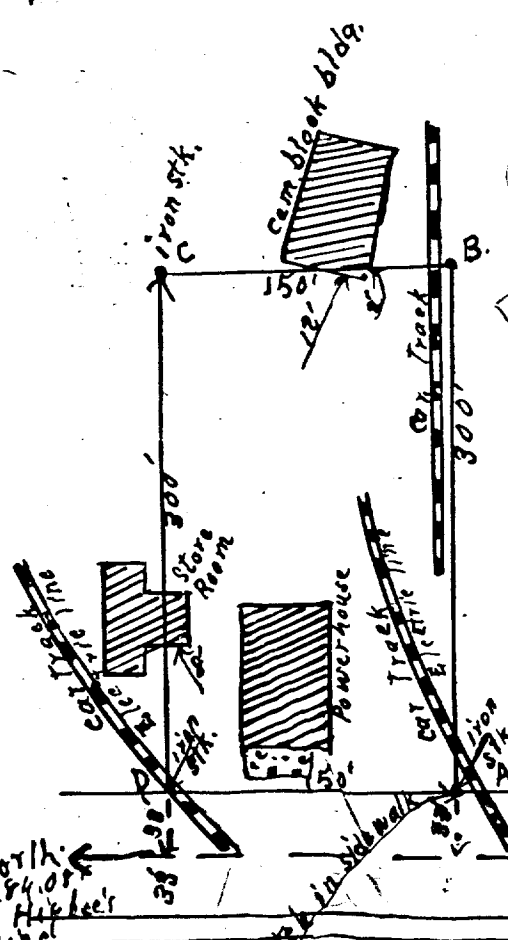

By request of Jas. G. Allen, V. Pres. we have surveyed and staked the tract of land hereon shown according to the recorded description of the south line of the H. & W. Co. to which lines AB & CD were said to be parallel and appeared entirely to be the W. line of Sect. 22, T. 1 N. R. 16 E. Recorded description says, begin at a point in the line of Sect. 22, T. 1 N. R. 16 E. 33 rods 3/4 ft. (1538 ft.) N. of the W. 1/4 cor. thence E. parallel to the S. line 300' thence N. 160 ft. thence W. parallel as before 300' to W. line thence S. 160 ft. to place of beginning. Iron stakes are set at points A, B, C & D. Lines AB & CD are parallel and at right angles to W. line of Section. Cement block bldg + store room are over the line shown.
Dec. 17, 1923
Scale 100' to 1"
J. G. Skeels, C. E.
Bessie M. Palmer, Asst.

West line sect. 22, T. 1 N. R. 16 E. — — — — — 93 rods 3/4 ft. (1538 ft.)
MAIN
Walworth, Wis

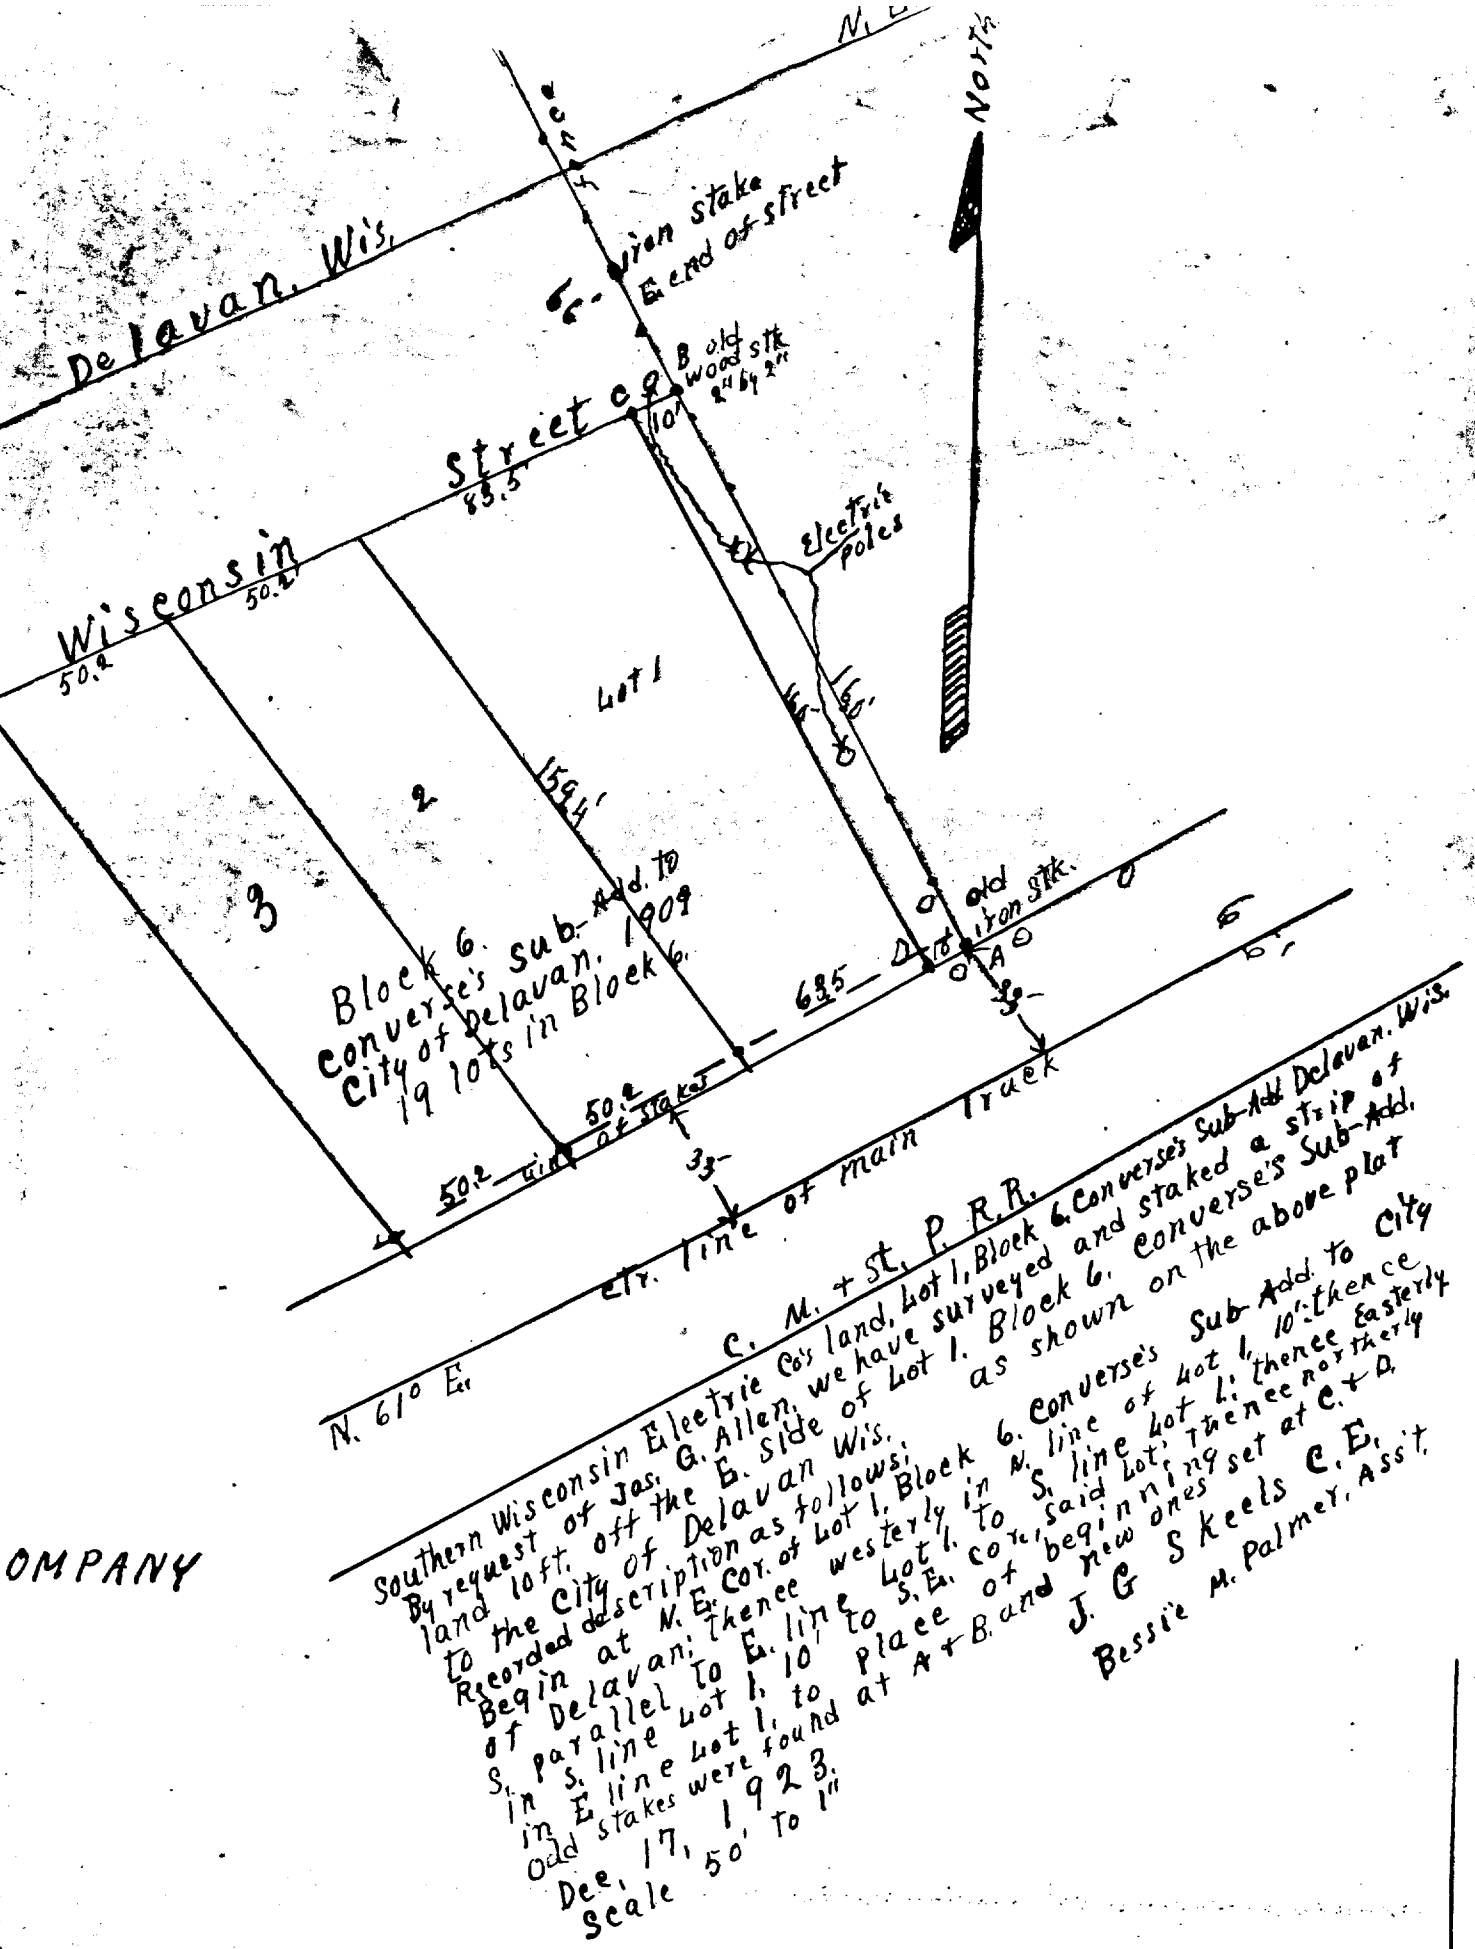

Southern Wisconsin Electric Co. land, lot 1, Block 6, Converses Sub-Add. Delavan, Wis. By request of Jas. G. Allen, V. Pres. we have surveyed and staked a strip of land hereon shown according to the recorded description of the south line of the H. & W. Co. to which lines AB & CD were said to be parallel and appeared entirely to be the W. line of Sect. 22, T. 1 N. R. 16 E. Recorded description says, begin at a point in the line of Sect. 22, T. 1 N. R. 16 E. 33 rods 3/4 ft. (1538 ft.) N. of the W. 1/4 cor. thence E. parallel to the S. line 300' thence N. 160 ft. thence W. parallel as before 300' to W. line thence S. 160 ft. to place of beginning. Iron stakes are set at points A, B, C & D. Lines AB & CD are parallel and at right angles to W. line of Section. Cement block bldg + store room are over the line shown.
Dec. 17, 1923
Scale 100' to 1"
J. G. Skeels, C. E.
Bessie M. Palmer, Asst.

E. 1/4 sec. line 22-1-16

KENOSH A ST Walworth Wis.
as built up 70' wide

35' 35'
1/4 sec. cor.
Covered by
Pavement

58

12/15/23.

Copy of
DeLaan

Lot 1: Begin at N.E. Cor.
to C/P of DeLaan, W.
to S. line Lot 1. easterly
to beginning. Lot 1. 83.7'
Wis. street N. (66' wide)
Mon. at S. W. cor. lot
where iron or other material
Ray St. 66' wide
Passage - Tram
Block 9 Lots 16, 17.
Wis. St. at 6th St. 82.3'
Lot 17 N. 49' S. 83.5' W. 93'
Lot 16 N. 38.5' S. 38.6' Lot

See plat

Walworth, 1928.
83 rods $3\frac{1}{2}$ N. of N. 1/4
E. 300 #11 to Higbee
W. as before 300' S.
Higbee & line 1972.06
Surveyed Dec. 17.

Lots 16, 17, 18, 19, are parall.
line. Wis. St. 78'
Power cage at N.W.
S. line 38' N. of ctr. of
10' off E. side lot
Stake at N.E. & S.E.

records of Electric Light prop at
Walworth.

Lot 1 B. 6. Converse's Sub-AD.
in N. line Lot 1. 10' S. 11 E. line 1
10' to S.E. Cor. of 1. N in E. line. 160'
N. line 63.5' S. line.
iron stk central at E. end. of St.
19. Wood stks at all cors. except
stks $5\frac{1}{2}$ " x $3\frac{1}{4}$ " x $3\frac{1}{4}$ " pine. Platted in 1909
Fremont 63. stks on R.R. line 6' more or less
Downie

wide at Lot 15 66'
8.60.
15' 30' x 60'

Cor. 22-1-16
S. line N. 11 Sect. line 140'
in Sect. line 140'.
N. of 1/4 cor.
1923. as described above.

pl. to R.R. No stks over R.R.
wide as built up.
Cor. in street
Main track.
B. 9. Converse & O.K.
Cors. found.

Walworth
12/15/23

59

Walworth lot,
E & W lines set
No stakes found.
Iron stake set at
S. E. cor.
Store house 8' over
Cem. Block Bldg. 2'
Center of Kenosha St.
at Main St. and west

Higbee's line gone
at it is to W. line set at
walk line and at N.E.
north line
over at E. line at S.W. cor
taken as 1/4 line & etc.
line of section

Lindquist

Race line

300	5.5	51.26
400	6.25	50.51
500	6.90	49.84
600	7.25	49.51
624	7.74	50.02
100	7.75	49.01
100	8.40	48.46
100	8.70	48.06
200	9.49	47.47
300	10.1	46.65
400	9.78	46.98

Side
E. side
Creek line

500	11.37	45.47
600	11.21	45.49
500	11.37	45.47
400	11.37	45.47

culvert

Walworth
Village