


GEORGE T. DUNHAM
SURVEYOR & ENGINEER
DELAVER, WISCONSIN

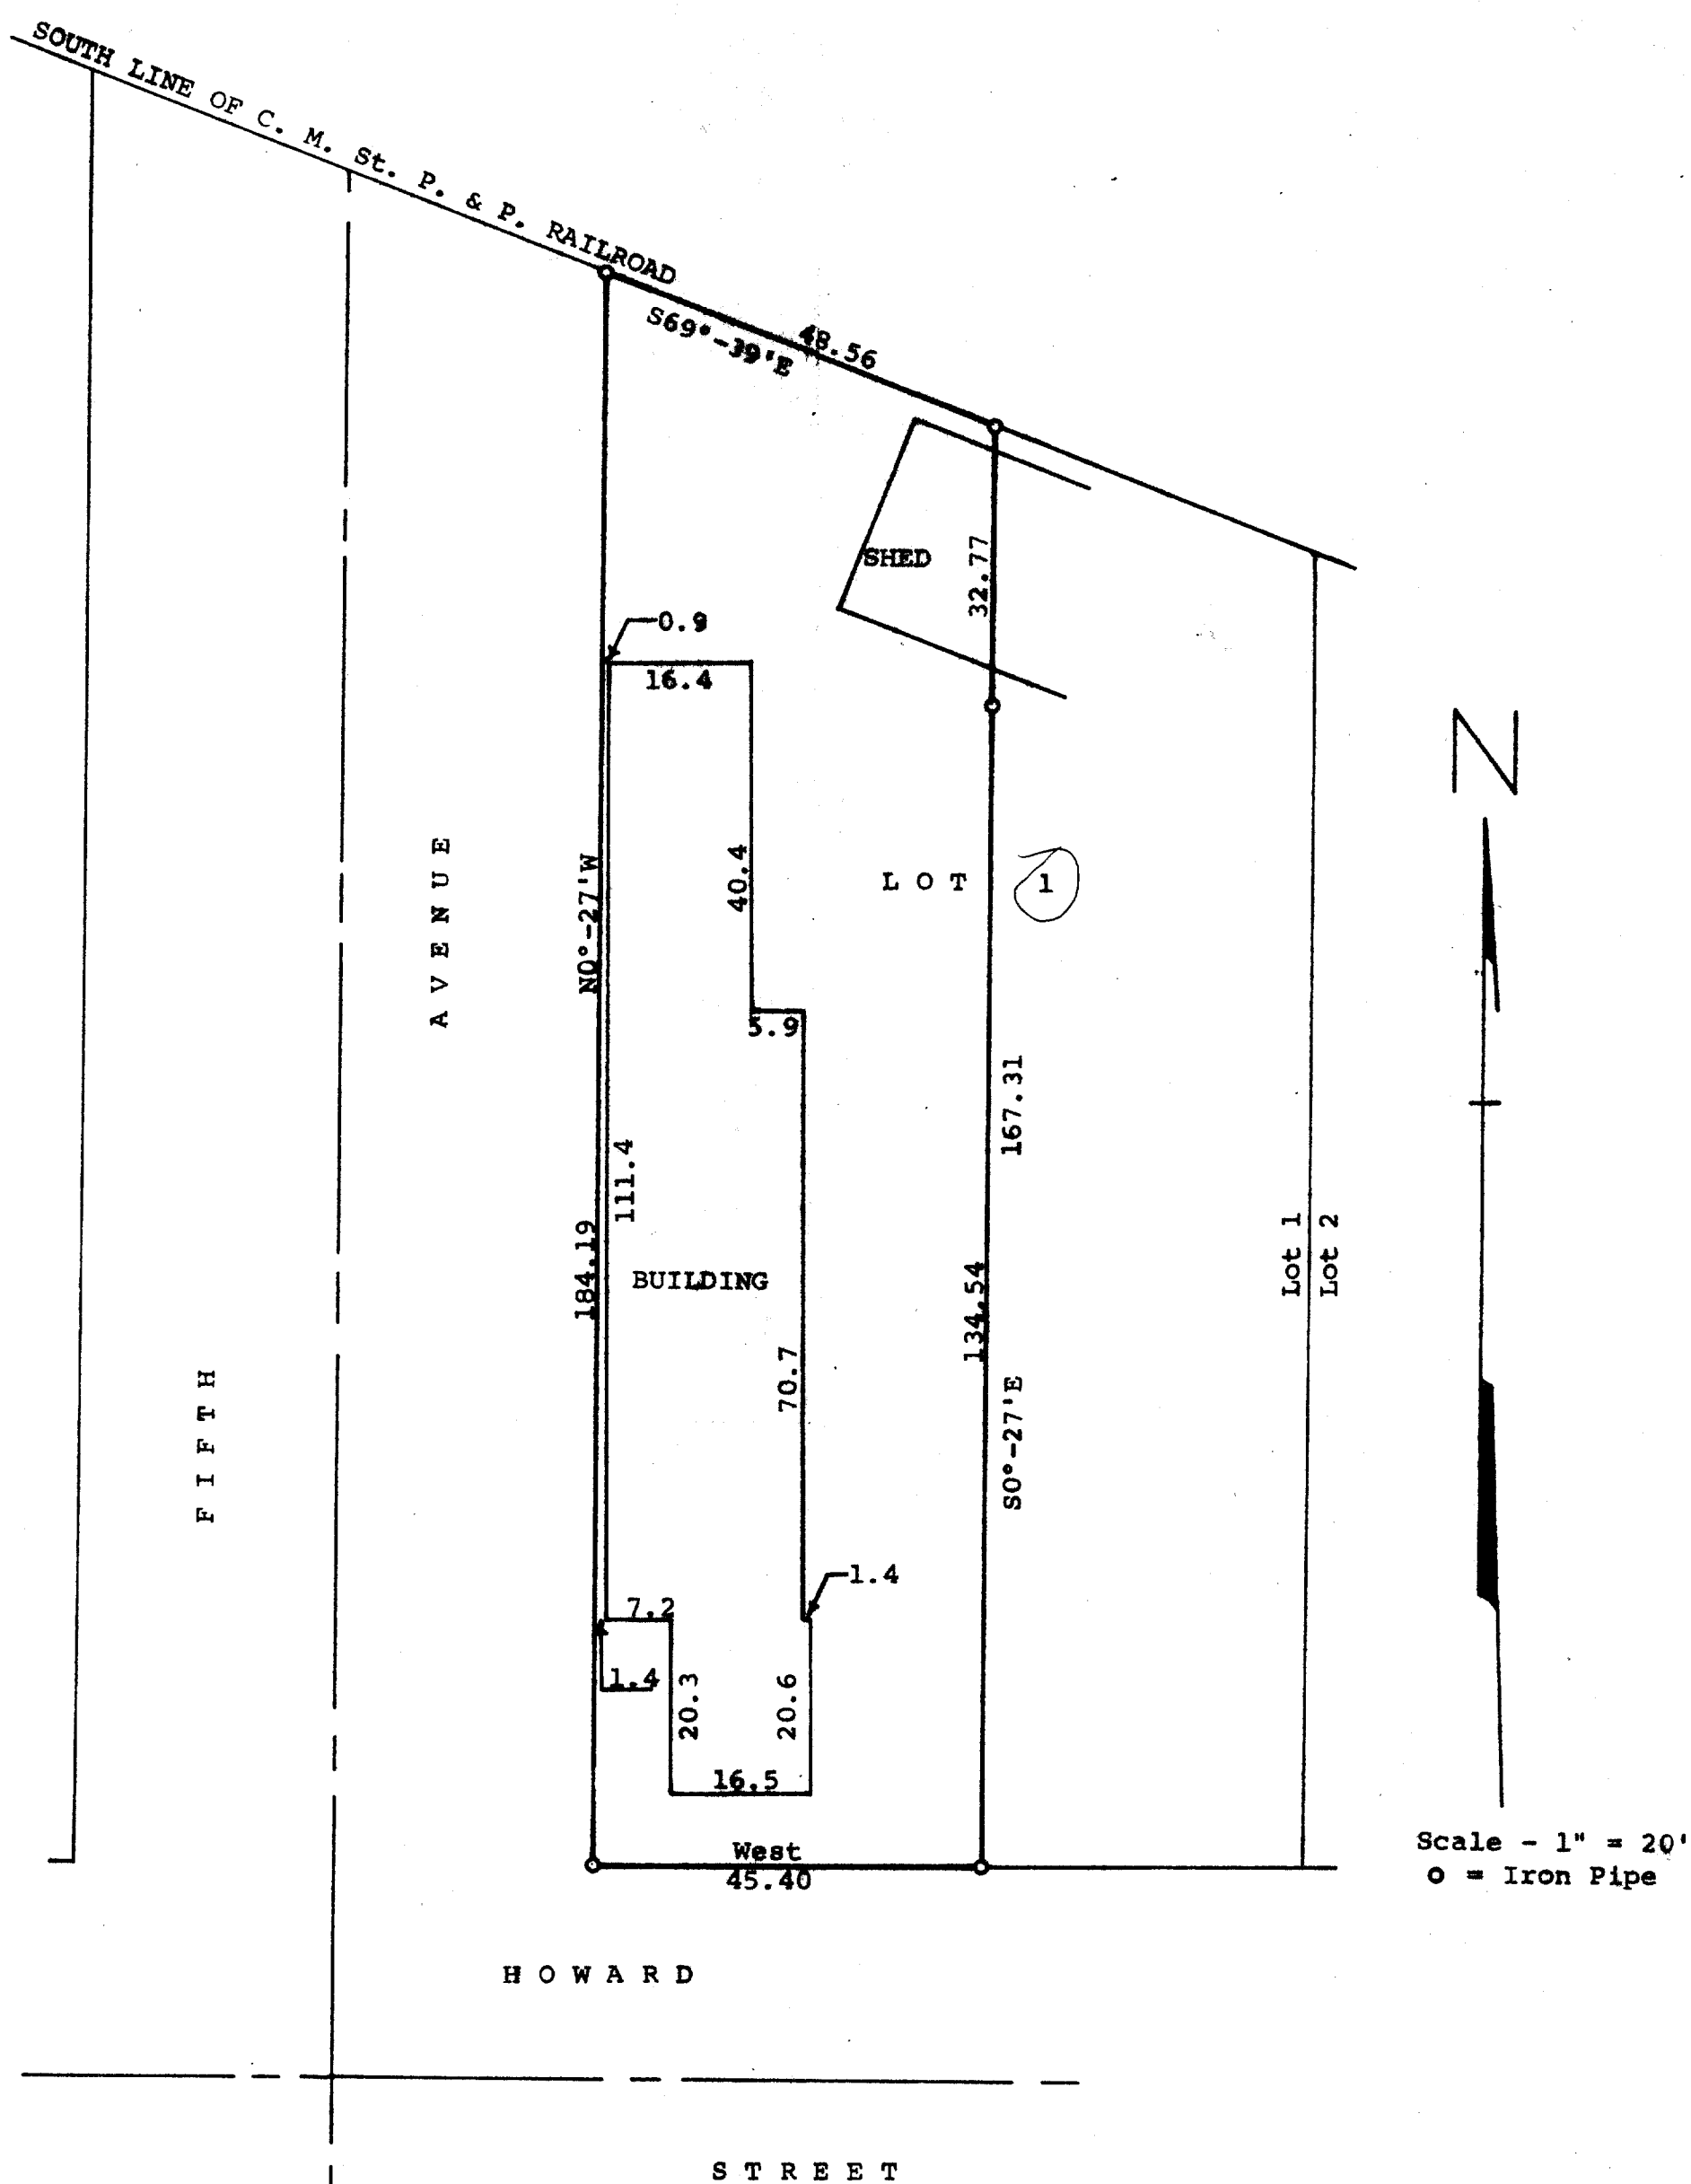

Plat of survey of a part of Lot 1 in Block 2 of
E. W. Crumb's Addition to the Village of Walworth,
Walworth County, Wisconsin.
May 30, 1974

George T. Dunham
George T. Dunham, Surveyor

