

FARRIS, HANSEN & ASSOCIATES, INC.

ENGINEERING - ARCHITECTURE - SURVEYING
7 RIDGWAY COURT - P.O. BOX 437 - ELKHORN, WISCONSIN 53121
PHONE: (262) 723-2098 FAX: (262) 723-5886


- WORK ORDERED FOR -
CHRISTINA S. TAYLOR
BY: THE RAULAND AGENCY
PO BOX 159
WALWORTH, WI. 53184

PLAT OF SURVEY

LOT 88 OF OAK KNOLLS OF WALWORTH ADDITION MO. 1

Lot 86, Oak Knolls of Walworth Addition No. 1, a resubdivision of Outlet No. 1 of Oak Knolls of Walworth being a subdivision of the Southeast 1/4 of the Southeast 1/4 of Section 22, Town 1 North, Range 16 East, in the Village of Walworth, County of Walworth, State of Wisconsin.

Tax Key No. VOK1 00061

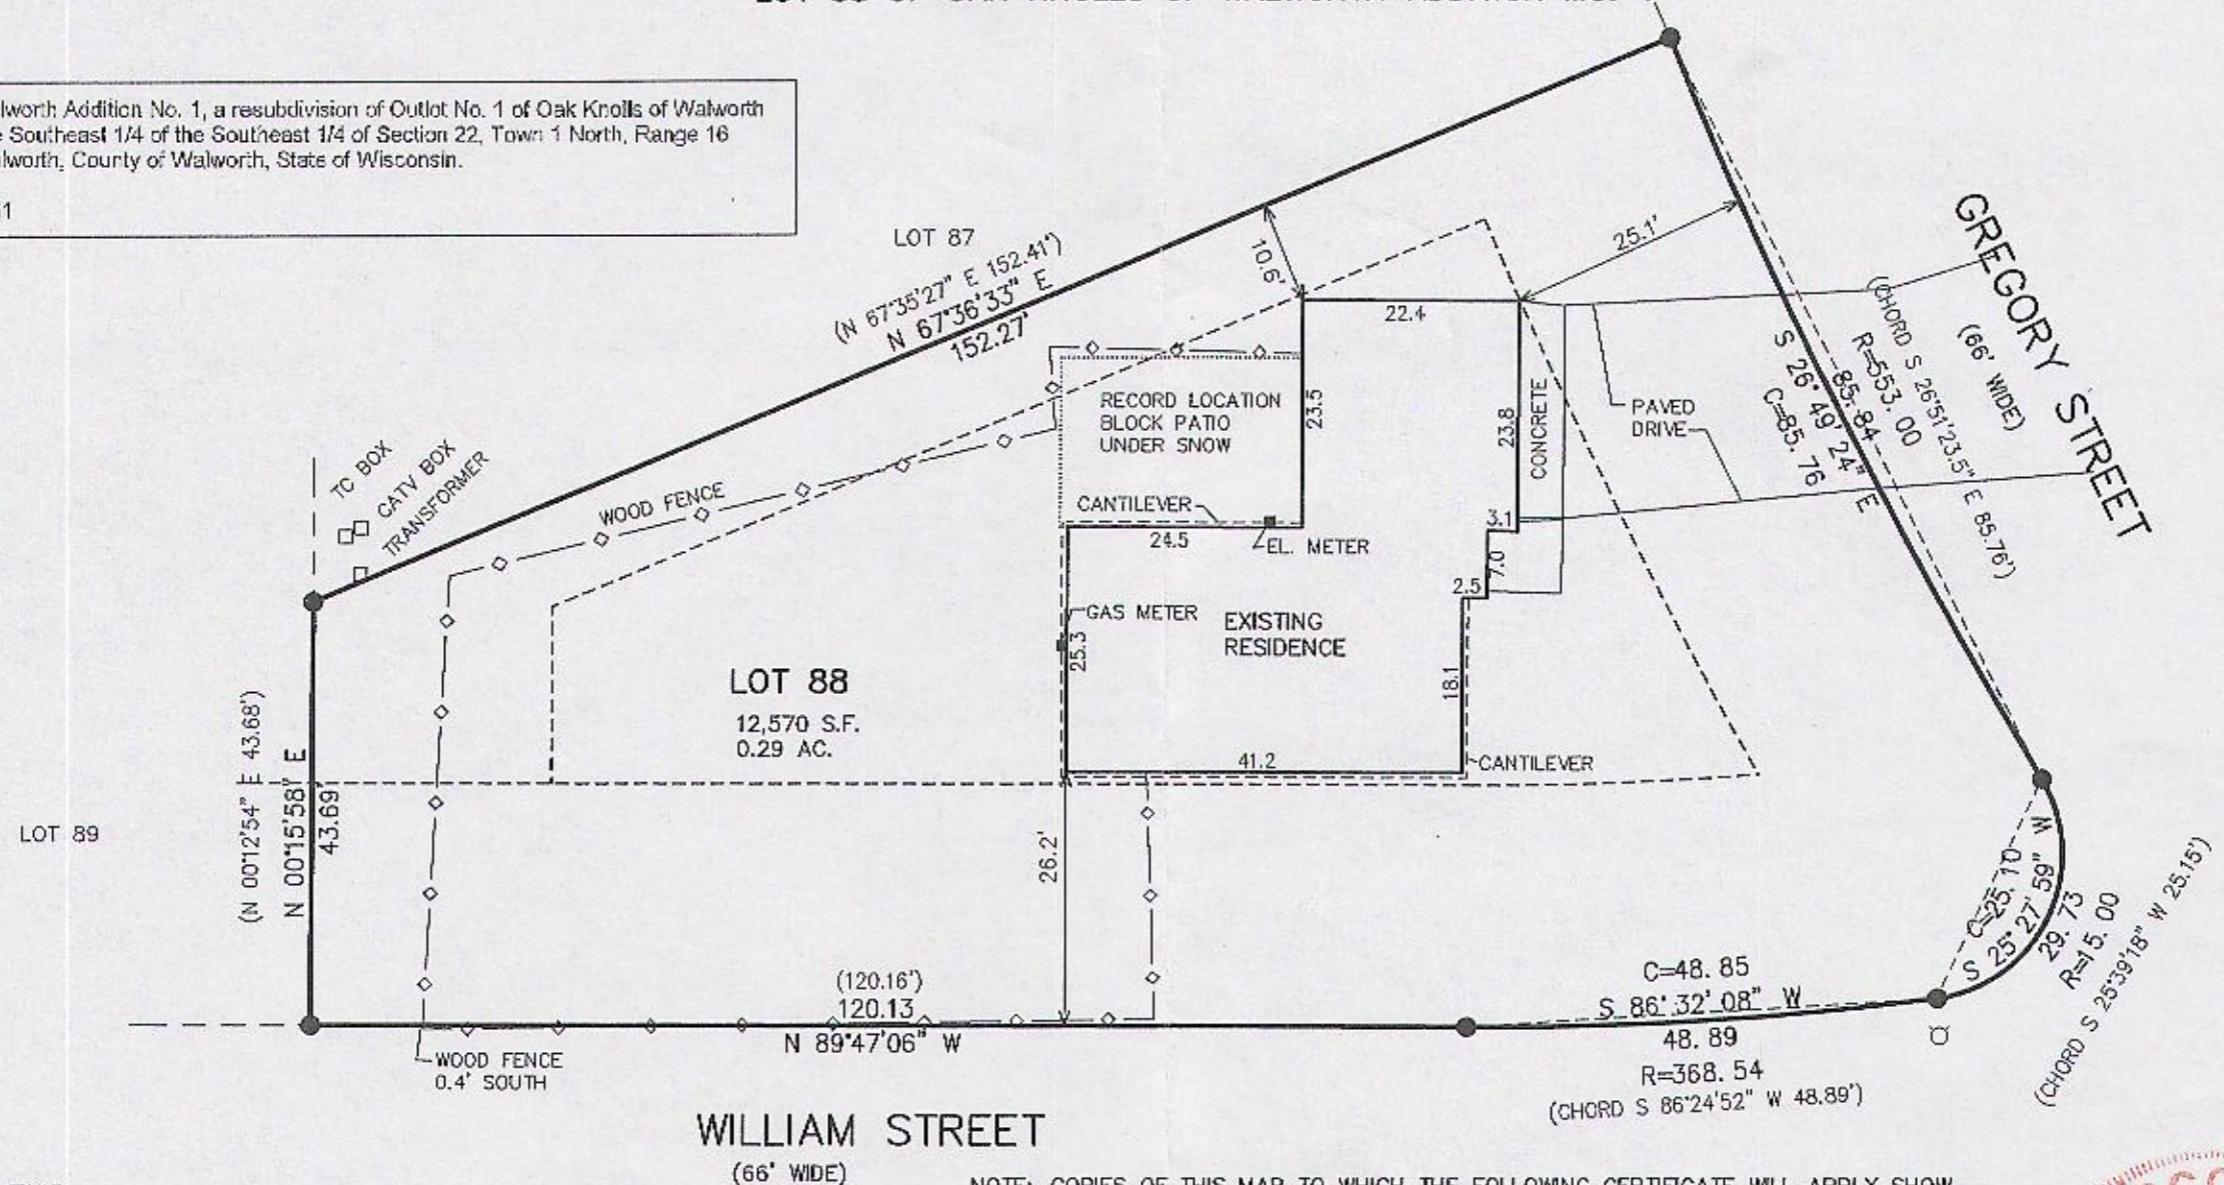

RECEIVED
MAR 27 2015
By *hm*

LEGEND

● = FOUND IRON REBAR STAKE
(xxx) = RECORDED AS

(66' WIDE) NOTE:

(66" WIDE)

NOTE: COPIES OF THIS MAP TO WHICH THE FOLLOWING CERTIFICATE WILL APPLY SHOW THE SURVEYOR'S ORIGINAL SEAL AND SIGNATURE IN RED INK. COPIES BY ANY OTHER MEANS MAY HAVE ALTERATIONS WHICH DO NOT REPRESENT THE SURVEYOR'S WORK PRODUCT

DATED: MARCH 5, 2015

PETER S. GORDON P.L.S. 2101

PROJECT: 9229
DATE: 03-05-2015
SHEET 1 OF 1

