


GEORGE T. DUNHAM
SURVEYING & SUBDIVIDING
DELAVAN, WISCONSIN

N

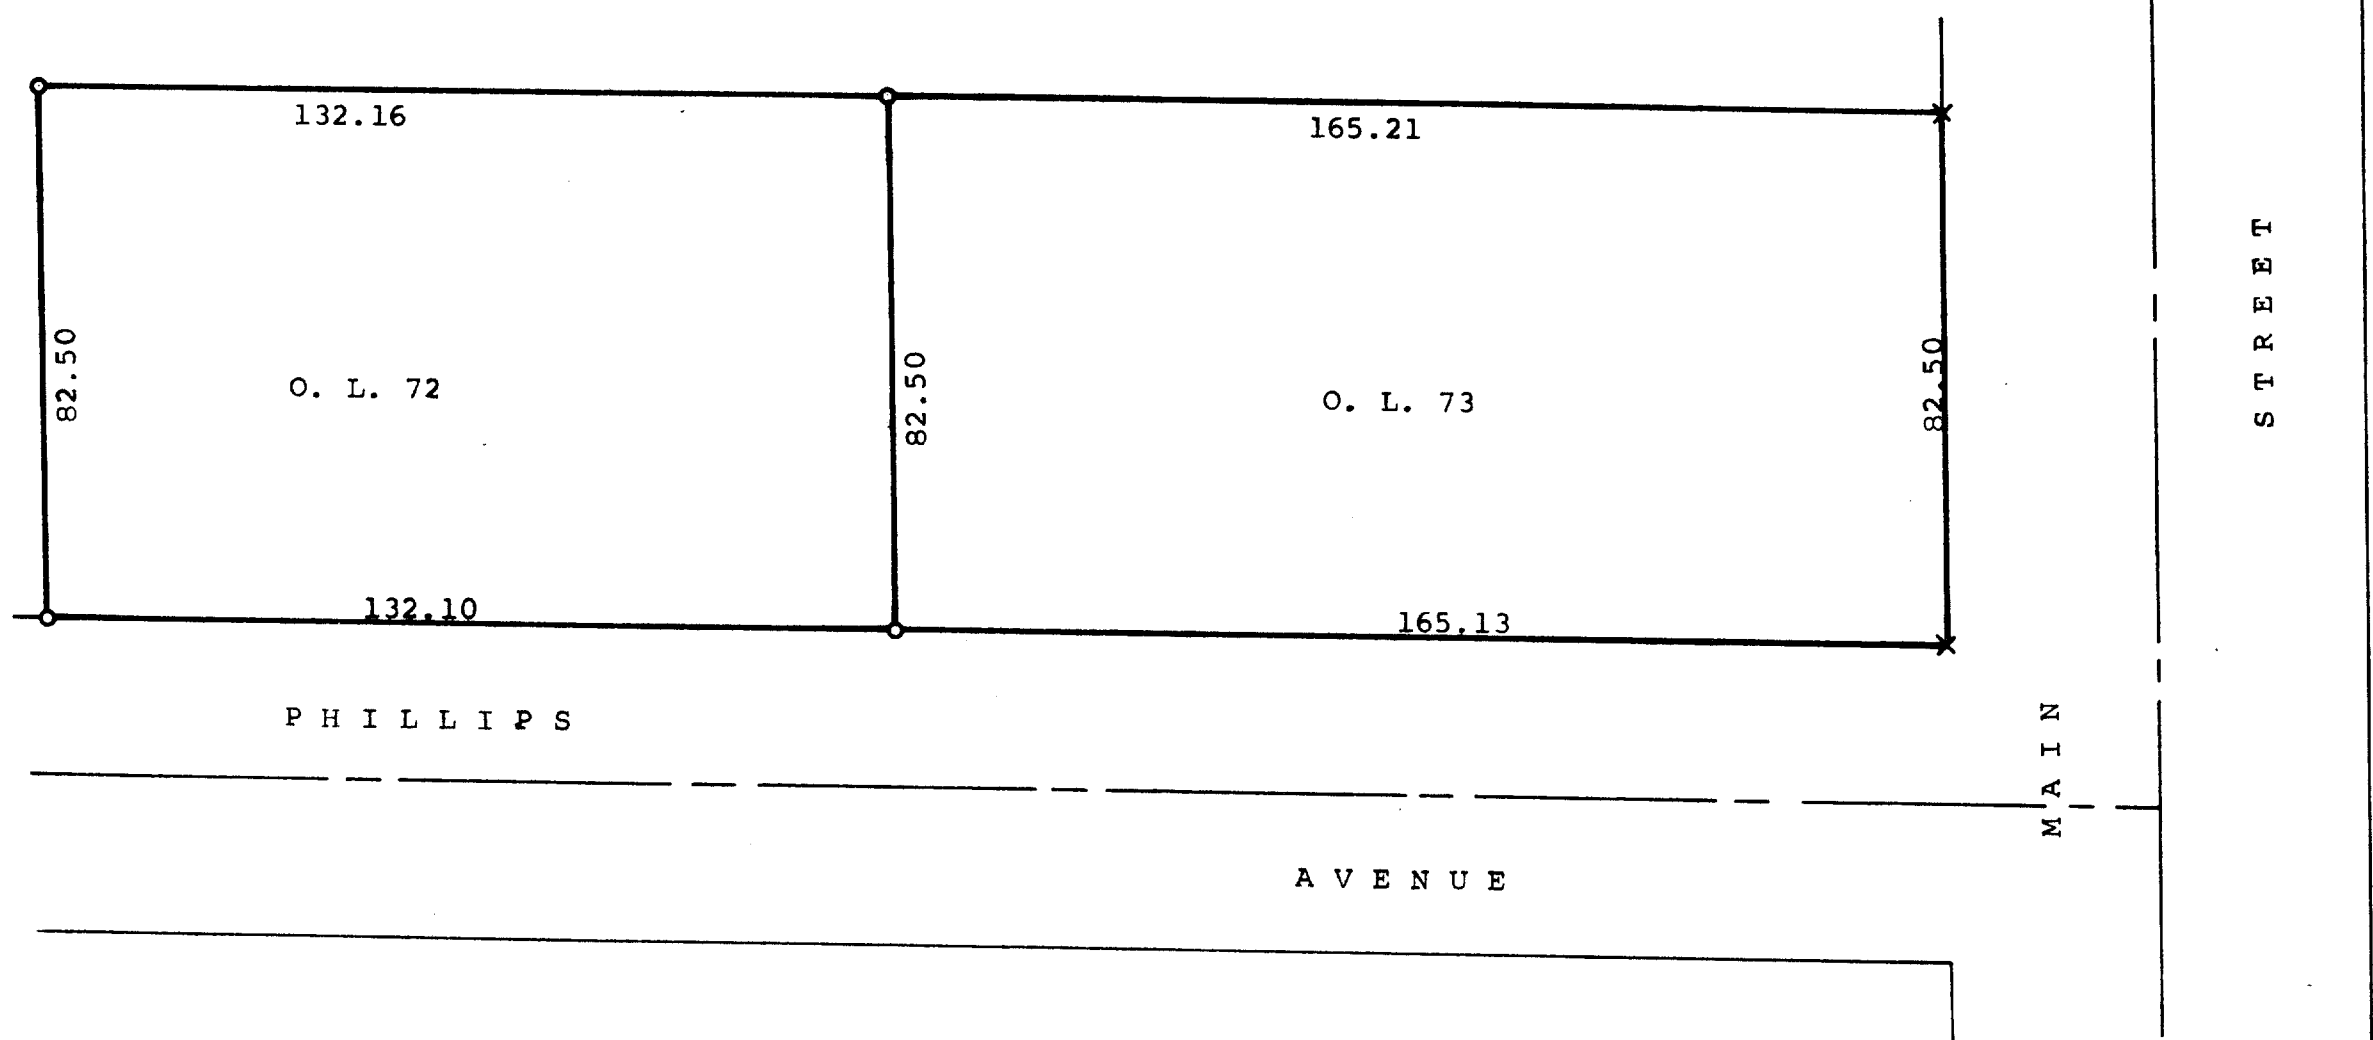

Scale - 1" = 30'
O = Iron Pipe
X = Cross in Concrete

Plat of survey of Outlots 72 and 73 of the Assessor's
Plat of the Village of Walworth, Walworth County, Wisconsin.
September 13, 1974

George T. Dunham
George T. Dunham, Surveyor

