


FARRIS, HANSEN & ASSOCIATES, INC.
ENGINEERING — ARCHITECTURE — SURVEYING
7 RIDGWAY COURT — P.O. BOX 437 — ELKHORN, WISCONSIN 53121
PHONE: (262) 723-2098 FAX: (262) 723-5886

— WORK ORDERED BY —
ADDISON TOYTON
119 BONITO STREET
WALWORTH, WI. 53184

PLAT OF SURVEY

The North 100.00 feet of the South 134.00 feet of
Outlot 192 of the Assessors Plat of the Village of
Walworth, Walworth County, Wisconsin.

PARCEL VWP 00231A


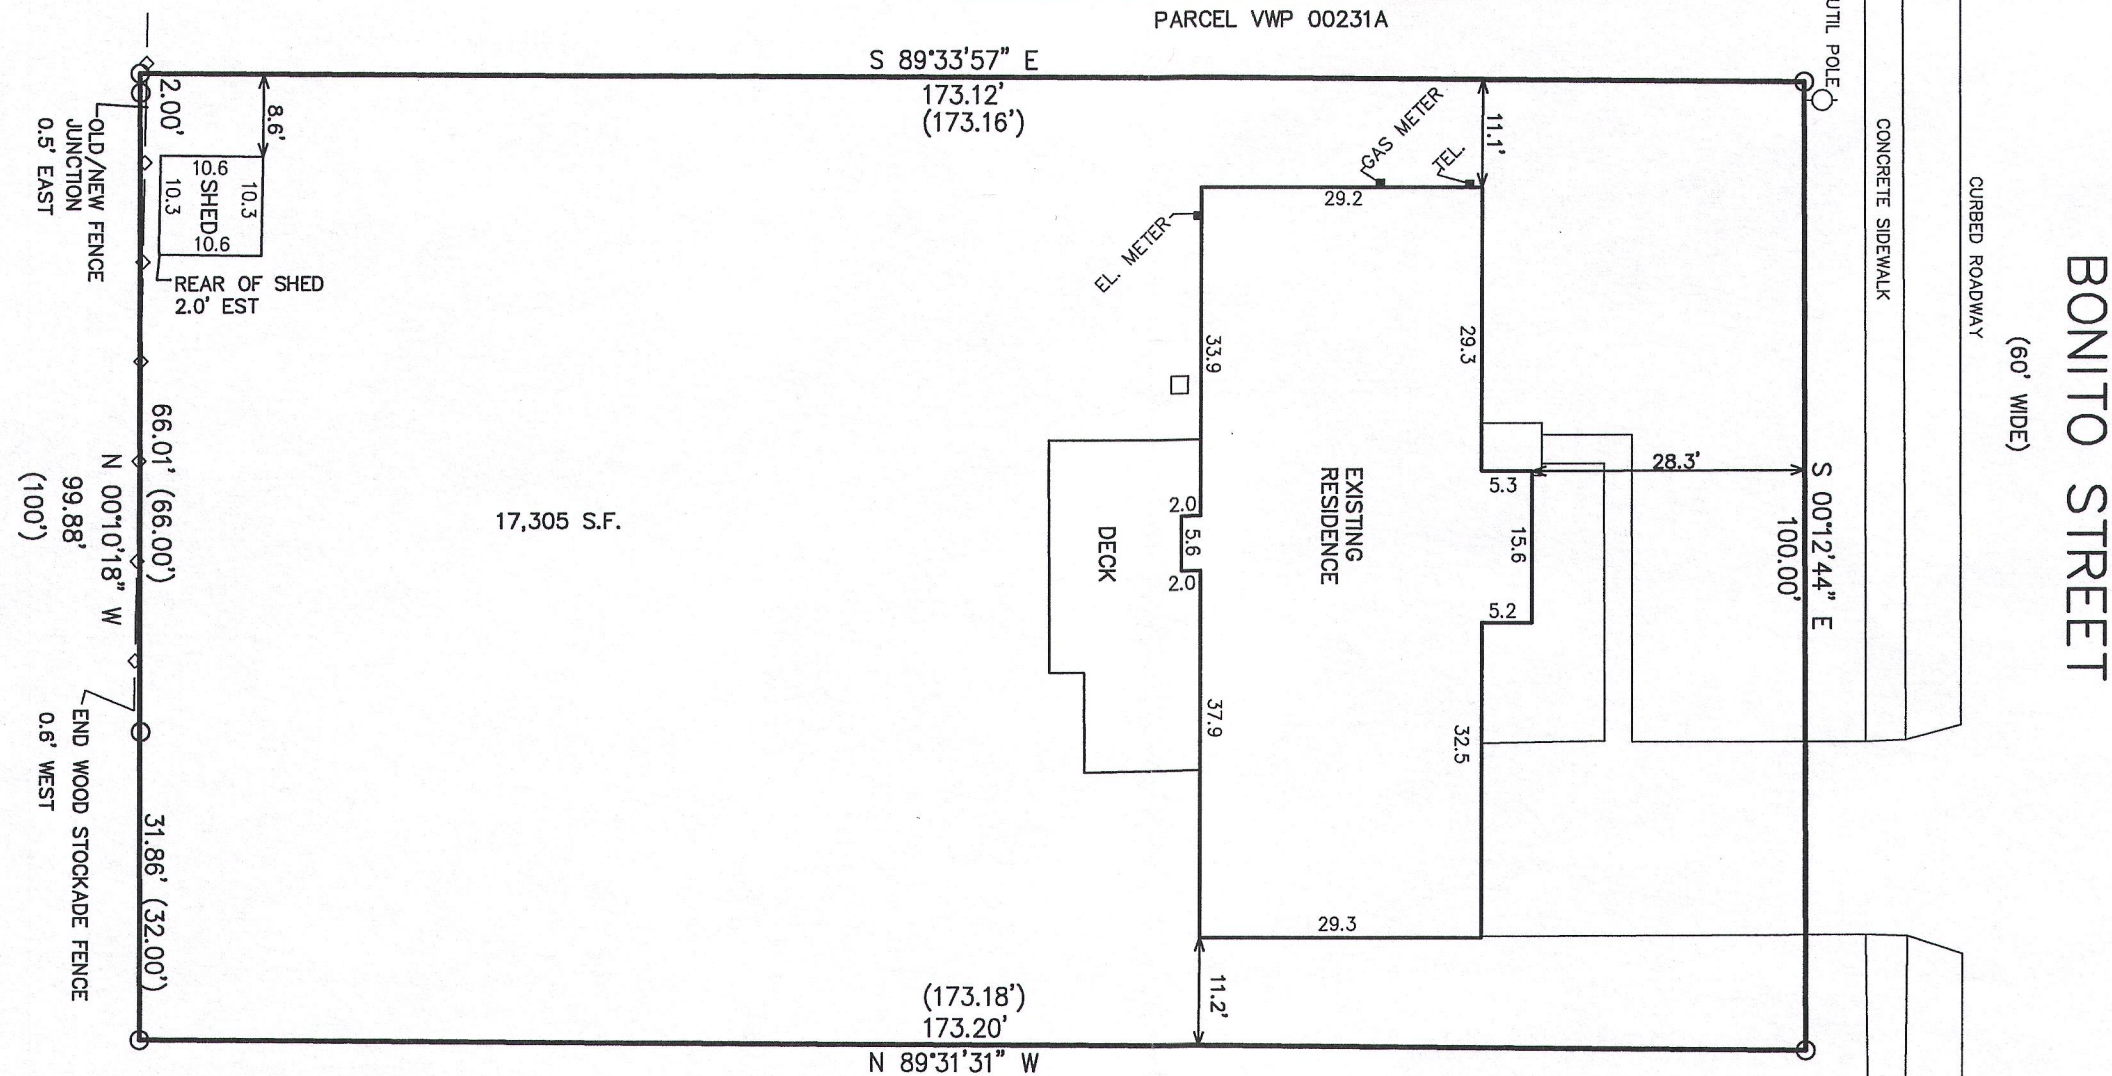


NOTE: COPIES OF THIS MAP TO WHICH THE FOLLOWING CERTIFICATE
WILL APPLY SHOW THE SURVEYOR'S ORIGINAL SEAL AND SIGNATURE
IN RED INK. COPIES BY ANY OTHER MEANS MAY HAVE ALTERATIONS
WHICH DO NOT REPRESENT THE SURVEYOR'S WORK PRODUCT.

I HEREBY CERTIFY THAT THE ABOVE DESCRIBED PROPERTY HAS BEEN
SURVEYED UNDER MY DIRECTION AND THAT THE ABOVE MAP IS A TRUE
REPRESENTATION THEREOF AND SHOWS THE SIZE AND LOCATION OF
THE PROPERTY AND ITS EXTERIOR BOUNDARIES. THIS SURVEY IS
MADE FOR THE USE OF THE PRESENT OWNERS OF THE PROPERTY, AND
ALSO THOSE WHO PURCHASE, MORTGAGE, OR GUARANTEE THE TITLE
THERETO WITHIN ONE YEAR FROM THE DATE HEREOF.


DATED: APRIL 21, 2015

PETER S. GORDON P.L.S. 2101

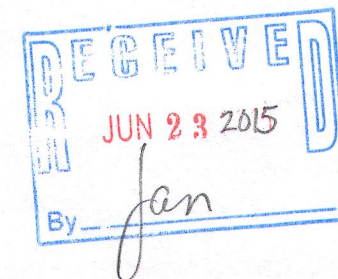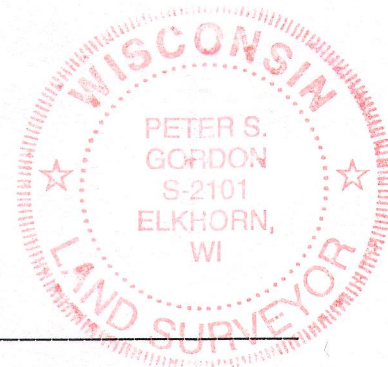

LEGEND
○ = FOUND IRON PIPE STAKE
(XXX) = RECORDED AS

PROJECT: 9270
DATE: 04-21-2015
SHEET 1 OF 1

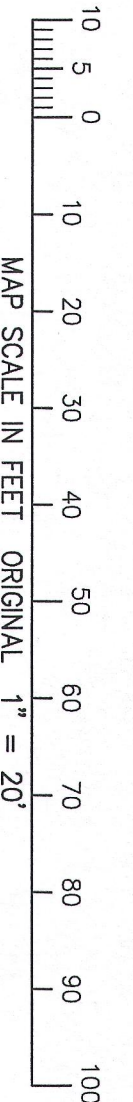

ASSIGNED WEST LINE BONITO STREET
S 00°12'44" E

APR 21 2015

VWP-231A

009-1223

X:\Projects\9270\dcad\survey 4/21/2015