

FARRIS, HANSEN & ASSOCIATES, INC.
ENGINEERING — ARCHITECTURE — SURVEYING
7 RIDGWAY COURT — P.O. BOX 437 — ELKHORN, WISCONSIN 53121
PHONE: (262) 723-2098 FAX: (262) 723-5886

— WORK ORDERED BY —
THE RAULAND AGENCY
PO BOX 159
WALWORTH, WI. 53184

ASSIGNED NORTH LINE KENOSHA STREET
S 90°00'00" W



PLAT OF SURVEY

A parcel of land located in the NW ¼ of Section 22, T1N, R16E, Village of Walworth, Walworth County, Wisconsin, described as follows: Beginning at a point that is located 66 rods East of the West ¼ Section corner of Section 22, T1N, R16E, of Walworth County, Wisconsin; thence North 20 rods; thence East 4 rods; thence South 20 rods; thence West 4 rods to the place of beginning.

The above described premises are more particularly described as follows, to-wit: Outlot 180 of the Assessors Plat to the Village of Walworth according to the recorded plat thereof, Walworth County, Wisconsin.

Tax Key No.: VWP 00210

LEGEND
○ = FOUND IRON PIPE STAKE
● = FOUND IRON REBAR STAKE
(XXX) = RECORDED AS

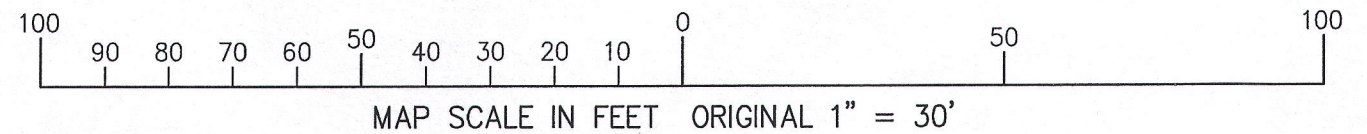
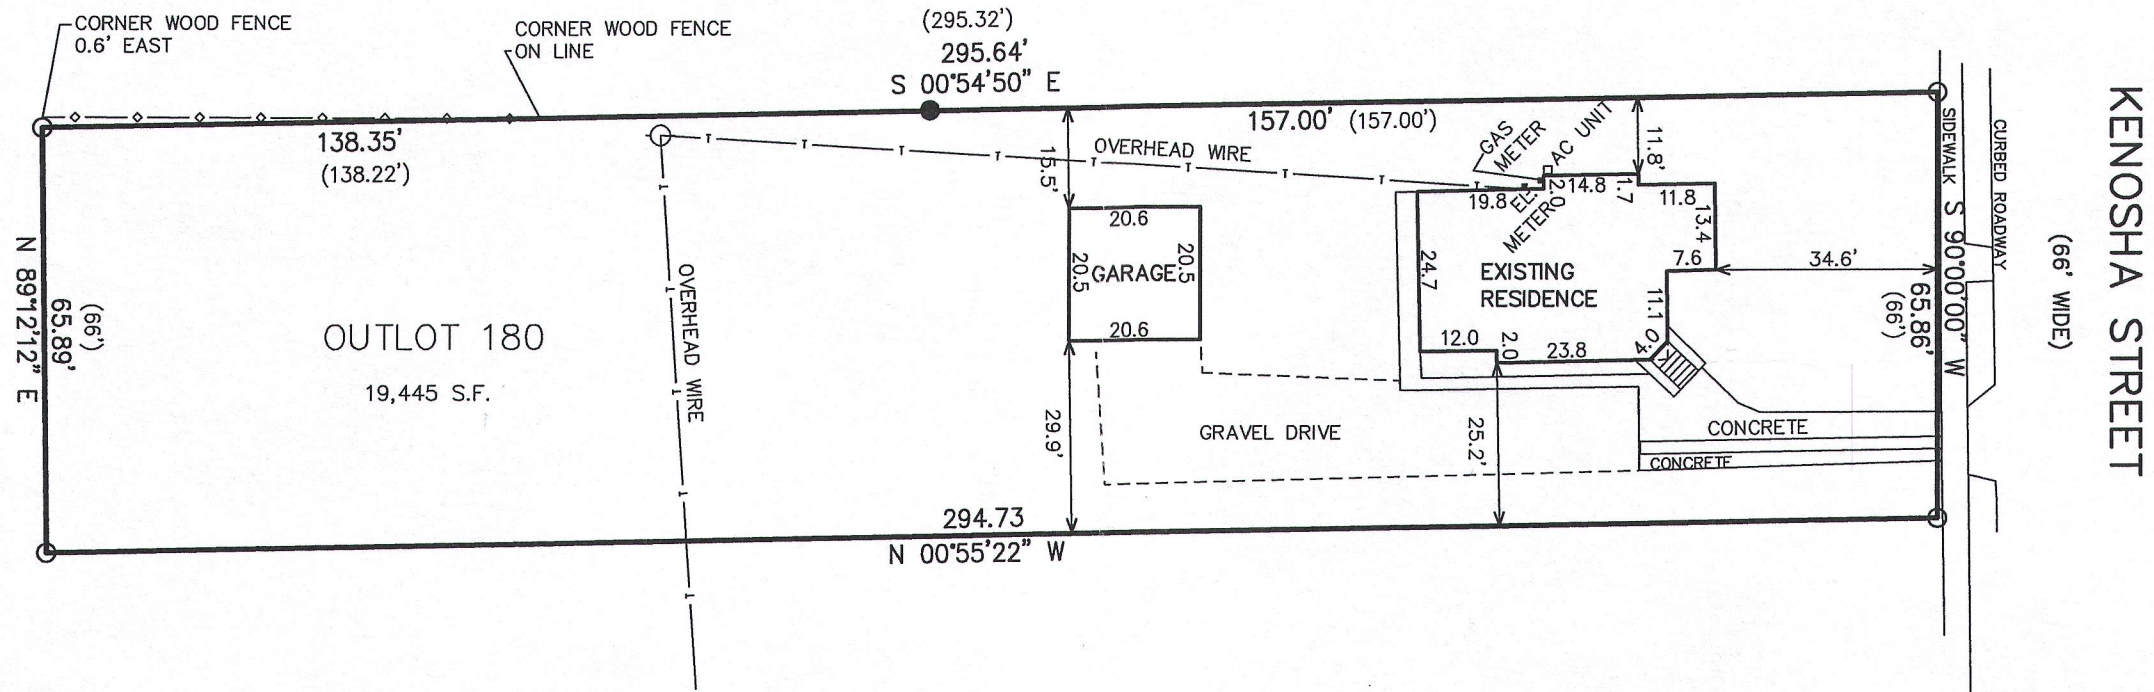


NOTE: COPIES OF THIS MAP TO WHICH THE FOLLOWING CERTIFICATE WILL APPLY SHOW THE SURVEYOR'S ORIGINAL SEAL AND SIGNATURE IN RED INK. COPIES BY ANY OTHER MEANS MAY HAVE ALTERATIONS WHICH DO NOT REPRESENT THE SURVEYOR'S WORK PRODUCT.

I HEREBY CERTIFY THAT THE ABOVE DESCRIBED PROPERTY HAS BEEN SURVEYED UNDER MY DIRECTION AND THAT THE ABOVE MAP IS A TRUE REPRESENTATION THEREOF AND SHOWS THE SIZE AND LOCATION OF THE PROPERTY, ITS EXTERIOR BOUNDARIES, THE LOCATION OF ALL VISIBLE STRUCTURES, AND DIMENSIONS OF ALL PRINCIPLE BUILDINGS THEREON, BOUNDARY FENCES, APPARENT EASEMENTS, ROADWAYS, AND VISIBLE ENCROACHMENTS, IF ANY. THIS SURVEY IS MADE FOR THE USE OF THE PRESENT OWNERS OF THE PROPERTY, AND ALSO THOSE WHO PURCHASE, MORTGAGE, OR GUARANTEE THE TITLE THERETO WITHIN ONE YEAR FROM THE DATE HEREOF.

DATED: APRIL 21, 2015

Peter S. Gordon
PETER S. GORDON P.L.S. 2101

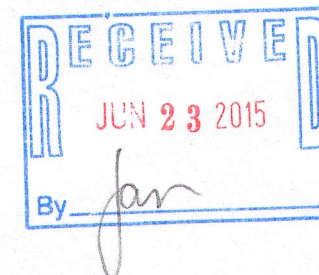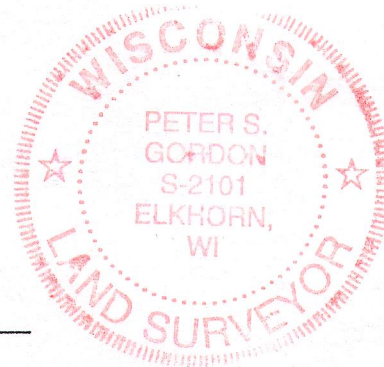

PROJECT: 9269
DATE: 04-21-2015
SHEET 1 OF 1

APR 21 2015

VWP-210 009-1224