



GEORGE T. DUNHAM
SURVEYING & SUBDIVIDING
DELAVAN, WISCONSIN

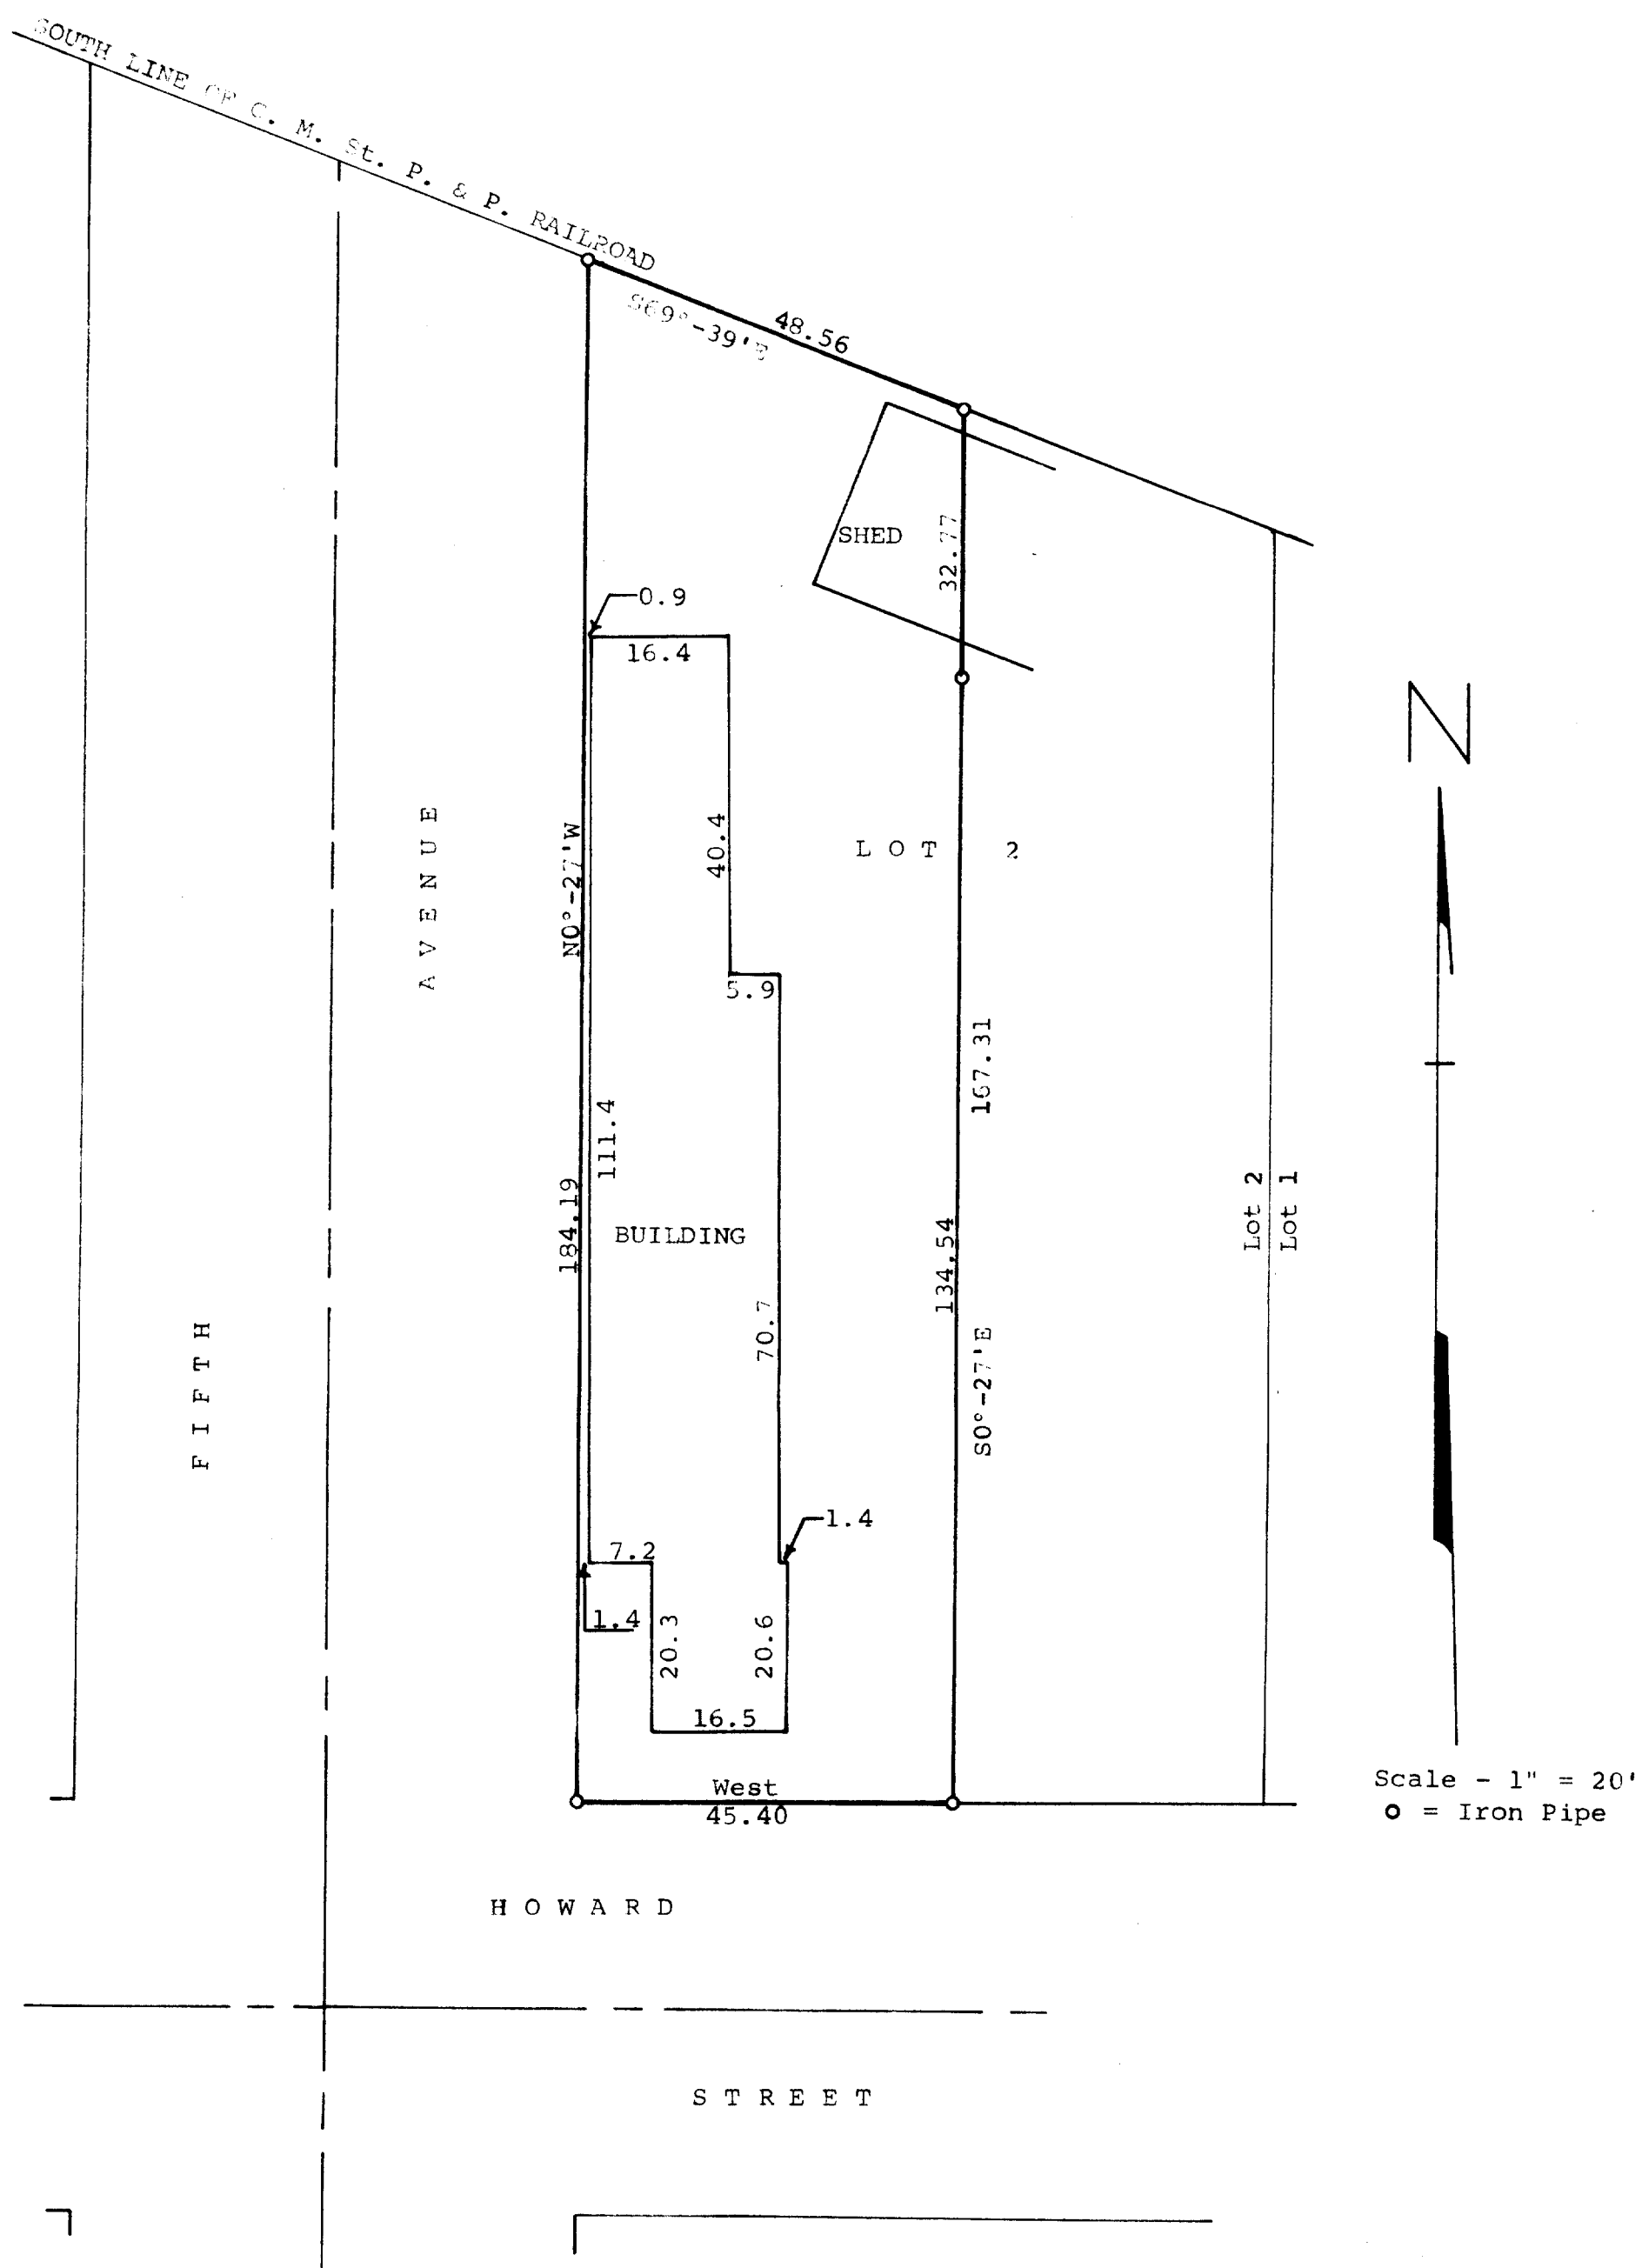

Plat of survey of a part of Lot 2 in Block 2 of
E. W. Crum's Addition to the Village of Walworth,
Walworth County, Wisconsin.
May 30, 1974
Revised March 21, 1975

George T. Dunham
George T. Dunham, Surveyor

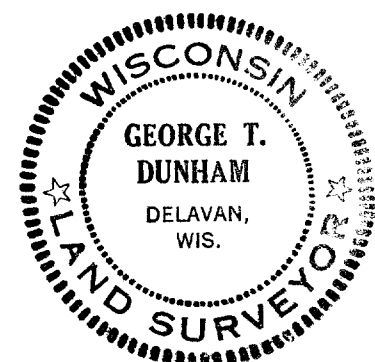

VECI-26.7

K&E 10-8188 250-7-73

WHP-264

9-125