

PLAT OF SURVEY

— WORK ORDERED BY —
GENEVA LAKE DREAM HOMES
908 SOUTH WELLS STREET
LAKE GENEVA, WI 53147


FARRIS, HANSEN & ASSOCIATES, INC.
ENGINEERING — ARCHITECTURE — SURVEYING
7 RIDGWAY COURT P.O. BOX 437
ELKHORN, WISCONSIN 53121
OFFICE: (262) 723-2098 FAX: (262) 723-5886

REVISIONS




PROJECT NO.
6460.11.14
DATE:
12/06/2005
SHEET NO.
1 OF 1

PLAT OF SURVEY
LOT 11 OF WHITETAIL RIDGE SUBDIVISION

LOCATED IN PART OF THE SW 1/4 AND SE 1/4 OF SECTION 15, TOWN 1 NORTH,
RANGE 16 EAST, VILLAGE OF WALWORTH, WALWORTH COUNTY, WISCONSIN

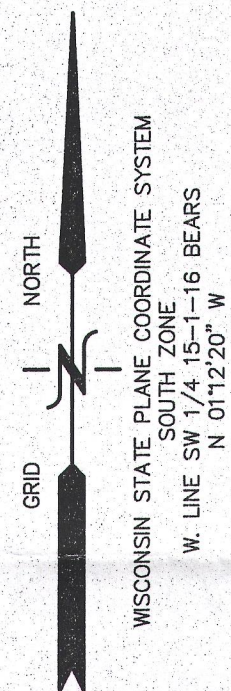

LEGEND
● = IRON REBAR STAKE
{XXX} = RECORDED AS

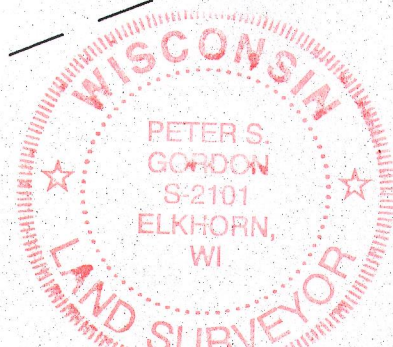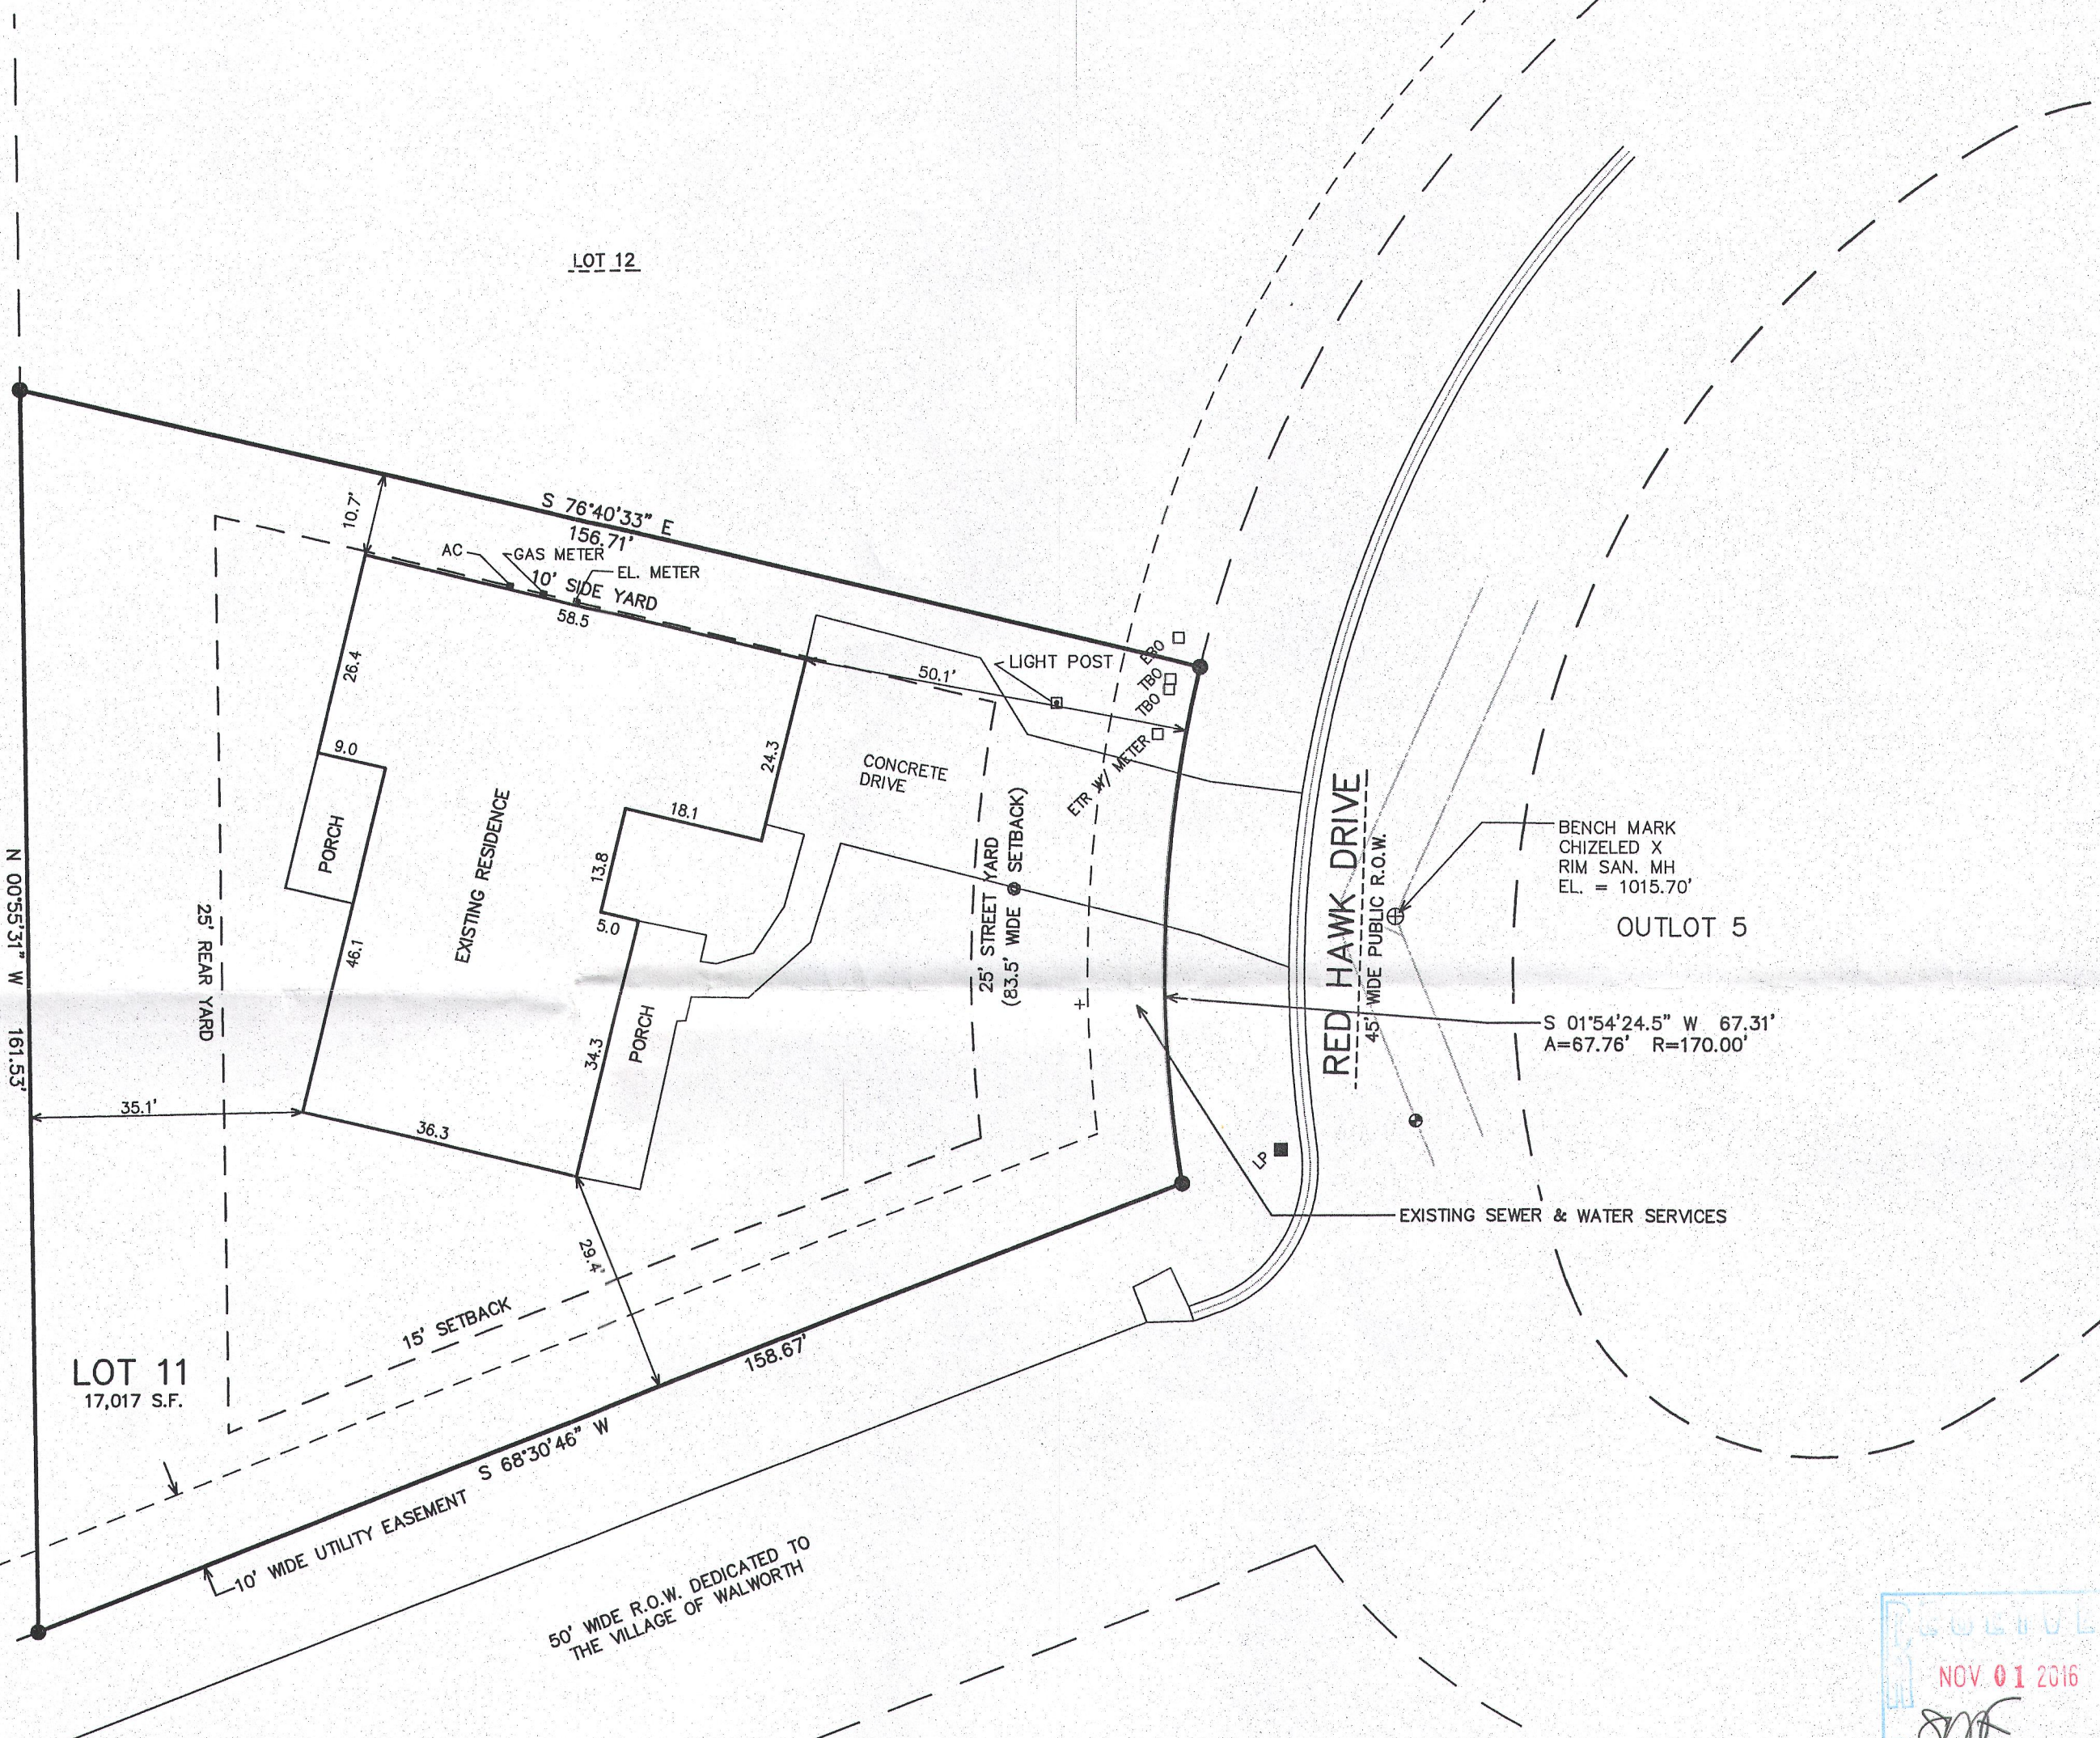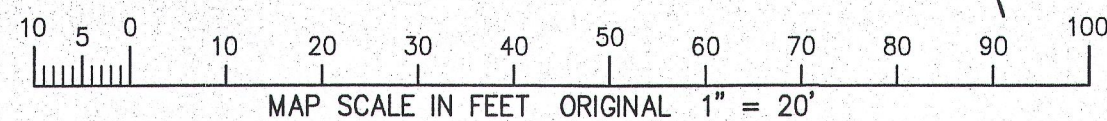

REVISED 08-02-2016
TO SHOW ASBUILT
RESIDENCE

NOTE: COPIES OF THIS MAP TO WHICH THE FOLLOWING CERTIFICATE WILL APPLY SHOW SURVEYOR'S ORIGINAL SEAL AND SIGNATURE IN RED INK. COPIES BY ANY OTHER MEANS MAY HAVE ALTERATIONS WHICH DO NOT REPRESENT THE SURVEYOR'S WORK PRODUCT.

I HEREBY CERTIFY THAT THE ABOVE DESCRIBED PROPERTY HAS BEEN SURVEYED UNDER MY DIRECTION AND THAT THE ABOVE MAP IS A TRUE REPRESENTATION THEREOF AND SHOWS THE SIZE AND LOCATION OF THE PROPERTY, ITS EXTERIOR BOUNDARIES, THE LOCATION OF ALL VISIBLE STRUCTURES, AND DIMENSIONS OF ALL PRINCIPLE BUILDINGS THEREON, BOUNDARY FENCES, APPARENT EASEMENTS, ROADWAYS, AND VISIBLE ENCROACHMENTS, IF ANY. THIS SURVEY IS MADE FOR THE USE OF THE PRESENT OWNERS OF THE PROPERTY, AND ALSO THOSE WHO PURCHASE, MORTGAGE, OR GUARANTEE THE TITLE THERETO WITHIN ONE YEAR FROM THE DATE HEREOF.

DATED: NOVEMBER 29, 2005


Peter S. Gordon
PETER S. GORDON R.L.S. 2101

REVISED 04-21-2014
ADD TOPO

REVISED 7/22/2014-KB
SITE, GRADING, DRAINAGE &
EROSION CONTROL PLAN

REVISED 8/21/2014-KB
ADD TURNAROUND

REVISED 9/22/2014-KB
ADJUST PROPOSED RES.

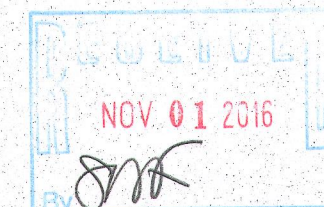

009-1262

8/3/2016 X:\Projects\6460\WDR\LOT11\ASBUILT

AUG 03 2016

VWR-11