


Wisconsin Professional Land Surveyor S-2582

**N9330 Knuteson Drive
Whitewater, WI 53190
Phone: (262) 495-3284
MARKMIRITZ@
LAND-MARKSURVEYING.COM**

**ORDERED BY:
BECKY MERWIN
RAULAND AGENCY
118 KENOSHA STREET
WALWORTH, WI 53184**

Part of Outlot 218 of the Assessor's Plat of the Village of Walworth, County of Walworth, State of Wisconsin more fully described as: A parcel of land located in the Southwest Quarter of Section 22, Township 1 North, Range 16 East, in the Village of Walworth, Walworth County, Wisconsin, described as follows: Commencing at the middle 1/4 section corner of Section 22, thence West along the East-West section line of said Section 22, 546.50 feet to the place of beginning, thence continuing West 60 feet; thence South 1° 02' East 198 feet, thence East 60 feet, thence North 1° 02' West 198 feet to point of beginning.

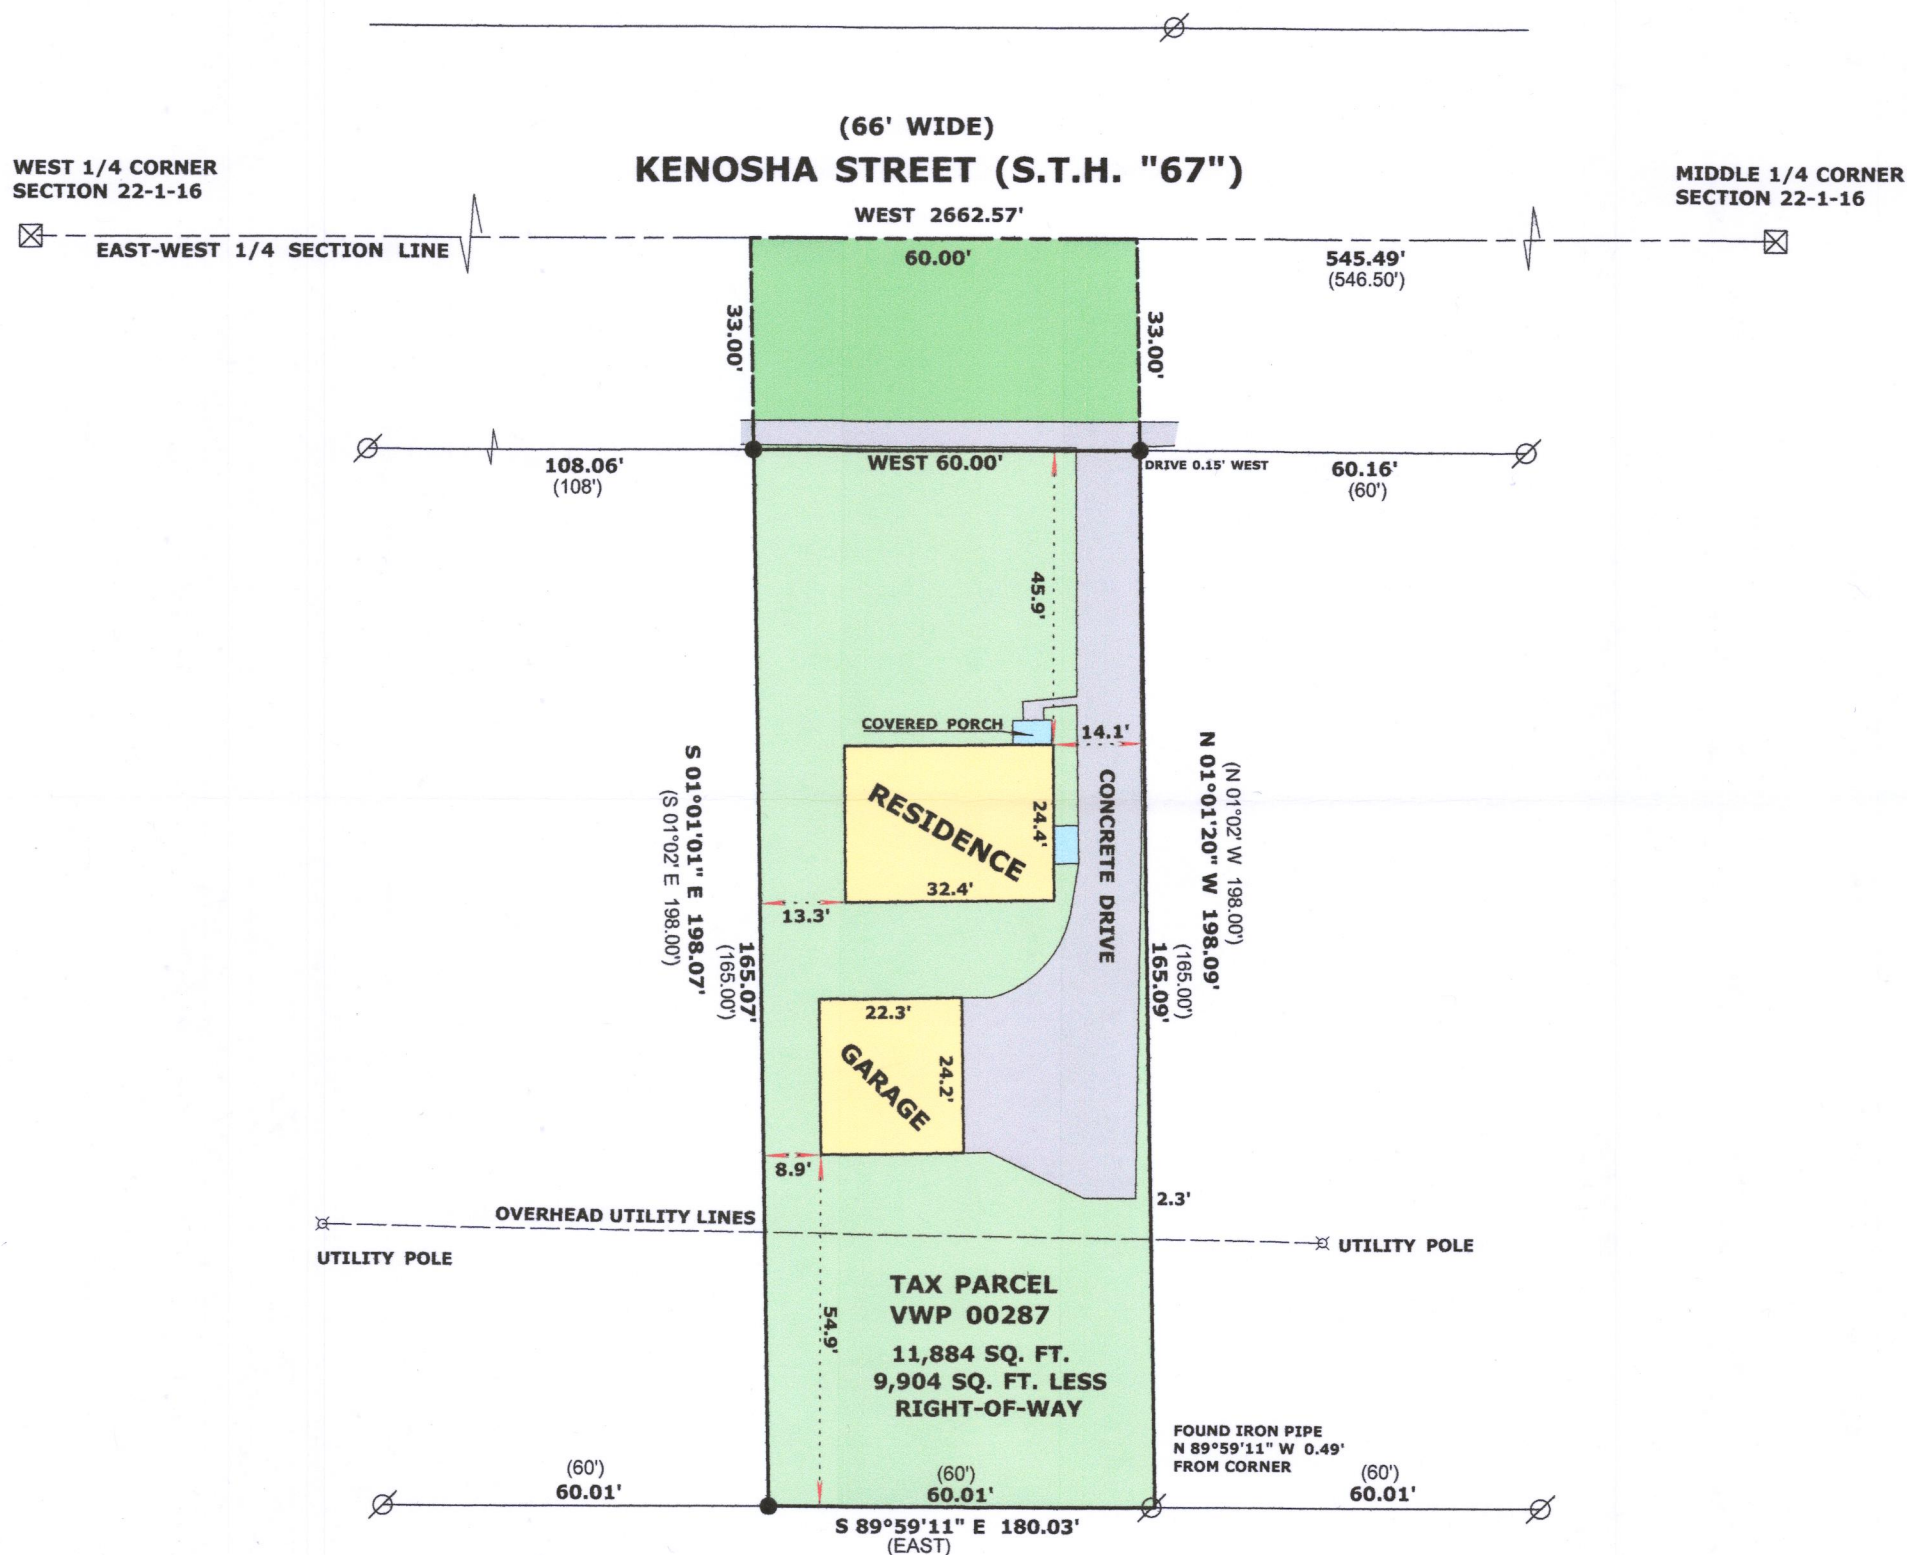

	FOUND IRON PIPE
	FOUND COUNTY MONUMENT
	SET IRON ROD, 18" LONG, WEIGHING 1.5 LBS./LINEAL FT., 3/4" DIA.
(x x)	RECORDED AS DIMENSION

SCALE: 1 INCH = 30 FEET

"I hereby certify that the above described property has been surveyed by me or under my direction and that the above map is a true representation thereof and shows the size and location of the property, its exterior boundaries, the location of all visible structures and dimensions of all principal buildings thereon, boundary fences, apparent easements, roadways and visible encroachments, if any."

"This survey is made for the use of the present owners of the property, and also those who purchase, mortgage, or guarantee the title thereto within one year from date hereof."

Mark L. Miritz
 MARK L. MIRITZ
 WISCONSIN PROFESSIONAL
 LAND SURVEYOR S-2582

DATE: FEB. 7, 2018 JOB NO. 18.201

VWP-287

009-1296