

Plat of Survey

of
Lot 16 of Suhr's Subdivision,
located in the Southwest 1/4 of the Southwest 1/4 of Section 22, Town 1
North, Range 16 East, Village of Walworth, Walworth County, Wisconsin.

Surveyed for: **Coldwell Banker Leith & Associates**
102 North Wisconsin Street
Elkhorn, Wisconsin. 53121



Bearings referenced to the North line of Knoll Road,
recorded as N88°25'W on the plat of Suhr's Subdivision.



- Notes:**
- 1) This Plat of Survey is not certified unless signed and sealed in red ink.
 - 2) This survey is subject to Wisconsin lien laws. This Plat of Survey is the notice of intent to file lien. Lien waiver required.
 - 3) The Survey Date shown on this Plat of Survey is the completion date of the field work.

Copyright ©2019 by Olson Land Surveying, LLC.


All rights reserved. No part of this survey plat may be reproduced or transmitted in any form by any means - graphic, electronic, or mechanical, including photocopying, tracing, or information storage and retrieval systems - without permission in writing from Douglas G. Olson, Olson Land Surveying, LLC.

I hereby certify that I have surveyed the above described property in compliance with Chapter A-E 7 of the Wisconsin Administrative Code and that the map hereon is correct to the best of my professional knowledge and belief and shows the size and location of the property, its exterior boundaries, the location and dimensions of all visible structures thereon, boundary fences, apparent easements and roadways and visible encroachments, if any.
This survey is made for the exclusive use of the present owners of the property, and also those who purchase, mortgage or guarantee title thereto, within one year from the date hereof.

Douglas G. Olson
Wisconsin Professional Land Surveyor - 2093

Survey Date: June 14, 2019.

Revisions:

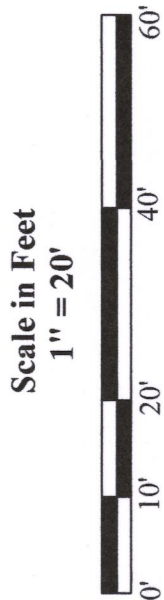

45 South Wisconsin Street | P.O. Box 322
Elkhorn, Wisconsin, 53121
Telephone: (262) 723-3434
Facsimile: (262) 723-8044
Email: doug@olsonsurveying.com
Website: www.olsonsurveying.com

OLSON
LAND SURVEYING, LLC
Rural | Residential | Commercial

Legend of Symbols & Abbreviations

N	North
S	South
E	East
W	West
B	Bearings in Degrees
M	Minutes
S	Seconds
D	Distances in Feet
I	Inches

Found Concrete Monument
Recorded Information
Utility Pole
Water Valve
Fire Hydrant
Asphalt Surface
Concrete Surface

Block Corner

Sheet 1 of 1 Sheets

Drawing Name

Job Reference Number

2019.074

2019.074