


PLAT OF SURVEY

OF

A parcel of land located in the Southeast $\frac{1}{4}$ of Section 16, Town 1 North, Range 16 East, Walworth County, Wisconsin, more particularly described as follows: Commencing at the Southeast corner of said Section 16; thence North $0^{\circ}22'53''$ West, 774.71 feet along the East line of said Section 16; thence North $89^{\circ}21'30''$ West, 125.00 feet to an iron rod and the point of beginning; thence continue North $89^{\circ}21'30''$ West, 260.00 feet to an iron rod; thence North $0^{\circ}22'57''$ West, 410.98 feet to an iron rod on the South line of Wisconsin Street; thence South $89^{\circ}25'30''$ East, 260.00 feet along the South line of Wisconsin Street to an iron rod; thence South $0^{\circ}22'54''$ East, 411.28 feet to the point of beginning.

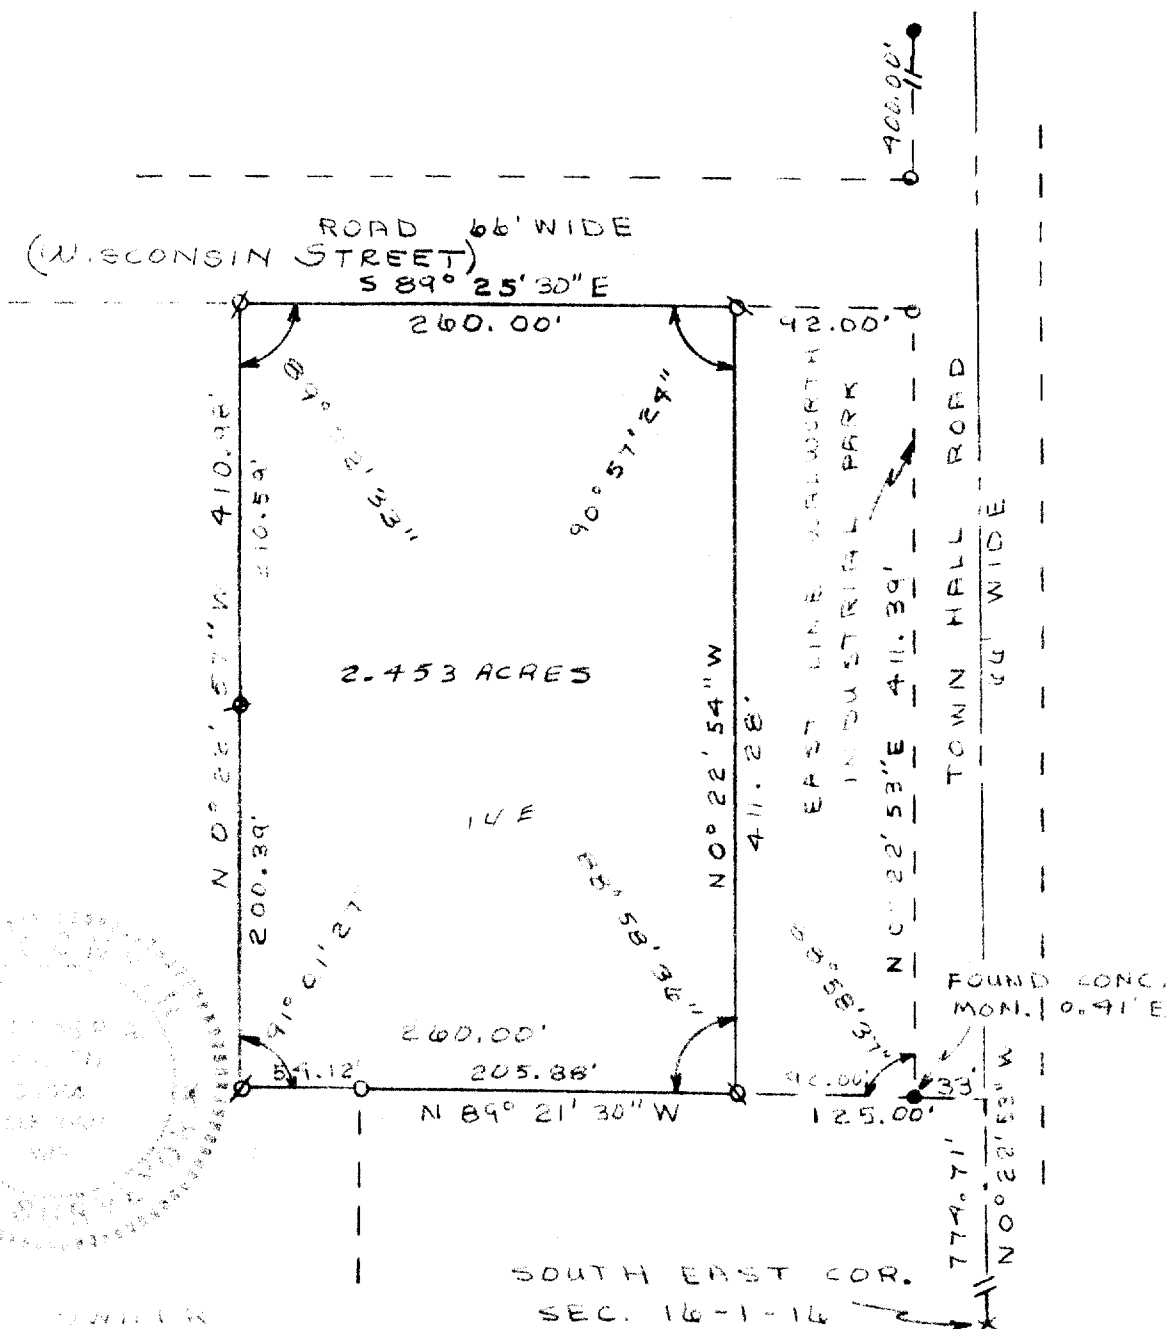

PLAT BASED ON EAST LINE
OF VILLAGE OF WALWORTH INDUSTRIAL
CORPORATION PREVIOUSLY RECORDED

VILLAGE OF WALWORTH
INDUSTRIAL
CORPORATION

SURVEY AND PLAT BY

JENSEN & JOHNSON, INC.
CIVIL ENGINEERS AND SURVEYORS

Elkhorn, Wisconsin

LEGEND

○ — Iron Pipe FOUND

● — Concrete Monument

Scale 1" = 100'

25' IRON PIPE SET

WE CERTIFY: That we have surveyed the above described property and that the plat shown hereon is an accurate survey and a true representation thereof and correctly shows the exterior boundary lines and all divisions of said property.

Date DEC 10 1915

THOMAS P. H. JENSEN
Wisconsin Registered Land Surveyor, No. 5-1064