




FOUND 1" IRON PIPE  
 FOUND .5" IRON PIPE  
 RECORDED AS  
 EXISTING CONCRETE  
 EXISTING BUILDING  
 EXISTING DECK  
 EXISTING ASPHALT DRIVE

A PARCEL OF LAND LOCATED IN THE SOUTHWEST 1/4 OF THE SOUTHWEST 1/4 OF SECTION 22 IN TOWNSHIP 1 NORTH, RANGE 16 EAST, IN THE VILLAGE OF WALWORTH, WALWORTH COUNTY, WISCONSIN.

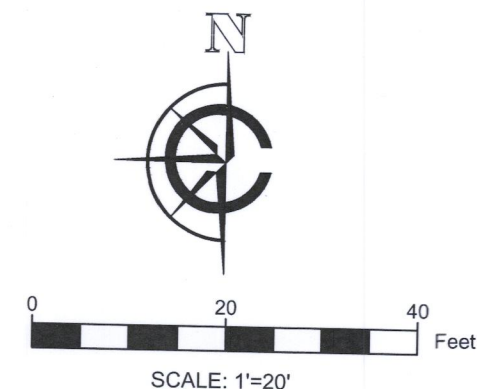

NOTE:

1. BASIS OF BEARING: THE WISCONSIN STATE PLANE COORDINATE SYSTEM, NAD-83, SOUTH ZONE.
2. FIELD WORK COMPLETED OCTOBER 10, 2020
3. BUILDING SURVEYED TO THE EXTERIOR OF SIDING.
4. FIELD CREW CHIEF: LOGAN RANDLE

LEGAL DESCRIPTION:

A PARCEL OF LAND LOCATED IN THE SOUTHWEST 1/4 OF THE SOUTHWEST 1/4 OF SECTION 22 IN TOWNSHIP 1 NORTH, RANGE 16 EAST, IN THE VILLAGE OF WALWORTH, WALWORTH COUNTY, WISCONSIN. MORE PARTICULARLY DESCRIBED AS:

LOT 20 OF CLARKES ADDITION TO THE VILLAGE OF WALWORTH AS  
RECORDED IN DOC #C0015059 AS PER THE WALWORTH COUNTY REGISTER  
OF DEEDS.


SURVEY ORDERED BY:

LARRY GUMS  
PROPERTY ADDRESS:

132 WOOD ST.  
WALWORTH COUNTY, WI 53184

SURVEYOR:

PAUL H. VAN HENKELUM, PLS  
CARDINAL ENGINEERING LLC

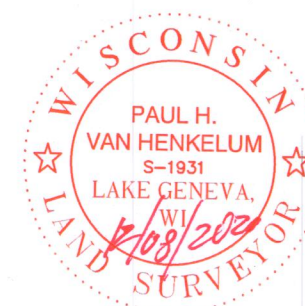

"I HEREBY CERTIFY THAT I HAVE SURVEYED THE ABOVE DESCRIBED PROPERTY AND THE MAP IS A TRUE AND CORRECT REPRESENTATION OF ITS EXTERIOR BOUNDARIES AND SHOWS THE SIZE AND LOCATION OF ALL VISIBLE STRUCTURES, APPARENT EASEMENTS AND ENCROACHMENTS, IF ANY.

PAUL H VAN HENKELUM, PLS #1931

DATE \_\_\_\_\_

RECEIVED  
DEC 21 2020  
By smf



CARDINAL ENGINEERING LLC  
DESIGNING IN TRUE DIRECTIONS

PO BOX 281 - 1200 LA SALLE ST.  
LAKE GENEVA, WI 53147  
262-757-8776  
CARDINALEENGINEERINGWI.COM

DATE: 12/07/20 JOB No.20501  
SHEET 1 OF 1 SKI

VCA-210

009-1335