


PLAT OF SURVEY

OF LOT 12, BLOCK 1, E. W. CRUMB'S ADDITION TO THE
VILLAGE OF WALWORTH, BEING PART OF THE SE 1/4 OF THE
NW 1/4 OF SECTION 22, T. 1 N., R. 16 E., OF THE 4TH P.M.,
VILLAGE OF WALWORTH, WALWORTH COUNTY, WISCONSIN.

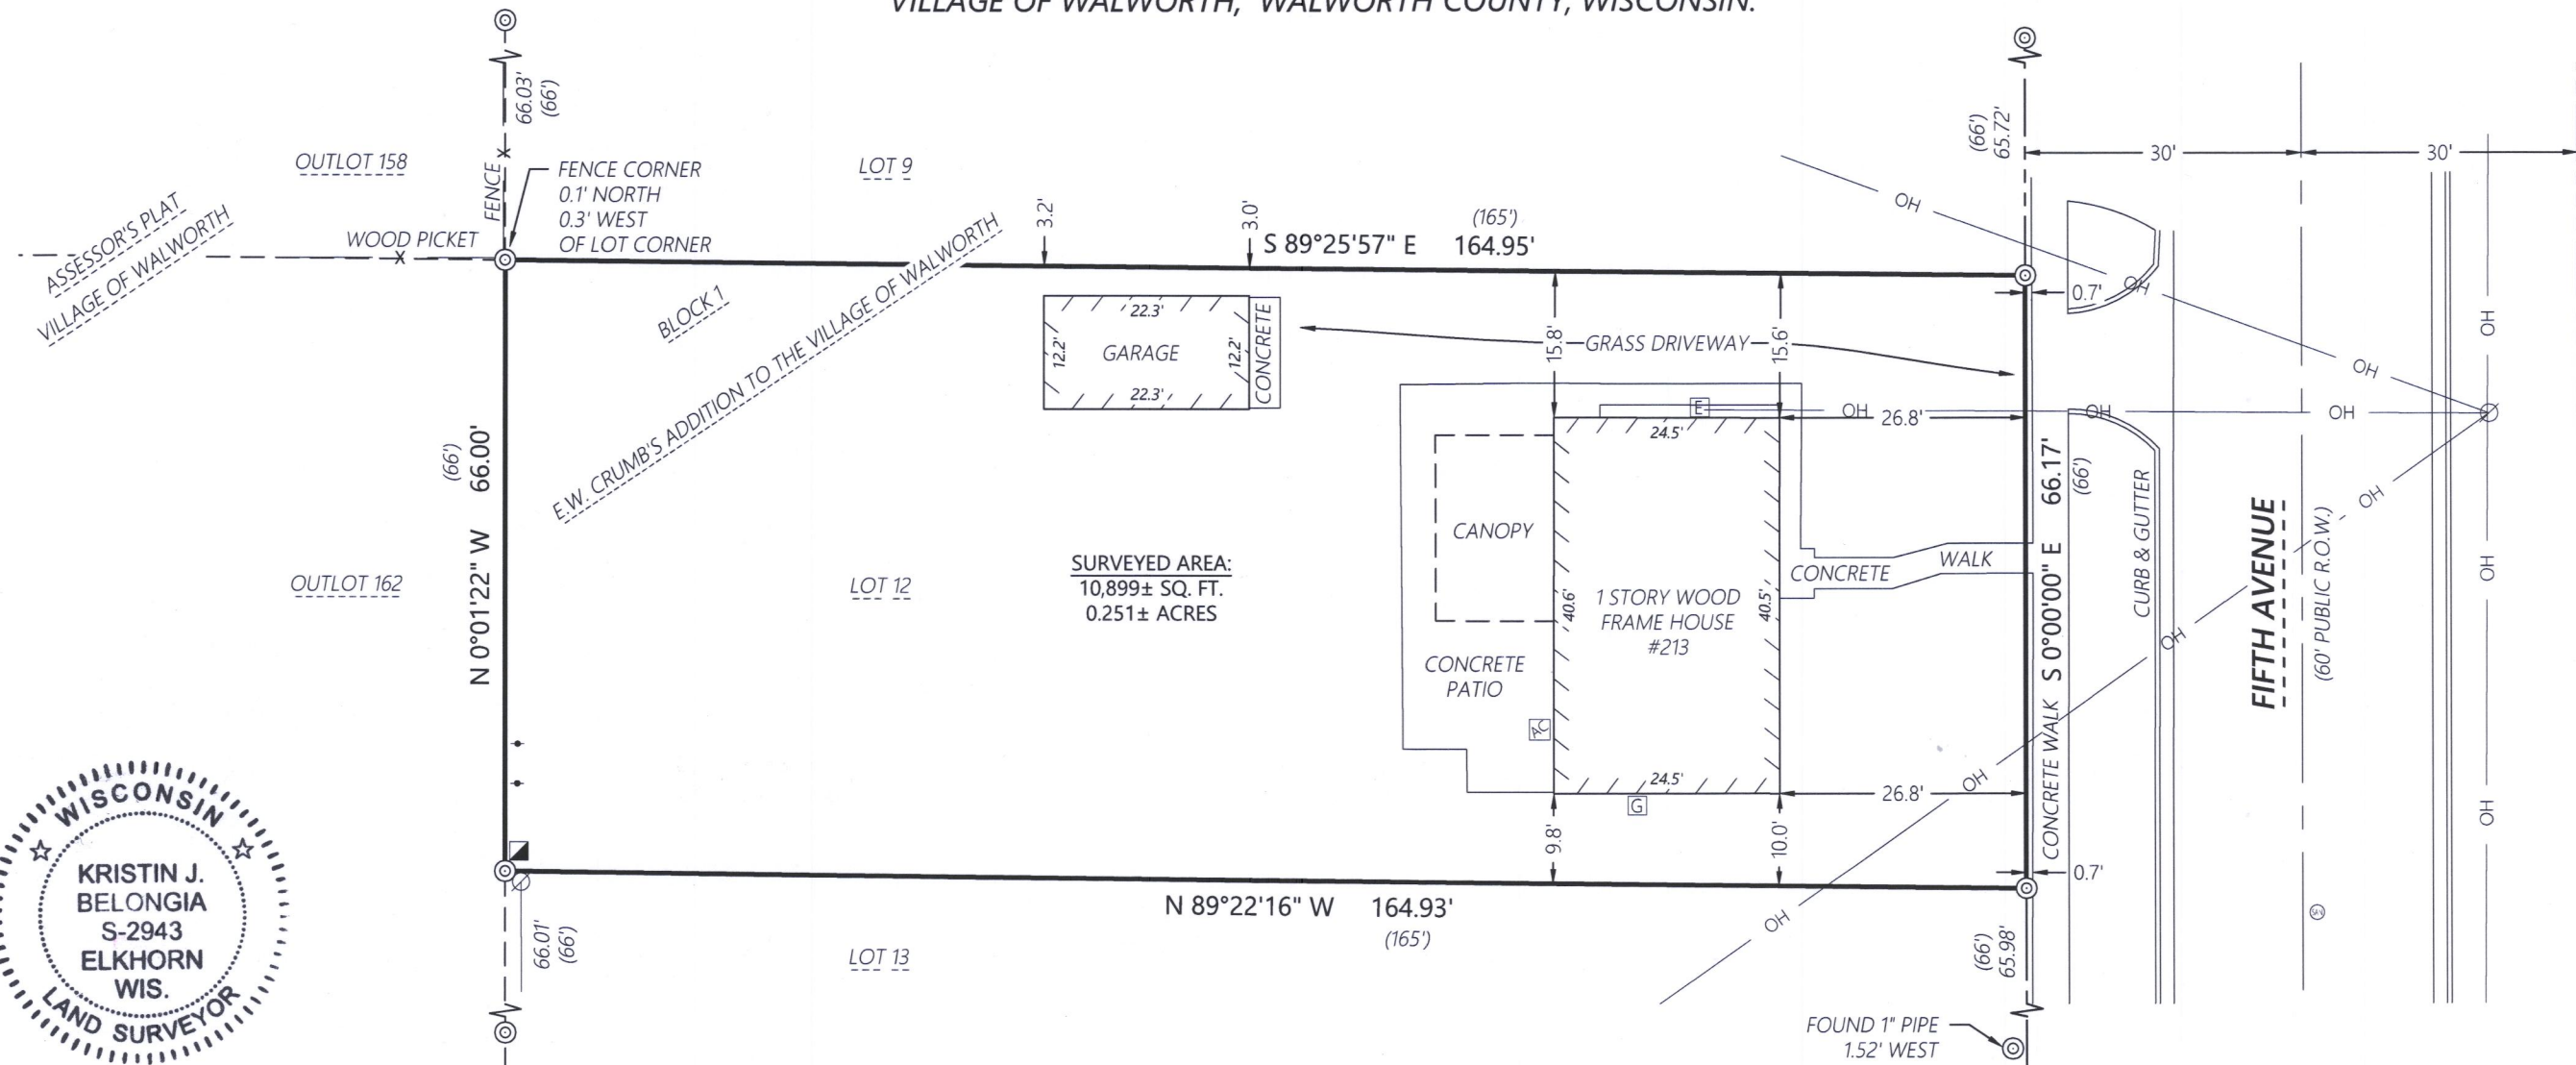

Kristin J Belongia

Kristin J. Belongia, P.L.S.
Wisconsin Professional Land Surveyor S-2943

State of Wisconsin } ss
County of Walworth }

I hereby certify that I have supervised the survey of the property described above and to the best of my knowledge and belief, the plat drawn hereon complies with Chapter A-E 7 of the State of Wisconsin Administrative Code, Minimum Standards for Property Surveys and correctly represents said survey and its location.

Given under my hand and seal this 1st day of December, 2020 at Beloit, Wisconsin.
Last day of field work November 23rd, 2020


If the surveyor's signature is not red in color, the plan is a copy that should be assumed to contain unauthorized alterations. The certification contained on this document shall not apply to any copies.

MONUMENT KEY

⊙ 1" Iron Pipe Found
(XXX.XX) Record Information

LEGEND

- | | |
|----------------------------------|-------------------------------|
| — Existing Boundary Line | ⊗ Existing Utility Pole |
| - - - Existing Right-of-Way | • Existing Guy Wire |
| - - - Existing Adjacent Property | E Existing Electric Meter |
| - - - Existing Centerline | █ Existing Telephone Pedestal |
| X Existing Fence | ⊠ Existing Air Conditioner |
| OH Existing Overhead Power | G Existing Gas Meter |
| | ⊕ Existing Sanitary Manhole |

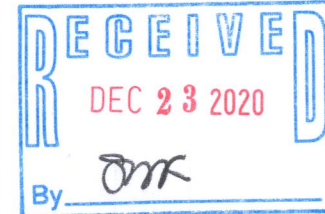

Scale: 1" = 20'
0 10 20 40
DISTANCE UNITS BASED ON THE UNITED STATES SURVEY FOOT

BEARINGS BASED ON THE WEST LINE OF FIFTH AVENUE BEARING S 00°00'00" E



Batterman
engineers surveyors planners
2857 Bartells Drive
Beloit, Wisconsin 53511
608.365.4464
www.rhbatterman.com

PLAT OF SURVEY

FOR THE EXCLUSIVE USE OF:
The Rauland Agency, Inc.
118 Kenosha St.
Walworth, WI 53184

ORDER NO: 33798
FIELD CREW: DJE
DRAWN BY: DJE

File Name: J:\33700-33798\33798 - The Rauland Agency - POS 213 N 5th Ave SURVEY\RH B DRAWING FILES

VECR-8

009-1339