



# PLAT OF SURVEY AND TOPOGRAPHIC MAPPING LOT 18 OF WHITETAIL RIDGE SUBDIVISION

LOCATED IN PART OF THE SE 1/4 OF THE SW 1/4  
OF SECTION 15, TOWN 1 NORTH, RANGE 16 EAST,  
VILLAGE OF WALWORTH, WALWORTH COUNTY, WISCONSIN

GRID NORTH  
WISCONSIN STATE PLANE COORDINATE SYSTEM  
SOUTH ZONE  
W. LINE OF THE SW 1/4 OF  
SECTION 15-16 BEARS  
N 01°12'20" W

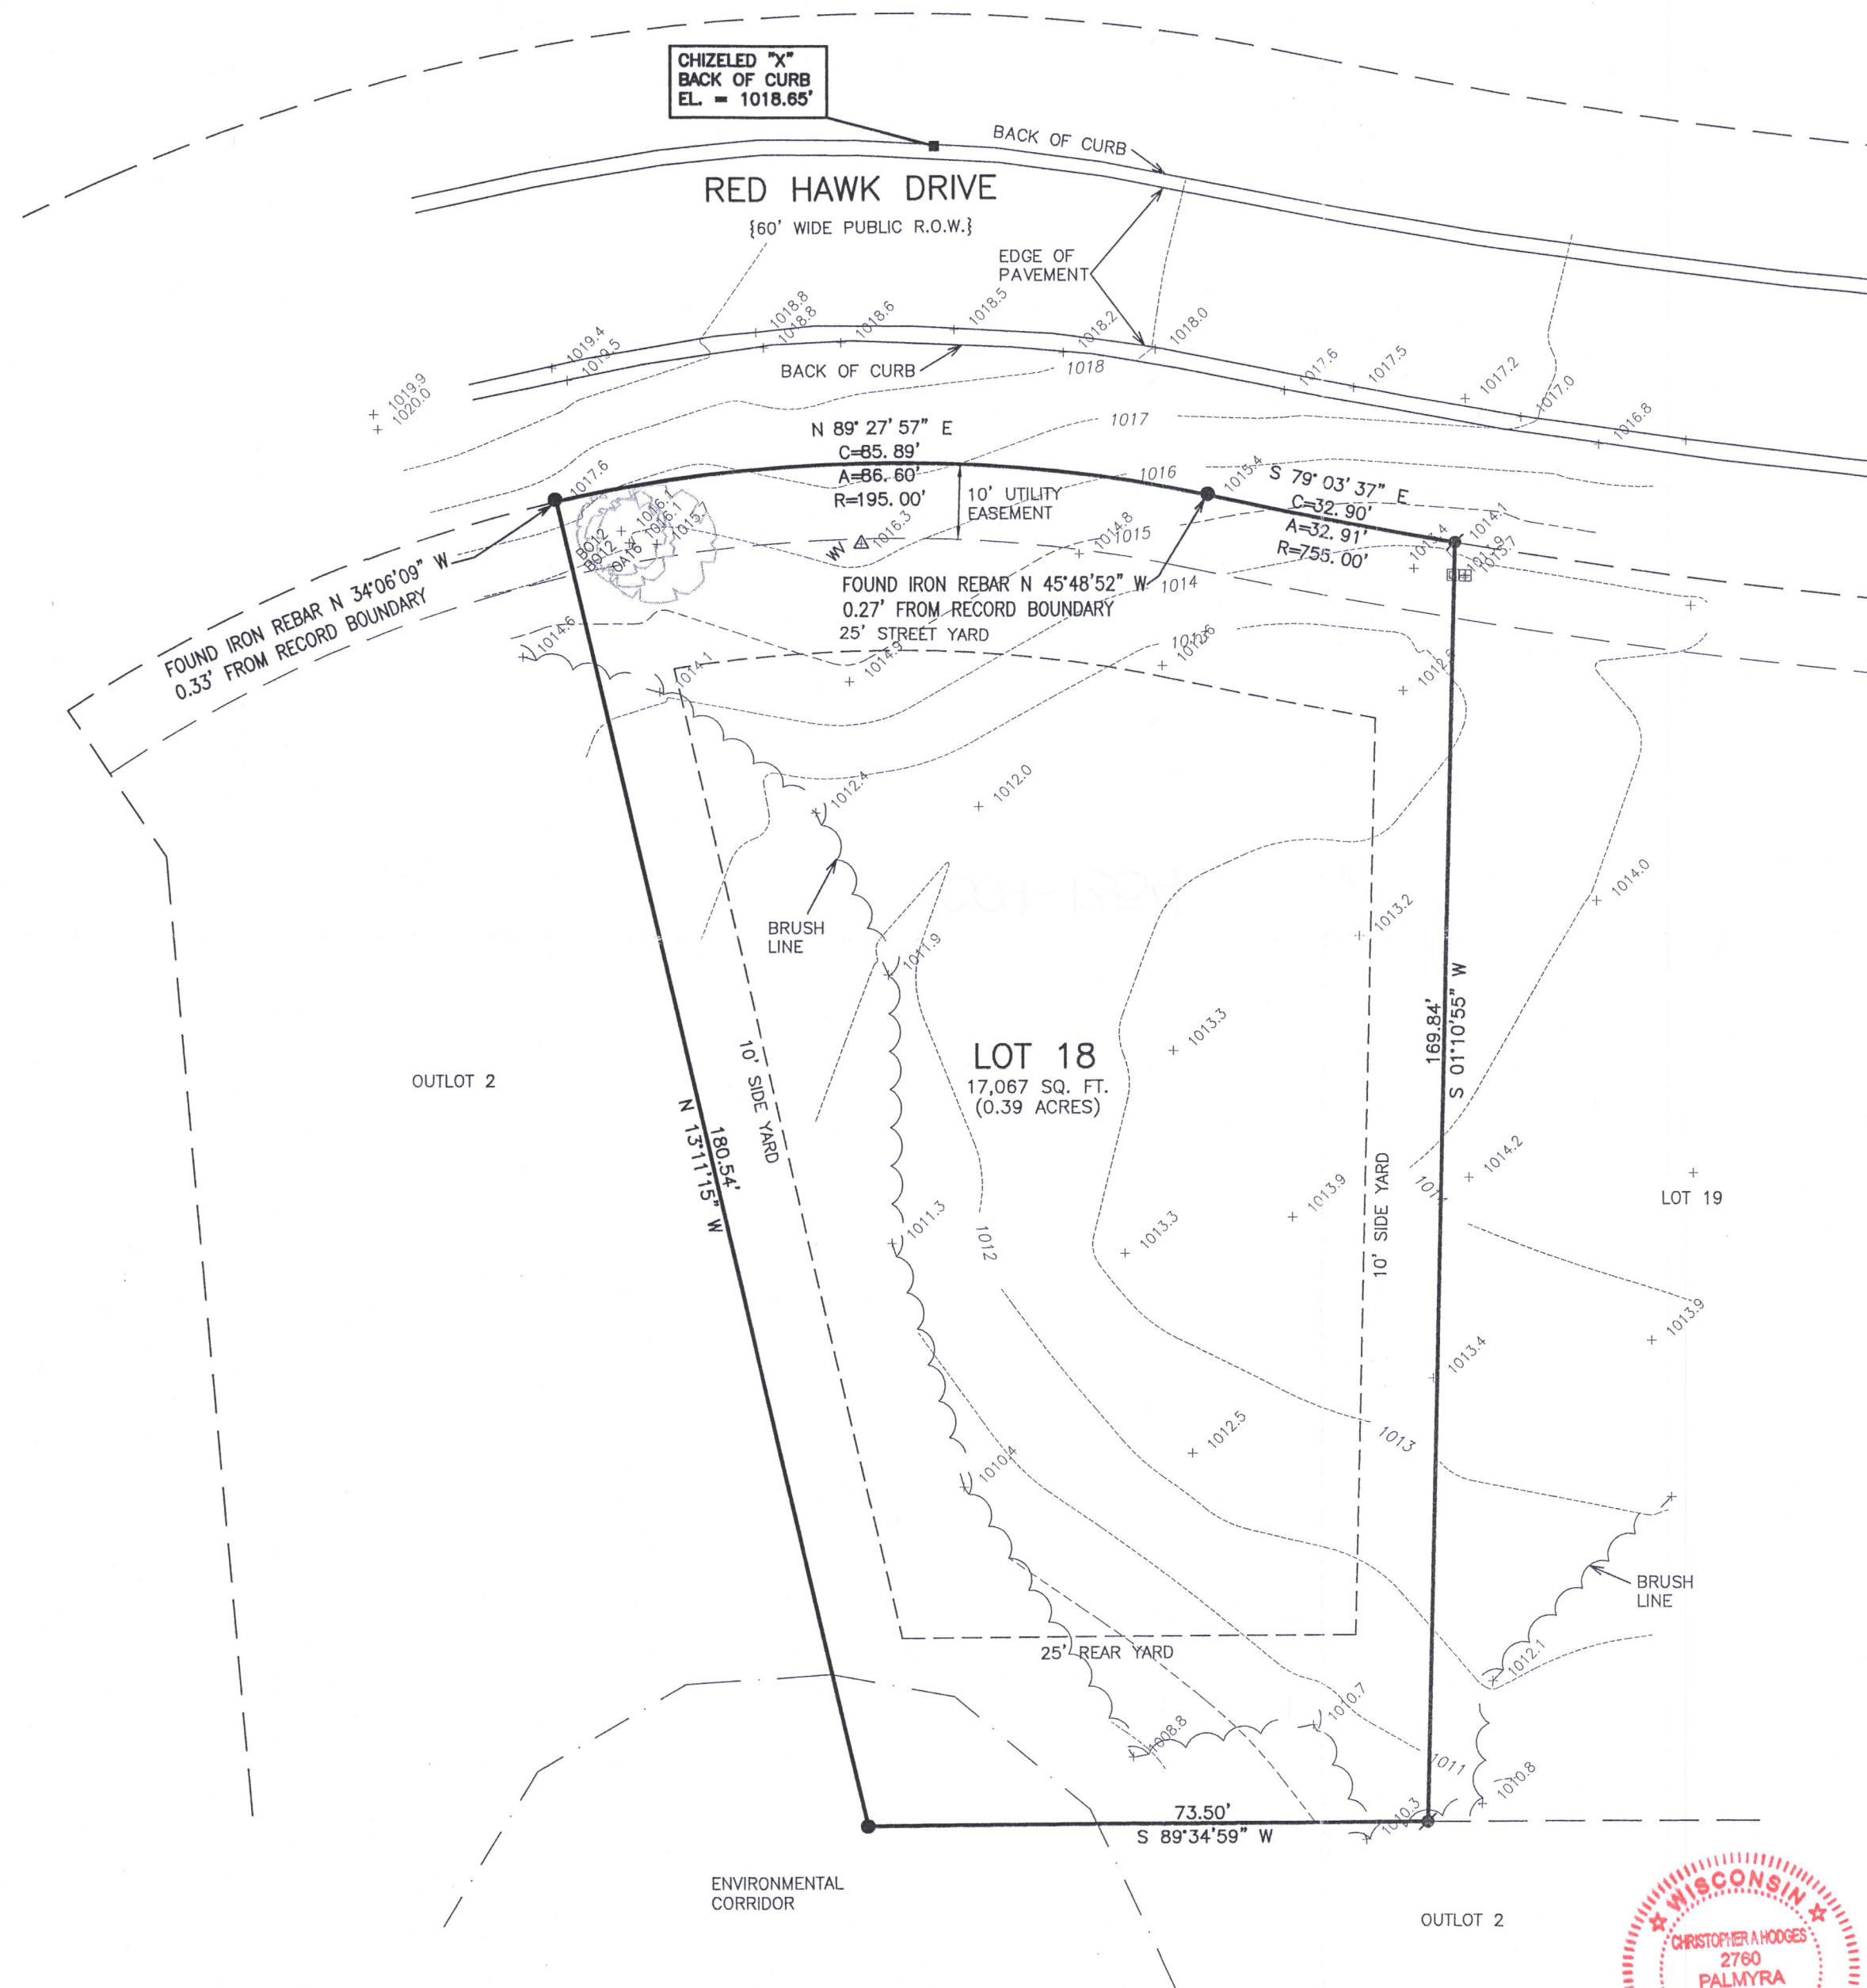

- LEGEND
- = FOUND REBAR STAKE
  - ⦿ = SET REBAR STAKE
  - = CABLE BOX
  - ⊞ = ELECTRIC BOX
  - {XXX} = RECORDED AS
  - + xxxx = EXISTING GROUND ELEVATION
  - XXXX----- = EXISTING LAND CONTOURS

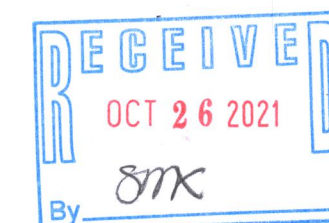


NOTE: COPIES OF THIS MAP TO WHICH THE FOLLOWING CERTIFICATE WILL APPLY SHOW THE SURVEYOR'S ORIGINAL SEAL AND SIGNATURE IN RED INK. COPIES BY ANY OTHER MEANS MAY HAVE ALTERATIONS WHICH DO NOT REPRESENT THE SURVEYOR'S WORK PRODUCT.

I HEREBY CERTIFY THAT THE ABOVE DESCRIBED PROPERTY HAS BEEN SURVEYED UNDER MY DIRECTION AND THAT THE ABOVE MAP IS A TRUE REPRESENTATION THEREOF AND SHOWS THE SIZE AND LOCATION OF THE PROPERTY AND ITS EXTERIOR BOUNDARIES. THIS SURVEY IS MADE FOR THE USE OF THE PRESENT OWNERS OF THE PROPERTY, AND ALSO THOSE WHO PURCHASE, MORTGAGE, OR GUARANTEE THE TITLE THERETO WITHIN ONE YEAR FROM THE DATE HEREOF.

DATED: 10/13/2021

REVISED 10/13/2021 TO UPDATE  
PLAT OF SURVEY PREPARED BY  
BRIAN M. CARLSON DATED  
6/25/2020.

*Christopher A. Hodges*  
CHRISTOPHER A. HODGES P.L.S. 2760

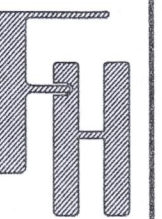

TOPOGRAPHIC SURVEY  
854 RED HAWK DRIVE  
WALWORTH, WI 53184

WORK ORDERED BY -  
STEVEN & MAZIE MIZELLE  
17 SUTTON PT.  
PITTSFORD, NY 14534

FARRIS, HANSEN & ASSOCIATES, INC.  
ENGINEERING - ARCHITECTURE - SURVEYING  
7 RIDGWAY COURT P.O. BOX 437  
ELKHORN, WISCONSIN 53121  
OFFICE: (262) 723-2098 FAX: (262) 723-5886

REVISIONS

PROJECT NO.  
6460.18.21

DATE:  
10/13/2021

SHEET NO.  
1 OF 1

X:\PROJECTS\6460\INDIV\_LOTS\LOT\_18\ACAD\6460-18.DWG

MAP SCALE IN FEET - ORIGINAL 1"=20'

VWR-18

009-1354