


# PLAT OF SURVEY

LOT 27 OF WALWORTH PRAIRIE, A SUBDIVISION  
PART OF THE NE 1/4, NW 1/4, SW 1/4, AND SE 1/4 OF SECTION 21, T. 1 N., R. 16 E.,  
OF THE 4TH P.M., VILLAGE OF WALWORTH, WALWORTH COUNTY, WISCONSIN

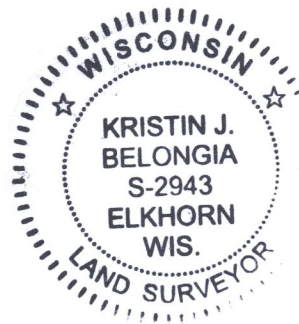

*Kristin J. Belongia*

Kristin J. Belongia, P.L.S.  
Wisconsin Professional Land Surveyor S-2943

State of Wisconsin } ss  
County of Rock }

I hereby certify that I have supervised the survey of the property described above and to the best of my knowledge and belief, the plat drawn hereon complies with Chapter A-E 7 of the State of Wisconsin Administrative Code, Minimum Standards for Property Surveys and correctly represents said survey and its location.


Given under my hand and seal this 15th day of October, 2021 at Beloit, Wisconsin.

Last day of field work October 12th, 2021

If the surveyor's signature is not red in color, the plan is a copy that should be assumed to contain unauthorized alterations. The certification contained on this document shall not apply to any copies.

## LEGEND

- Iron Rebar Set  
3/4" x 24" (1.5 Lbs./Ft.)
- ⊙ 3/4" Iron Rebar Found
- (XXX.XX) Record Information
- Existing Boundary Line
- - - Existing Adjacent Property
- - - Existing Centerline
- Existing Telephone Pedestal
- ⊡ Existing Transformer
- Existing Electric Pedestal
- E Existing Electric Meter
- G Existing Gas Meter
- ⊞ Existing Air Conditioner
- ⊗ Existing Water Valve
- ⊕ Existing Fire Hydrant
- ⊕ Existing Beehive Inlet

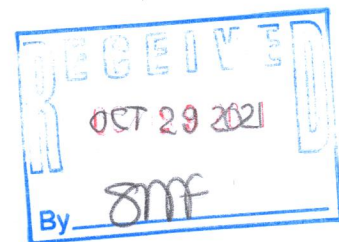


Scale: 1" = 20'



DISTANCE UNITS BASED ON THE UNITED STATES SURVEY FOOT

BEARINGS BASED ON THE RECORD PLAT OF  
WALWORTH PRAIRIE SUBDIVISION

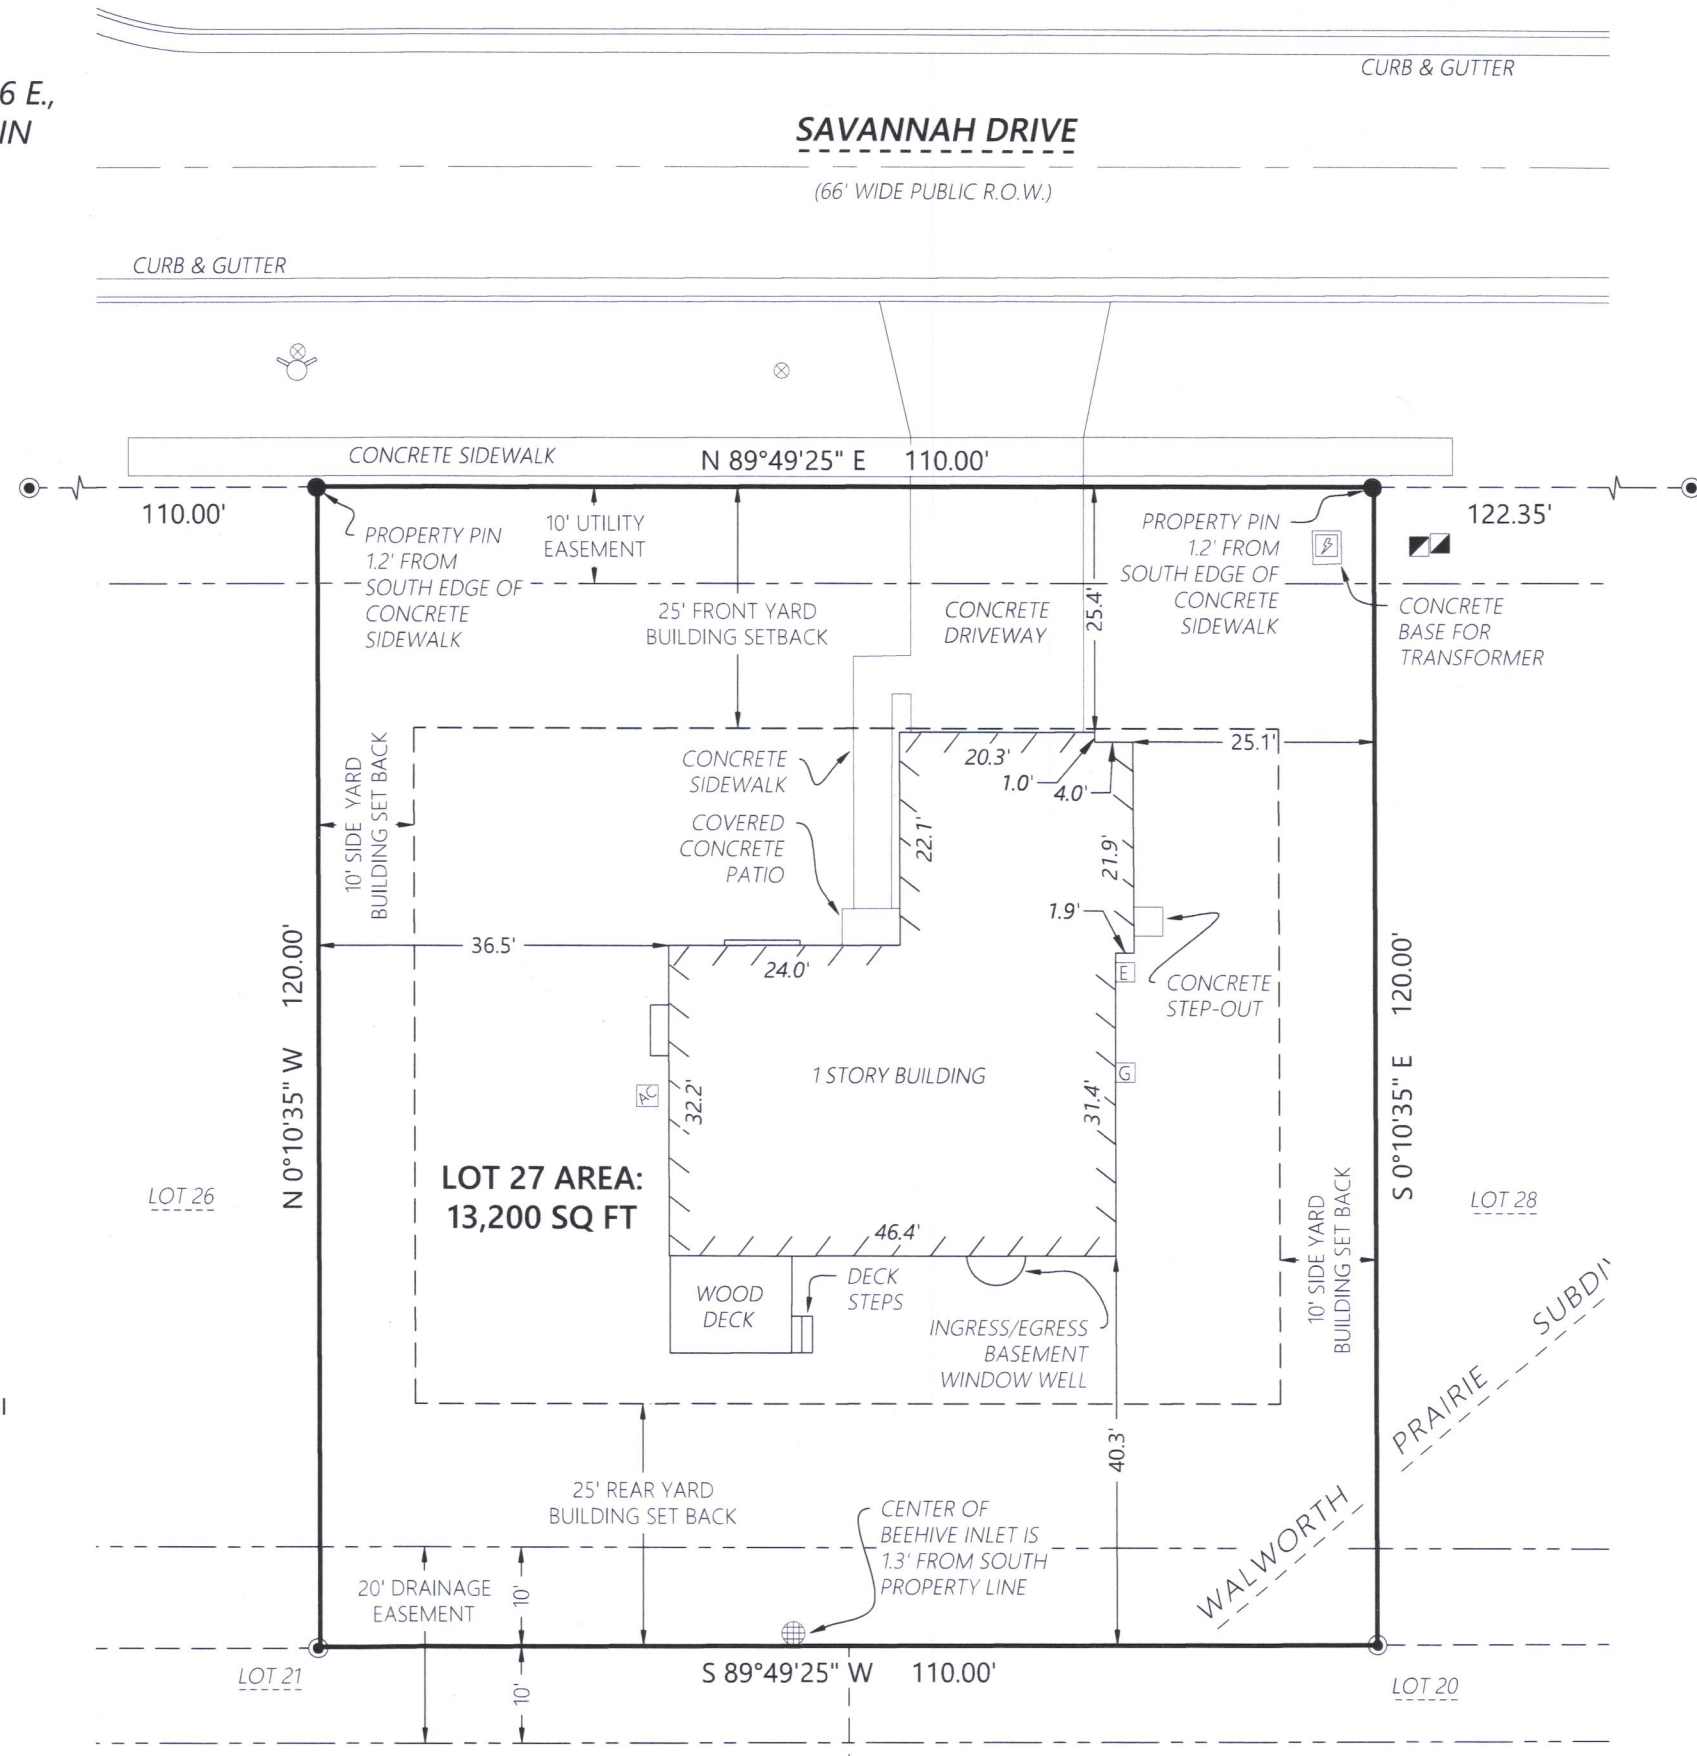

**Batterman**  
engineers surveyors planners  
2857 Barrells Drive  
Beloit, Wisconsin 53511  
608.365.4464  
www.rhbatterman.com

## PLAT OF SURVEY

FOR THE EXCLUSIVE USE OF:  
THE RAULAND AGENCY, INC.  
118 KENOSHA STREET  
WALWORTH, WI 53184

ORDER NO: 33856

FIELD CREW: BMR  
DRAWN BY: BMR

File Name: J:\33800-33856-33856 - Tracy Group\SURVEY\RH B DRAWING FILES

YWA-27

009-1356