


PLAT OF SURVEY

OF

Blk 1

The East 25 feet of Lots 18 & 19 of E. W. Crumbs Addition and the North 82.50 feet of Outlot 192 Assessor's Plat of the Village of Walworth, Walworth County, Wisconsin.

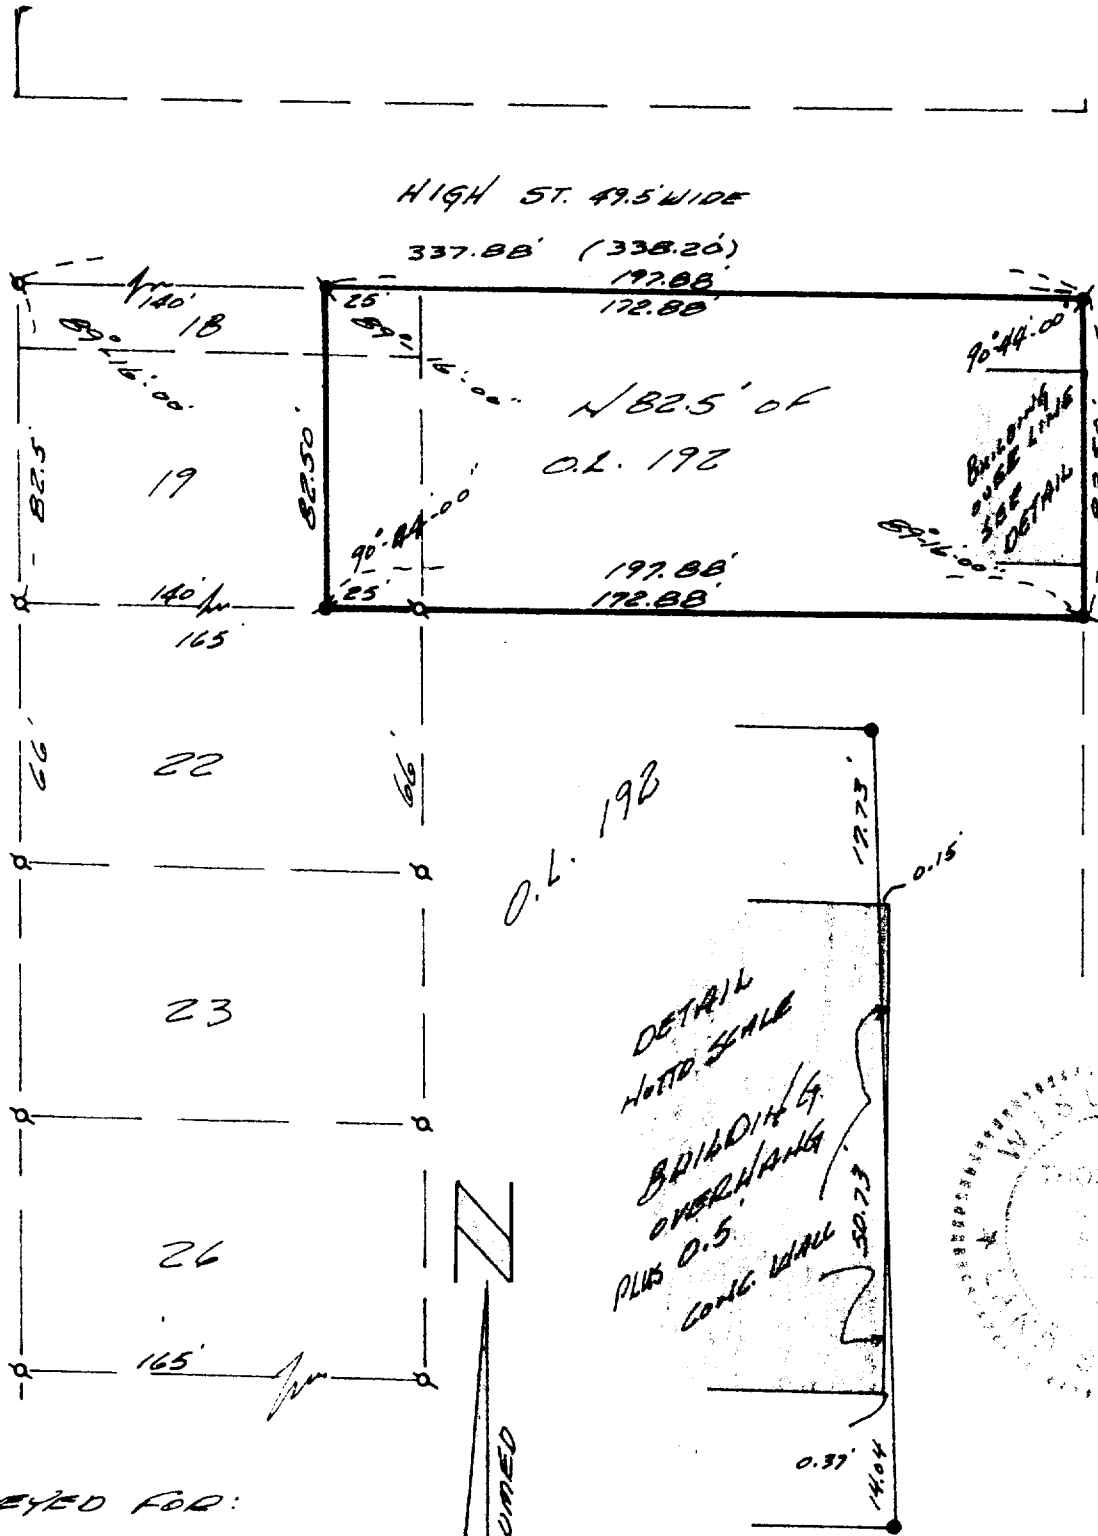

Don't ST. 60' wide

SURVEYED FOR:
AMER. NAT. BANK & TRUST CO.
ROCKFORD, WISCONSIN

SURVEY AND PLAT BY
JENSEN & JOHNSON, INC.
CIVIL ENGINEERS AND SURVEYORS

Elkhorn, Wisconsin

LEGEND

- ⊙ — Iron Pipe FOUND
- — Concrete Monument
- Scale 1" = 50'
- ⊙ ~ 3/4" DIA IRON ROD SET

WE CERTIFY: That we have surveyed the above described property and that the plat shown hereon is an accurate survey and a true representation thereof and correctly shows the exterior boundary lines and all divisions of said property.

Date *Jan 29, 1976* *Thomas P. Jensen*

VEC 12-15 + P + VWP-231

Wisconsin Registered Land Surveyor, No. S-[REDACTED]